


25.7.02
1.8.02
4.9.02



179 deck wks 68' 1/2
will be used for
the 1st 48'
5.77 x 0.25 x 0.065
align

— PROFILE —
S. S. 230'-6" x 36'-0" x 17'-2" D.M.
Scale 1/8" = 1 Foot.

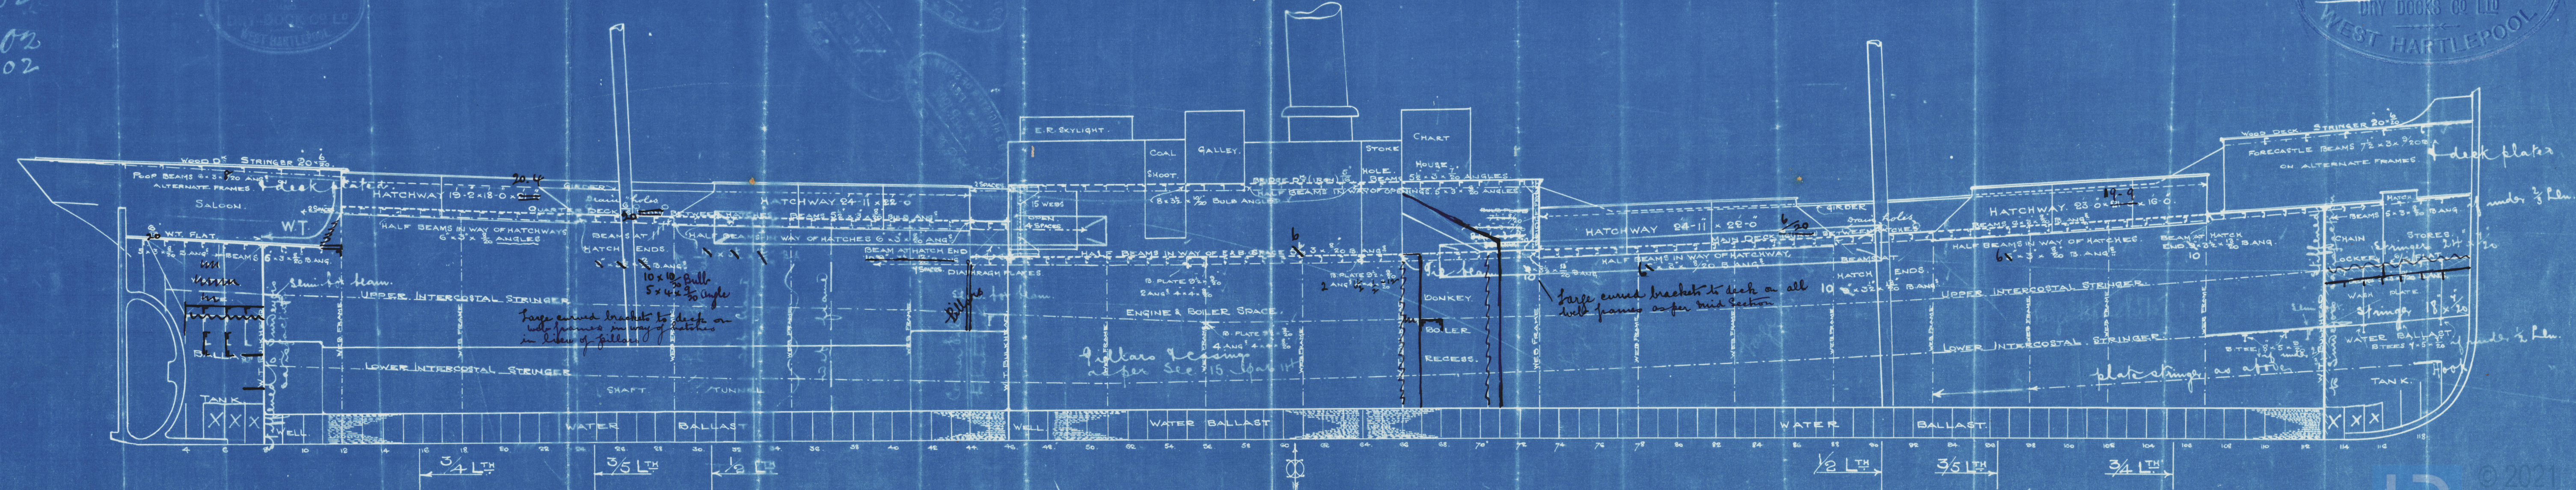

15/11/02

Ivins & B. by Books Co. Ltd

No 128

Profile

"Sirius"

Hpl. Report No. 12064

RETAIN



© 2021

Lloyd's Register
Foundation

W1525-0183