

147.05  
15.11.05 (1361)




# PROFILE & DECK PLAN.

STEEL SCREW TRAWLERS


N<sup>os</sup> 350+5.

127'-0" 21'-11" 12'-4" M<sup>LD</sup> 11'-6" HOLD

SCALE 1/4" = 1 FOOT.

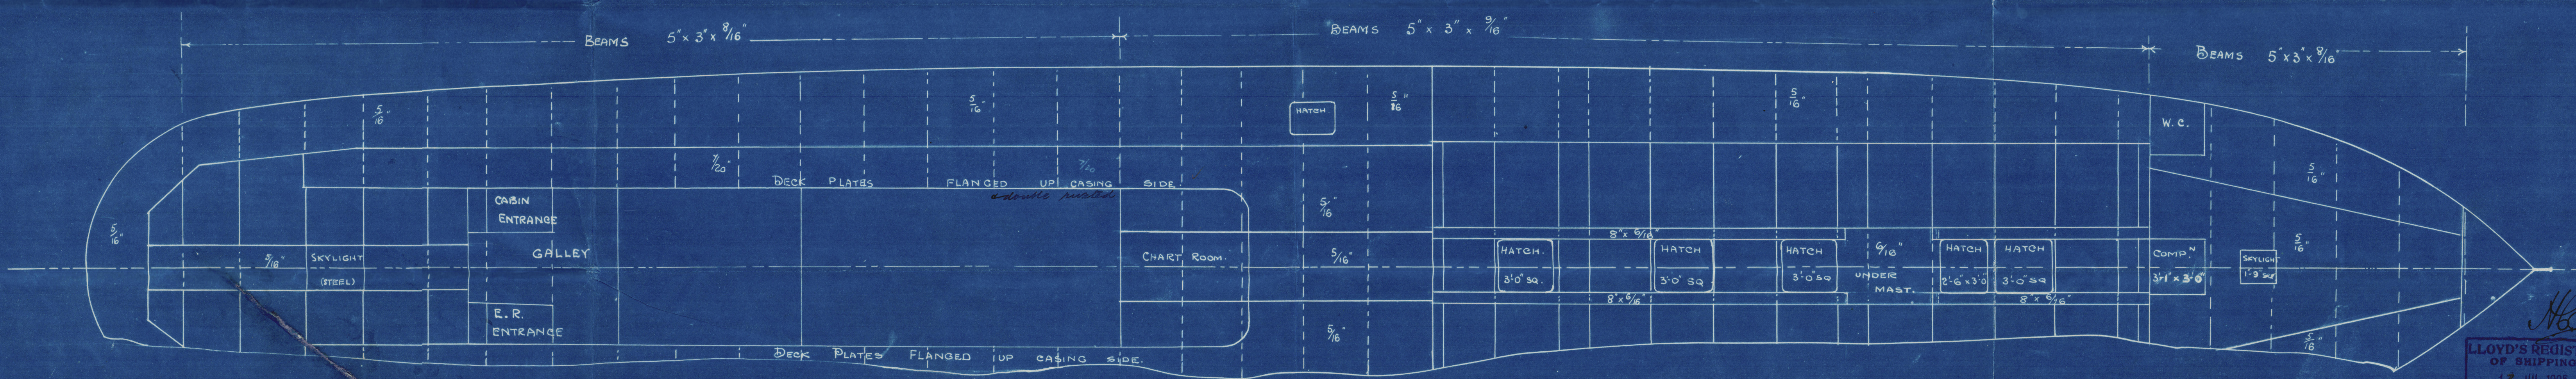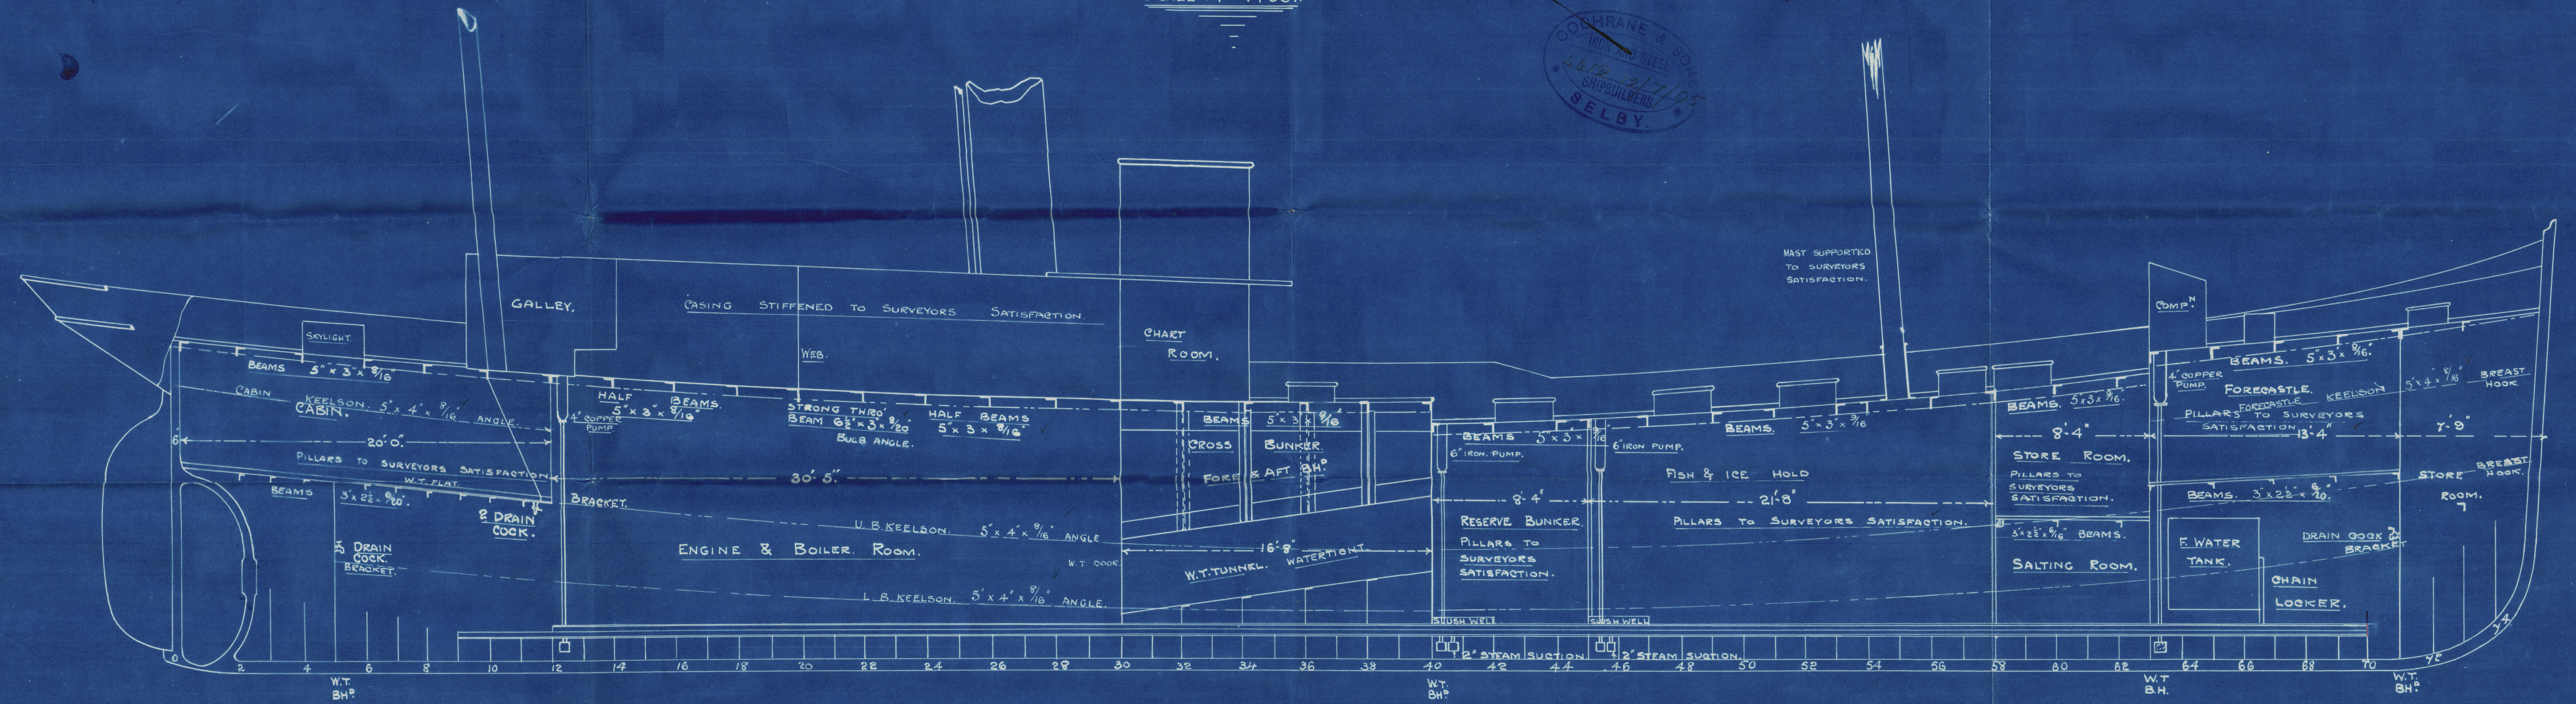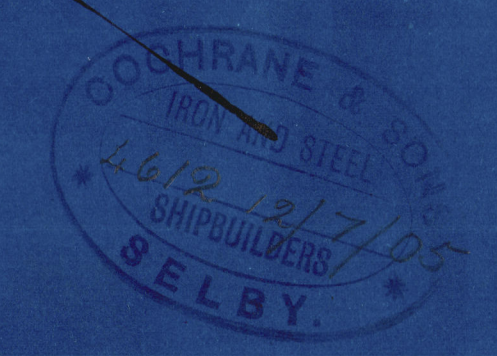

LLOYD'S REGISTER  
OF SHIPPING.  
13 JUL 1905  
+ HULL +

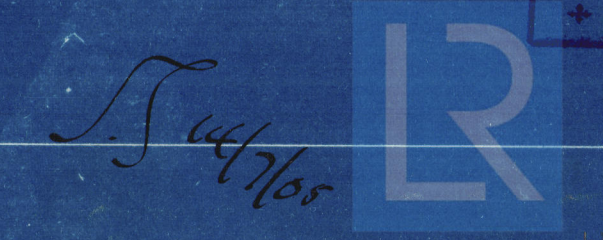




Profile

Messrs Ockrane & Sons

N<sup>o</sup> 350 - 5

361

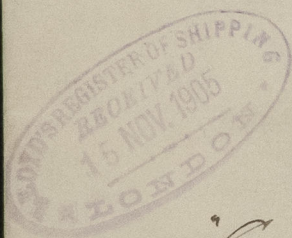

s/s *Empire*  
Hull Report No 17385

s/s Forward Hull Rpt No. 17511  
s/s Umballa - - 17771

RETAIN

Lloyd's Register  
Foundation

W1526-0134