

14.7.05

— S^N 350-5. —

MIDSHIP SECTION

STEEL SCREW TRAWLER

LENGTH 127'0" BREADTH 21'11" DEPTH 12'4" HOLD 11'6"

TO CLASS 100 A.1. STEAM TRAWLER

SCALE 1/2" = 1 FOOT.

NUMERAL AS PER RULES

1/2 BREADTH 10.95 ✓

1/2 GIRTH 19.62 ✓

DEPTH 12.80 ✓

✓ 43.37 = 1ST NO

125.87 RULE LENGTH

✓ 5458.9819 = 2ND NO.

PROPORTIONS.

DEPTH TO LENGTH. = 9.8. ✓

BREADTHS " " = 5.7. ✓

EQUIPMENT.

1ST BOWER 5 1/2" CWTs EX STOCK ✓

2ND BOWER 5 " " " " ✓

3RD BOWER 2 3/4 " " " " ✓

105 FATHS 1 1/16" DIA CABLE ✓

60 " " 6" HAWSER ✓

60 " " 4 1/2" WARP. ✓

RAISED QUARTER DK 72" x 12" RAISED FO'CLE DK 21" x 12"

E & B CASING AS PREVIOUSLY APPROVED

8 5/16" DECK TIES.

DECK PLATED OVER IN WAY OF E & B CASING

DECK 5" x 3" THICK. PITCH PINE.

RAIL 6 1/2" x 3" x 8/20" BULB ANGLE. 3" x 1" SOLID BEAD.

BULWARKS 5/16" x 6/16" IN WAY OF GALLOWS

1 5/8" ROUND STAY. SINGLE RIV. LAP.

3" x 3" x 6/16" STRINGER ANGLE. STRINGER PLATE 50" x 5/16" TO 30" x 5/16"

SHEER STRAKE 3 1/8" x 1/16" TO 7/16" BUTTS STRAPPED & DOUBLE RIV. STRAPS 1/20" THICKER FOR 1/2 LENGTH.

54" x 7/16" FOR 30 FT TO 6" BUTTS LAPPED & DOUBLE RIV.

BEAMS 5" x 3" x 9/16" ANGLE ON ALT FRAMES

FRAMES 3" x 2 1/2" x 5/16" SPACED 20" APART.

REV. FRAMES 2 1/2" x 2 1/2" x 5/20" TO DECK & UPPER BILGE KEELSON.

ALT. IN WAY OF HOLD & DOUBLE IN E & B. SPACE

AS PER LLOYD'S RULES.

FLOORS 10" x 6/16" 7/16" IN WAY OF E & B. SPACE.

KEEL 7 1/2" x 1 1/8" STEM 7 1/2" x 1 1/8"

STERN POST 6" x 3" RUDDER HEAD 4 1/2" HEEL 3 1/2" x 3"

CEILING 2" PINE

PILLARS 2 1/2" DIA.

6" x 3 1/8" T IRON STANCHIONS KEELSON'S 5" x 4" x 1/16" SINGLE ANGLE IN CROSS BUNKERS.

CENTRE KEELSON BULB 7 1/2" x 7/16"

" ANGLES 4" x 3" x 7/16"

2 RIVETS.

54" x 7/16" FOR 2 1/2" L TO 6" BUTTS LAPPED & DOUBLE RIV.

DOUBLE RIV. LAP.

54" x 7/16" FOR 30' 0" TO 7/16" BUTTS LAPPED & DOUBLE RIV.

DOUBLE RIV. LAP.



CARBOARD 32" x 8/16" FOR 2 1/2" L TO 2" BUTTS STRAPPED & DOUBLE RIV. HEEL PIECES 3' 0" LONG.

DOUBLE RIV. LAP.

BUTTS LAPPED & DOUBLE RIV.

BILGE KEEL 6" x 3" x 8/20" BULB ANGLE FOR 40 FT.


DOUBLE RIV. LAP

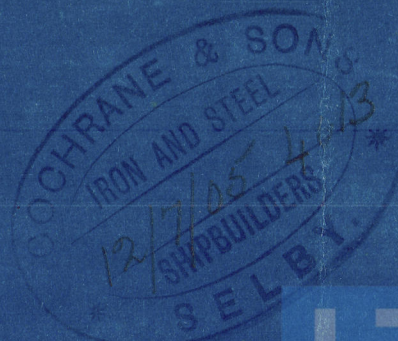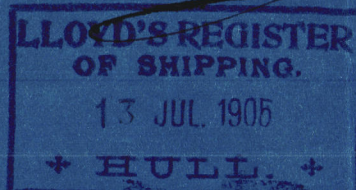

Middle Section

Messrs Cochrane & Sons

N^{os} 350 - 54361

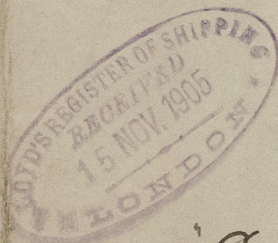

of 'Emperor'

Hull Report No. 17385

of 'Forward'

Hull Report No. 17511

DET



© 2020

Lloyd's Register
Foundation

W1526-0136