

6-1-06

PROPOSED ARRANGEMENT OF

SIDE FRAMES & BRACKETS PLATES.


S. S. N° 60.

For the use of the

Aug. 21. 1906

Wm. Lloyd Garrison


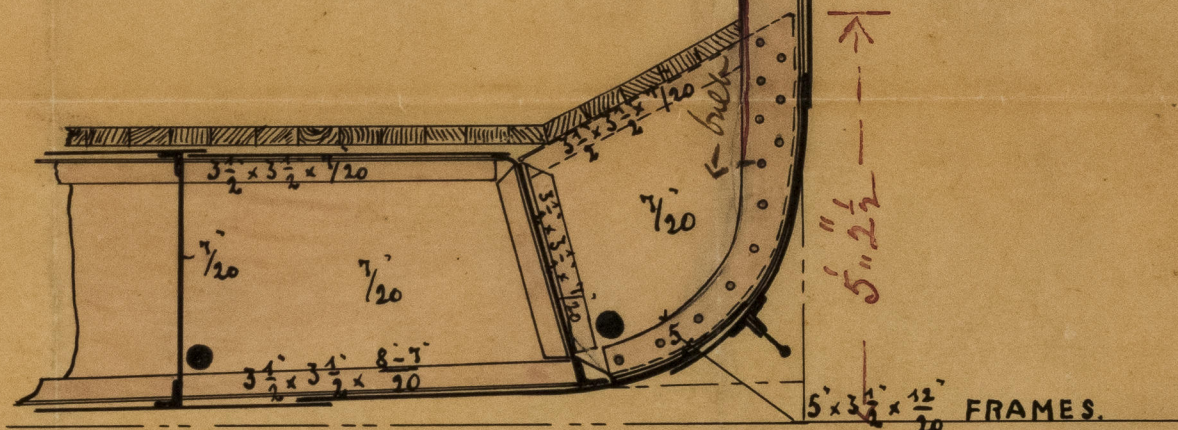

SCALE $\frac{1}{2} = 1$ FOOT.



© 2020
M.



Lloyd's Register
Foundation

6-1-05

PROPOSED ARRANGEMENT OF
SIDE FRAMES & BRACKETS PLATES.
S.S. No 60.

Wm. F. Lloyd
Proprietor


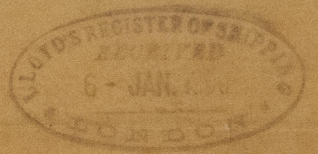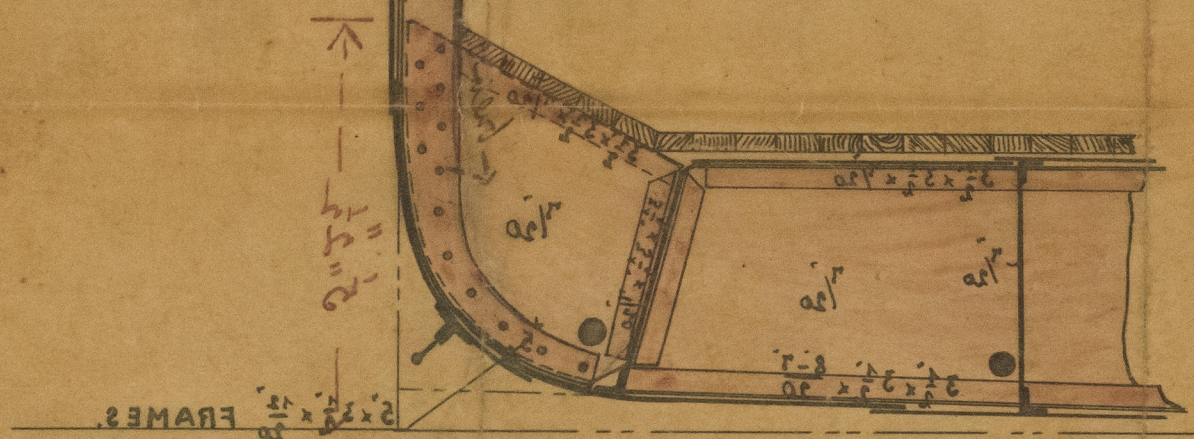

M.

W.F. Lloyd

W.F. Lloyd

SCALE 1/2" = 1 FOOT.



© 2020

Lloyd's Register
Foundation