


Amended Arrangement of Bottom Longitudinal Stay

Boiler No. 305


Scale 1 to 1 inch.

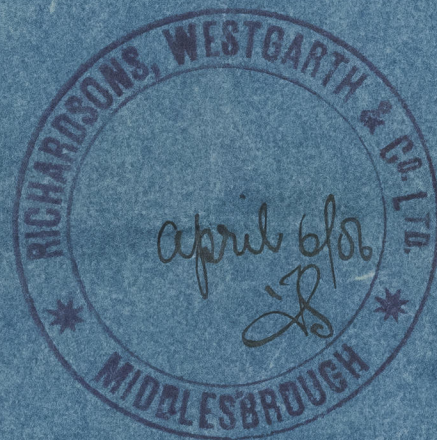

Stays in Chamber Backs

- 2 Nos. Steel Stays, 2'-9 3/4" Eff. Area, fitted at both ends.
- 1/8 -- -- -- 2'-4 1/2 -- -- --
- ⊗ 1/8 -- Iron Stays 2'-4 1/2 -- -- -- in Chambers only.
- 1/4 -- -- -- 2'-0 9/16 -- -- --
- 2 1/8 -- Steel Stays 3'-1 1/2 -- -- -- at Both Ends



Lloyd's Register
Foundation

10.10.06.
9-11

Thos Lloyd

W1529-0/16



© 2020

Lloyd's Register
Foundation