


SALE \hat{P} = 1.0

FEVIG 4th NBR. 1905, COPY N^o 1608

SHEER AT STEM	8-6
" " STERNPOST	3-9
" " $\frac{1}{2}$ LENGTH FROM STEM	4-6
" " $\frac{1}{2}$ STERNPOST	1-11
DROP IN SHEER ABOARD AMIDSHIP	0
ROUND OF BEAM	10 1/2
COEFFICIENT OF FINENESS	0.81
TONNAGE UNDER DECK	CR. 1750
GROSS TONNAGE	2130

PROPOSED FREEBOARD ~~2.9~~
See report

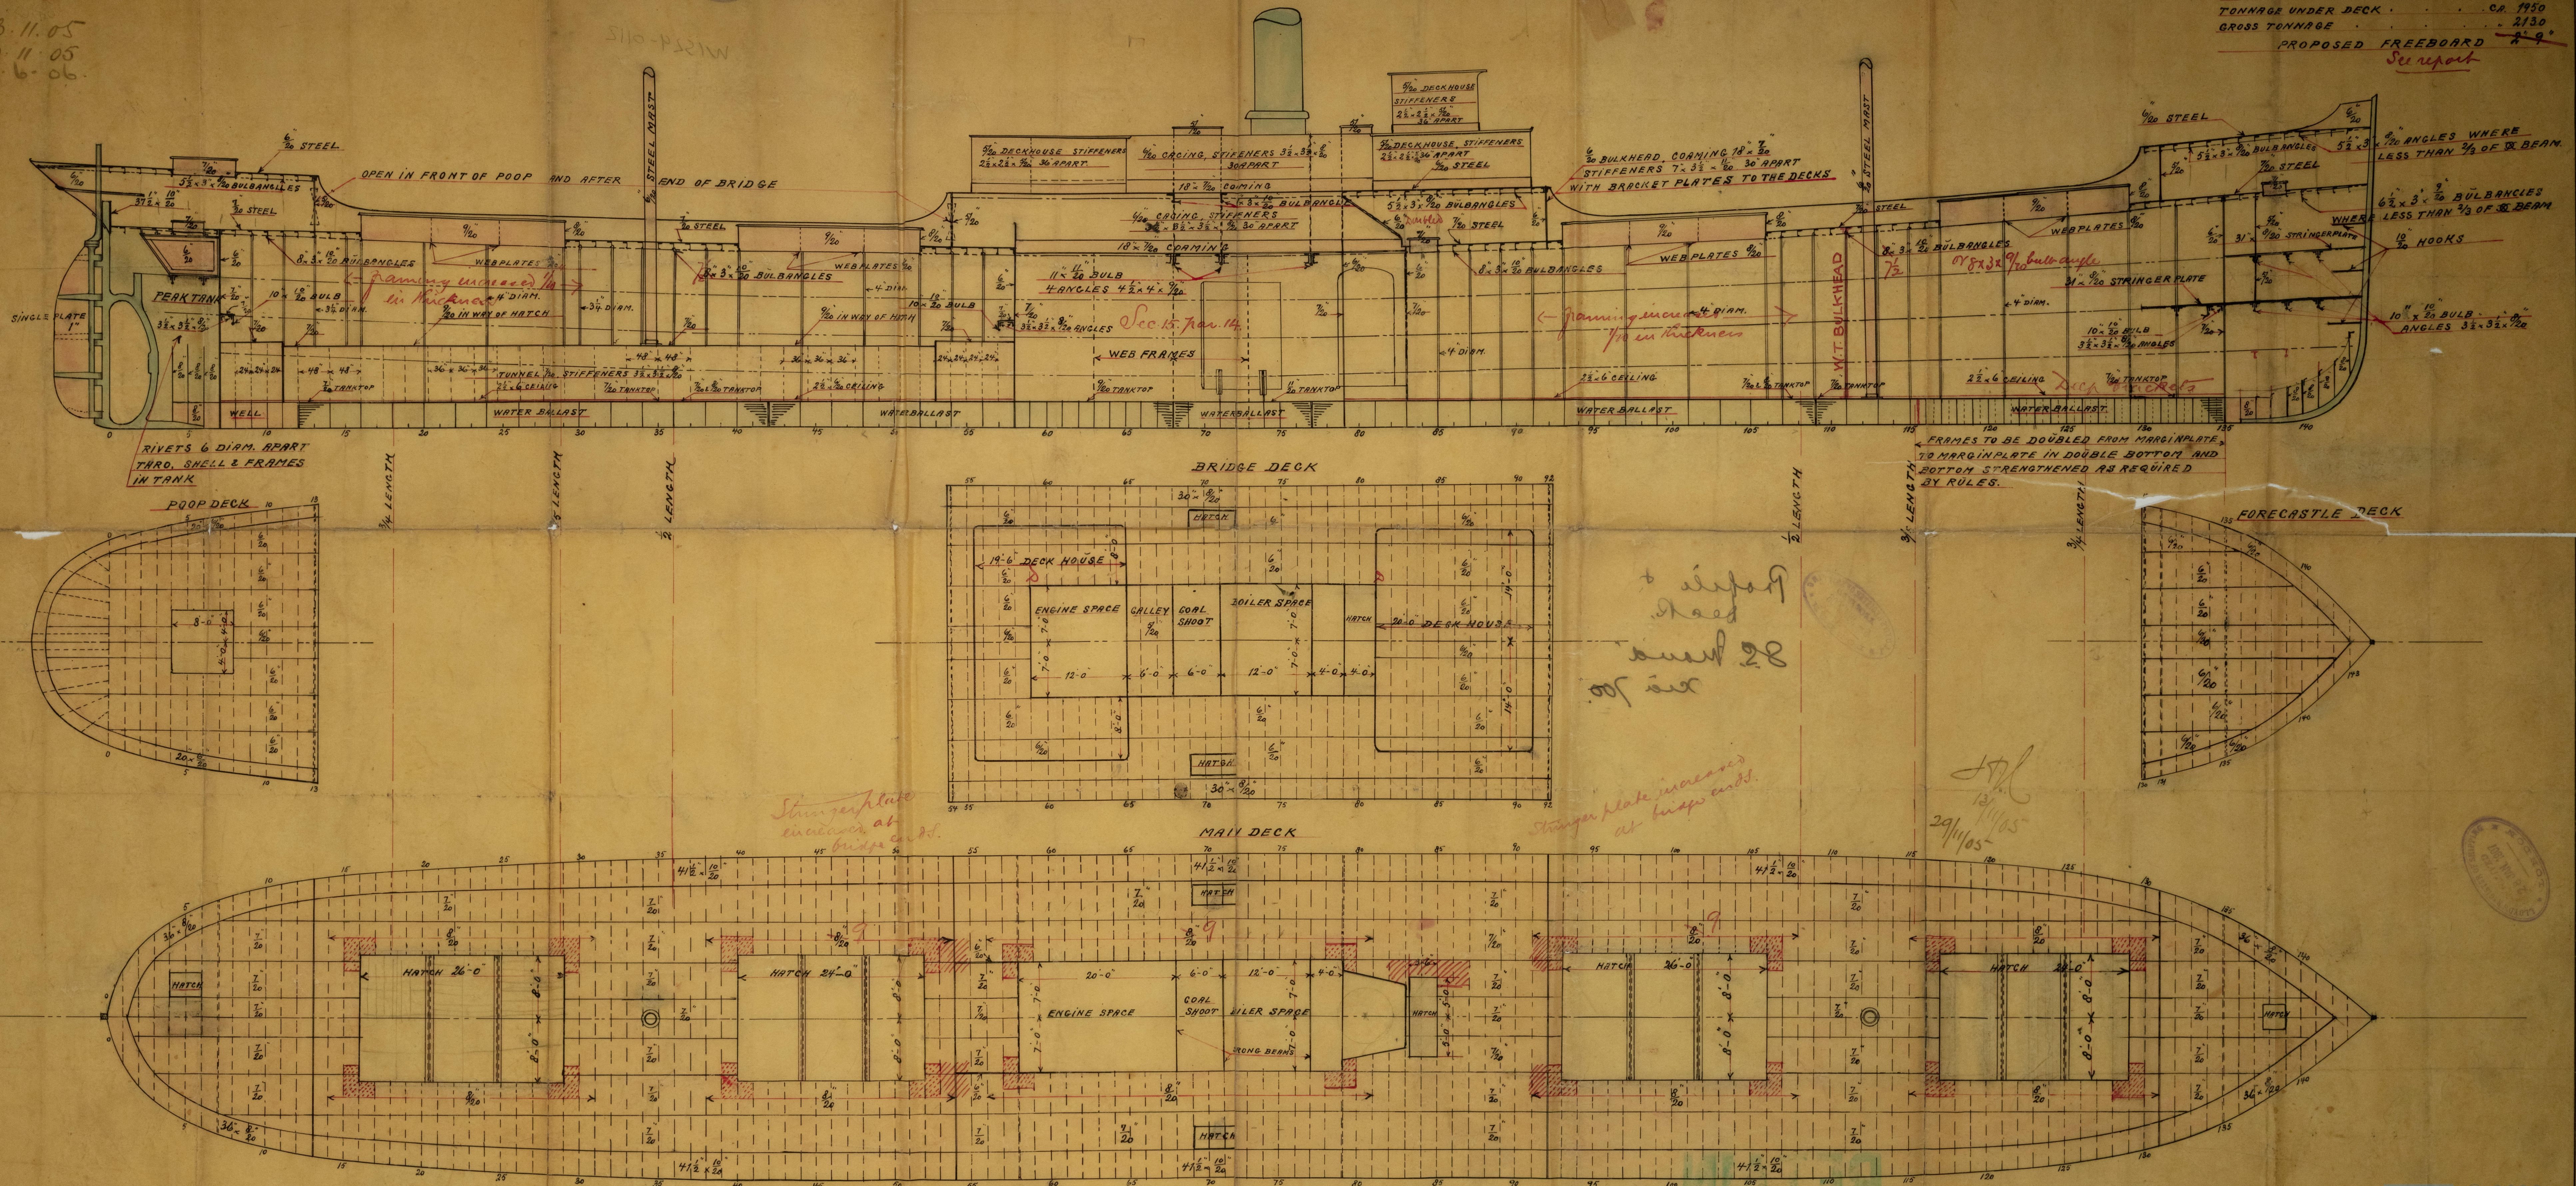

13. 11. 05
30. 11. 05
6. 6. 06

82 Anna
the 700

Stringer plate
increased at
11.5 cm d.t.

Stringer plate increased
at bridge ends.

J. H. L.
 13
 29/11/05
 1/11/05

© 2020
Lloyd's Register
Foundation
W1529-0112

xiā 700.

Lloyd's Register
Foundation