

26.6.15
11.5.16
8-6-16

EQUIPMENT NUMBER.	
HULL	31590.
ANNING DECK	396' x 8' x 75
FCLP	30' x 8' x 75
SALON HOUSE	36-1' x 7-5' x 5
CASING	70-1' x 7-5' x 5
EQUIPMENT NUMBER.	34635.

EQUIPMENT.	
2 POWER ANCHORS	60 CMTS. EACH. STOCKLESS.
1. " "	50 1/2 " STOCKLESS.
1. STREAM ANCHOR	16 1/2 " BK. STOCK.
1. KEDGE	7 " "
270 FATHOMS	2 1/2" STUD CHAIN CABLE.
90	1 1/2" STREAM CHAIN OR 4 1/2" STEEL WIRE.
120	1 1/2" HEMP TOWLINE OR 4 1/2" STEEL WIRE.
90	8 " MANILA OR 2 1/2" STEEL WIRE.
90	5 " " 2 1/2 " " " WITH OWNERS CONSENT.
90	7 " " 2 1/2 " " " TO STEEL WIRE.
90	7 " " 2 1/2 " " " "

FORECASTLE SIDES - 40" BUTTS LAPPED & DOUBLE RIVETED.
• STRINGER ANGLE 3 1/2" x 3 1/2" x 3/4".
• INTERMED. BAR. 5" x 3 1/2" x 3/4".
• STRINGER PLATE 3/4" BUTTS LAPPED & DOUBLE RIVETED.
• DECK STEEL - 20" LONG. BUTTS LAPPED & SINGLE RIVETED.
• BEAMS 6 1/2" x 3 1/2" x 3/4" ON 12" SPACES. CASES 20" x 4" x 1/2".
• UNDER 7 1/2" 8 1/2" x 3 1/2" x 3/4" B.A. 2 ROW.
• " " 7 1/2" 8 1/2" x 3 1/2" x 3/4" B.A. 1 ROW.


MIDSHIP SECTION. S.S. N^os 289-90.

LENGTH B.P. 390'-0". BREADTH M^d 53'-0". DEPTH M^d 27'-10" 36'-0".


TO CLASS 100 A.I. AT LLOYDS.

VESSELS TO CARRY CHILLED MEAT HUNG FROM BEAMS.

SCALE 1/4" = 1' 0".

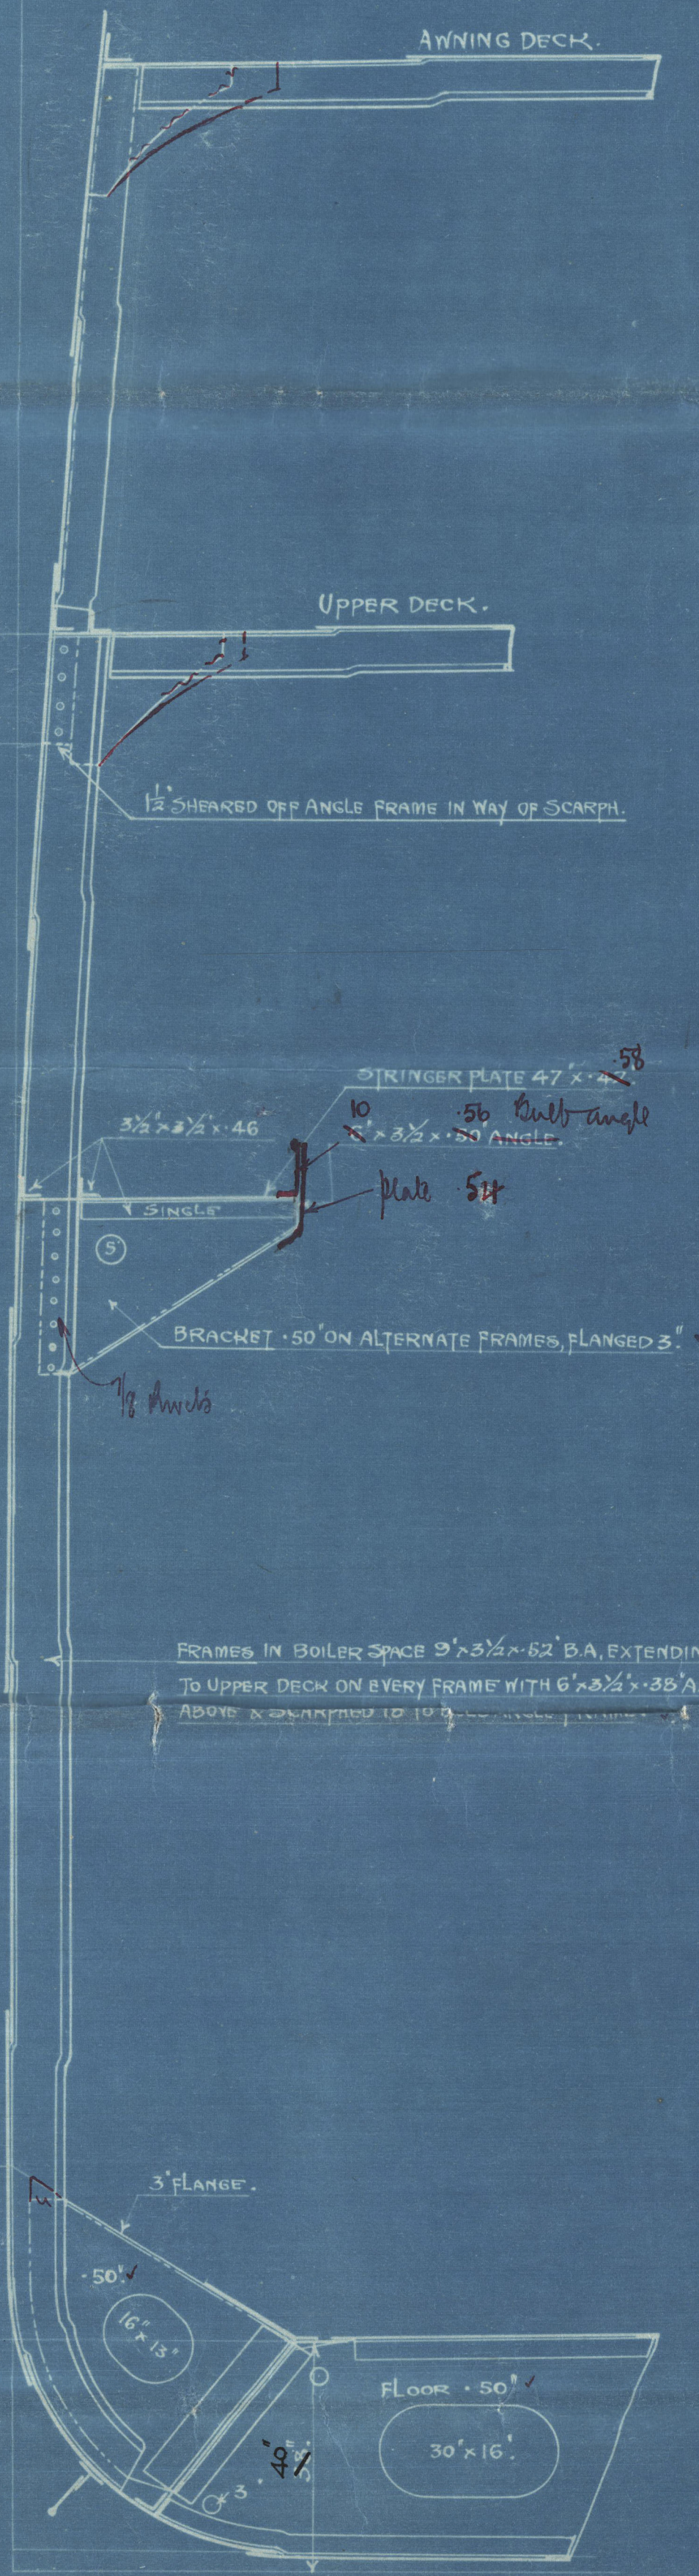


SECTION IN BOILER SPACE.

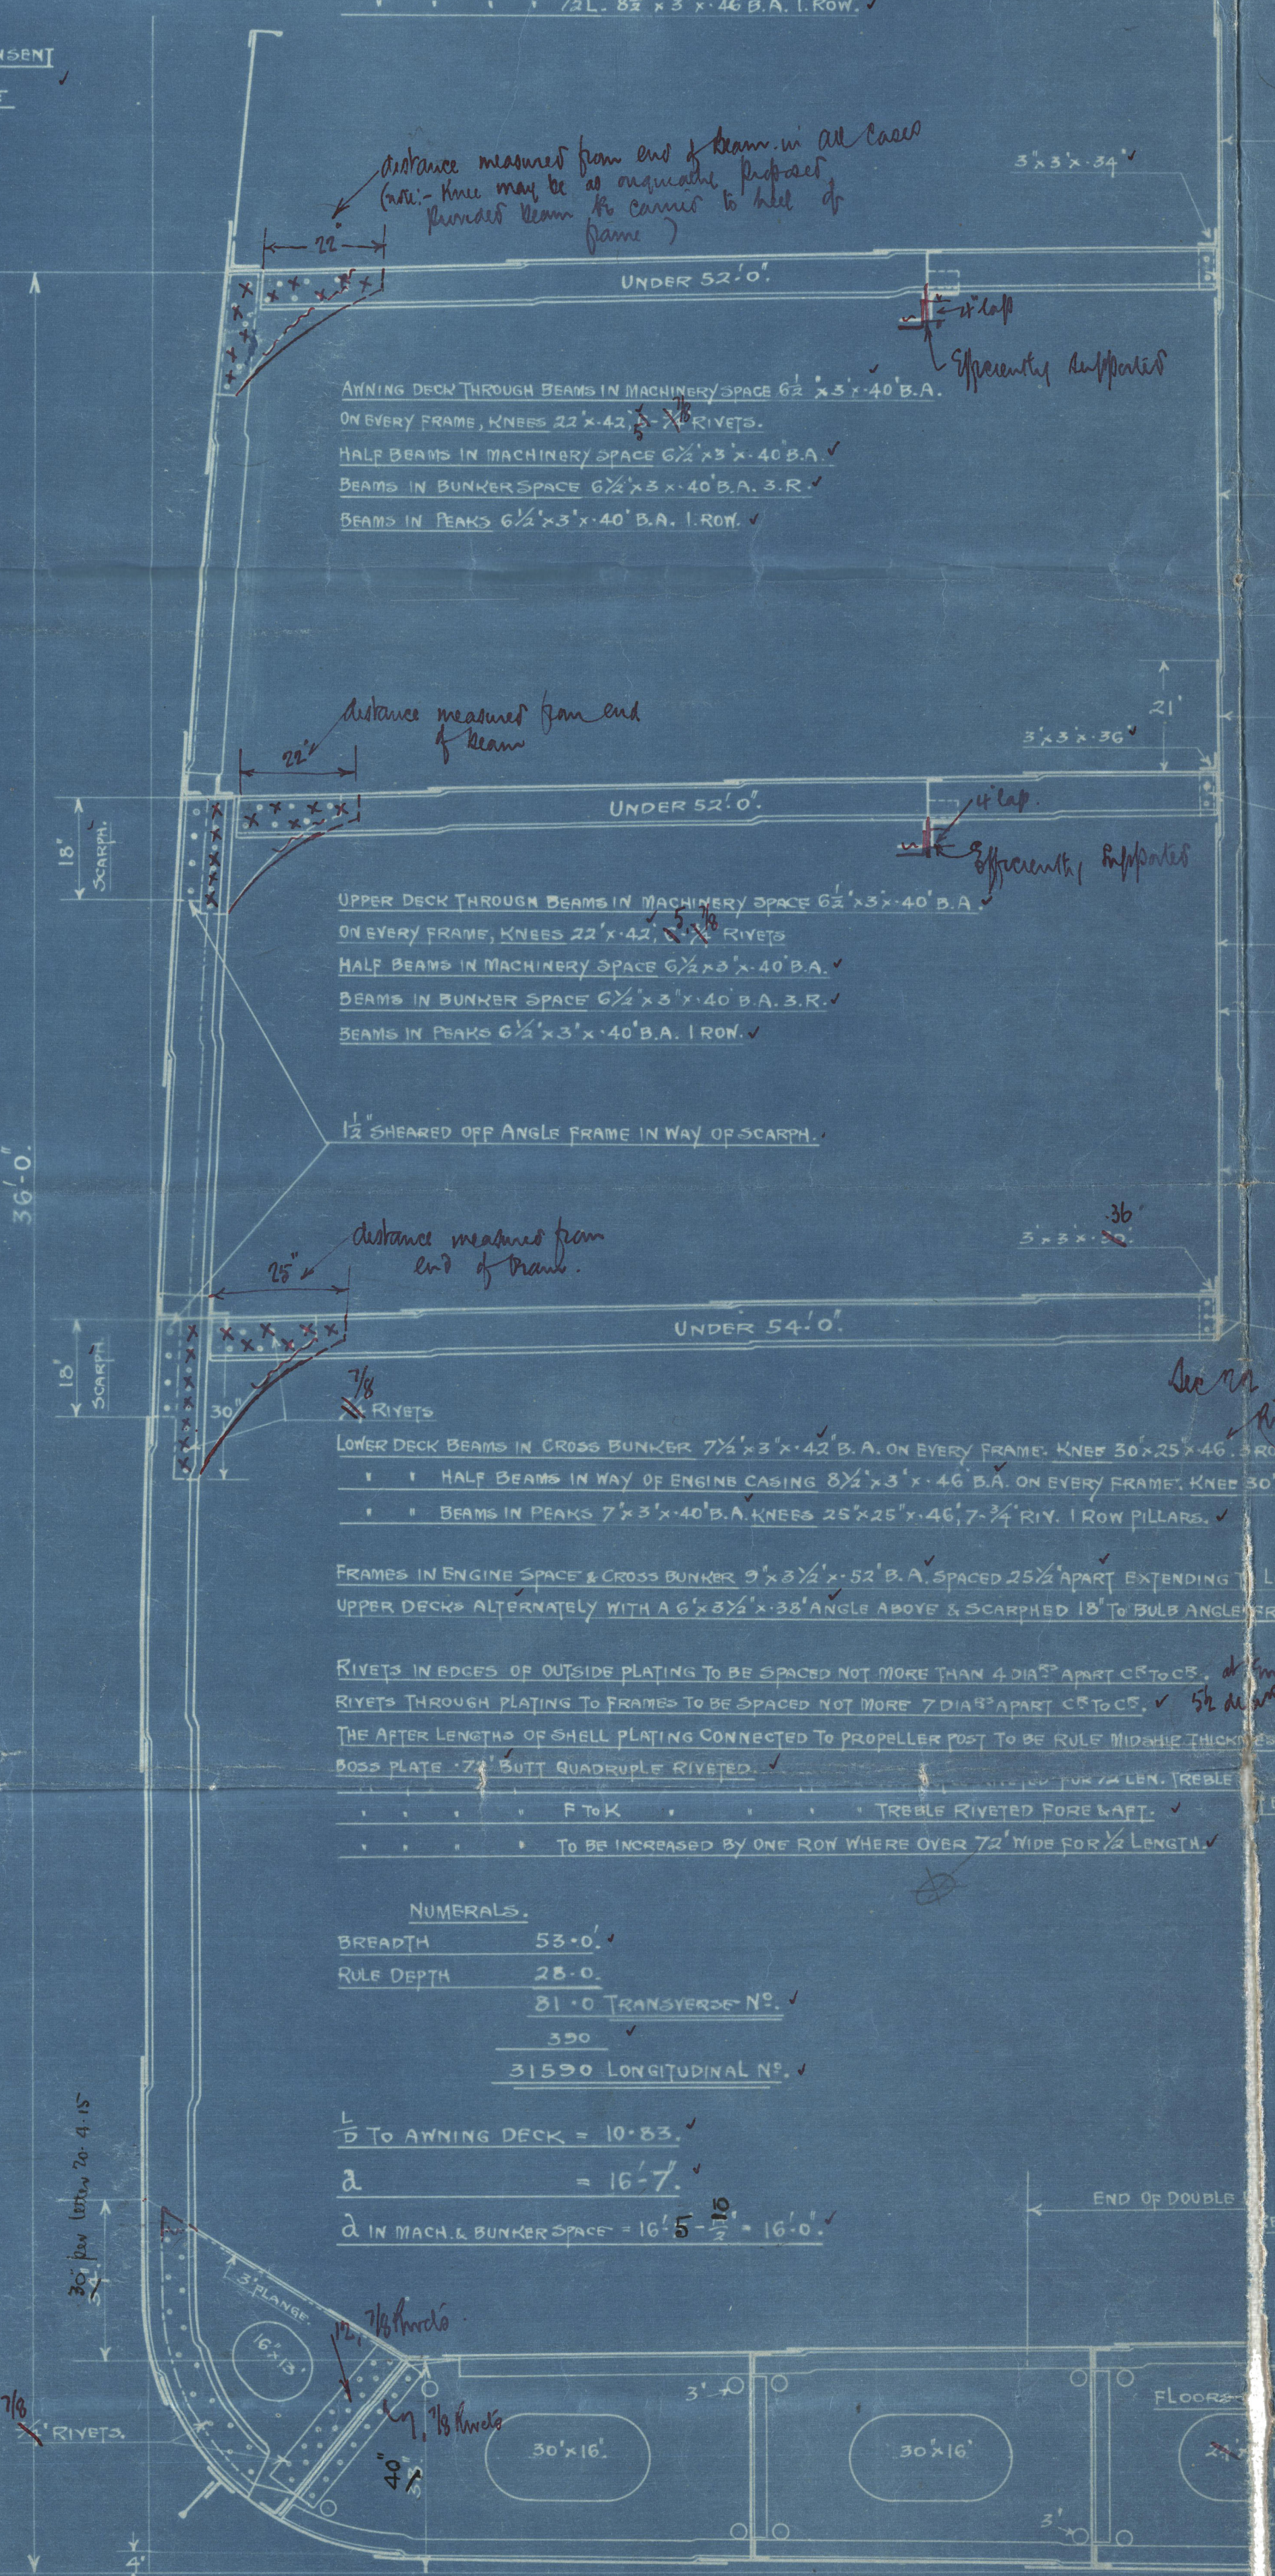

NUMERALS.	
BREADTH	53'-0".
RULE DEPTH	28'-0".
	31'-0" TRANSVERSE N ^o s.
	330
	31590 LONGITUDINAL N ^o s.

1/2 TO ANNING DECK = 10'-5 1/2".
2 = 16'-7".
2 IN MACH. BUNKER SPACE = 16'-5 1/2" = 16'-0".

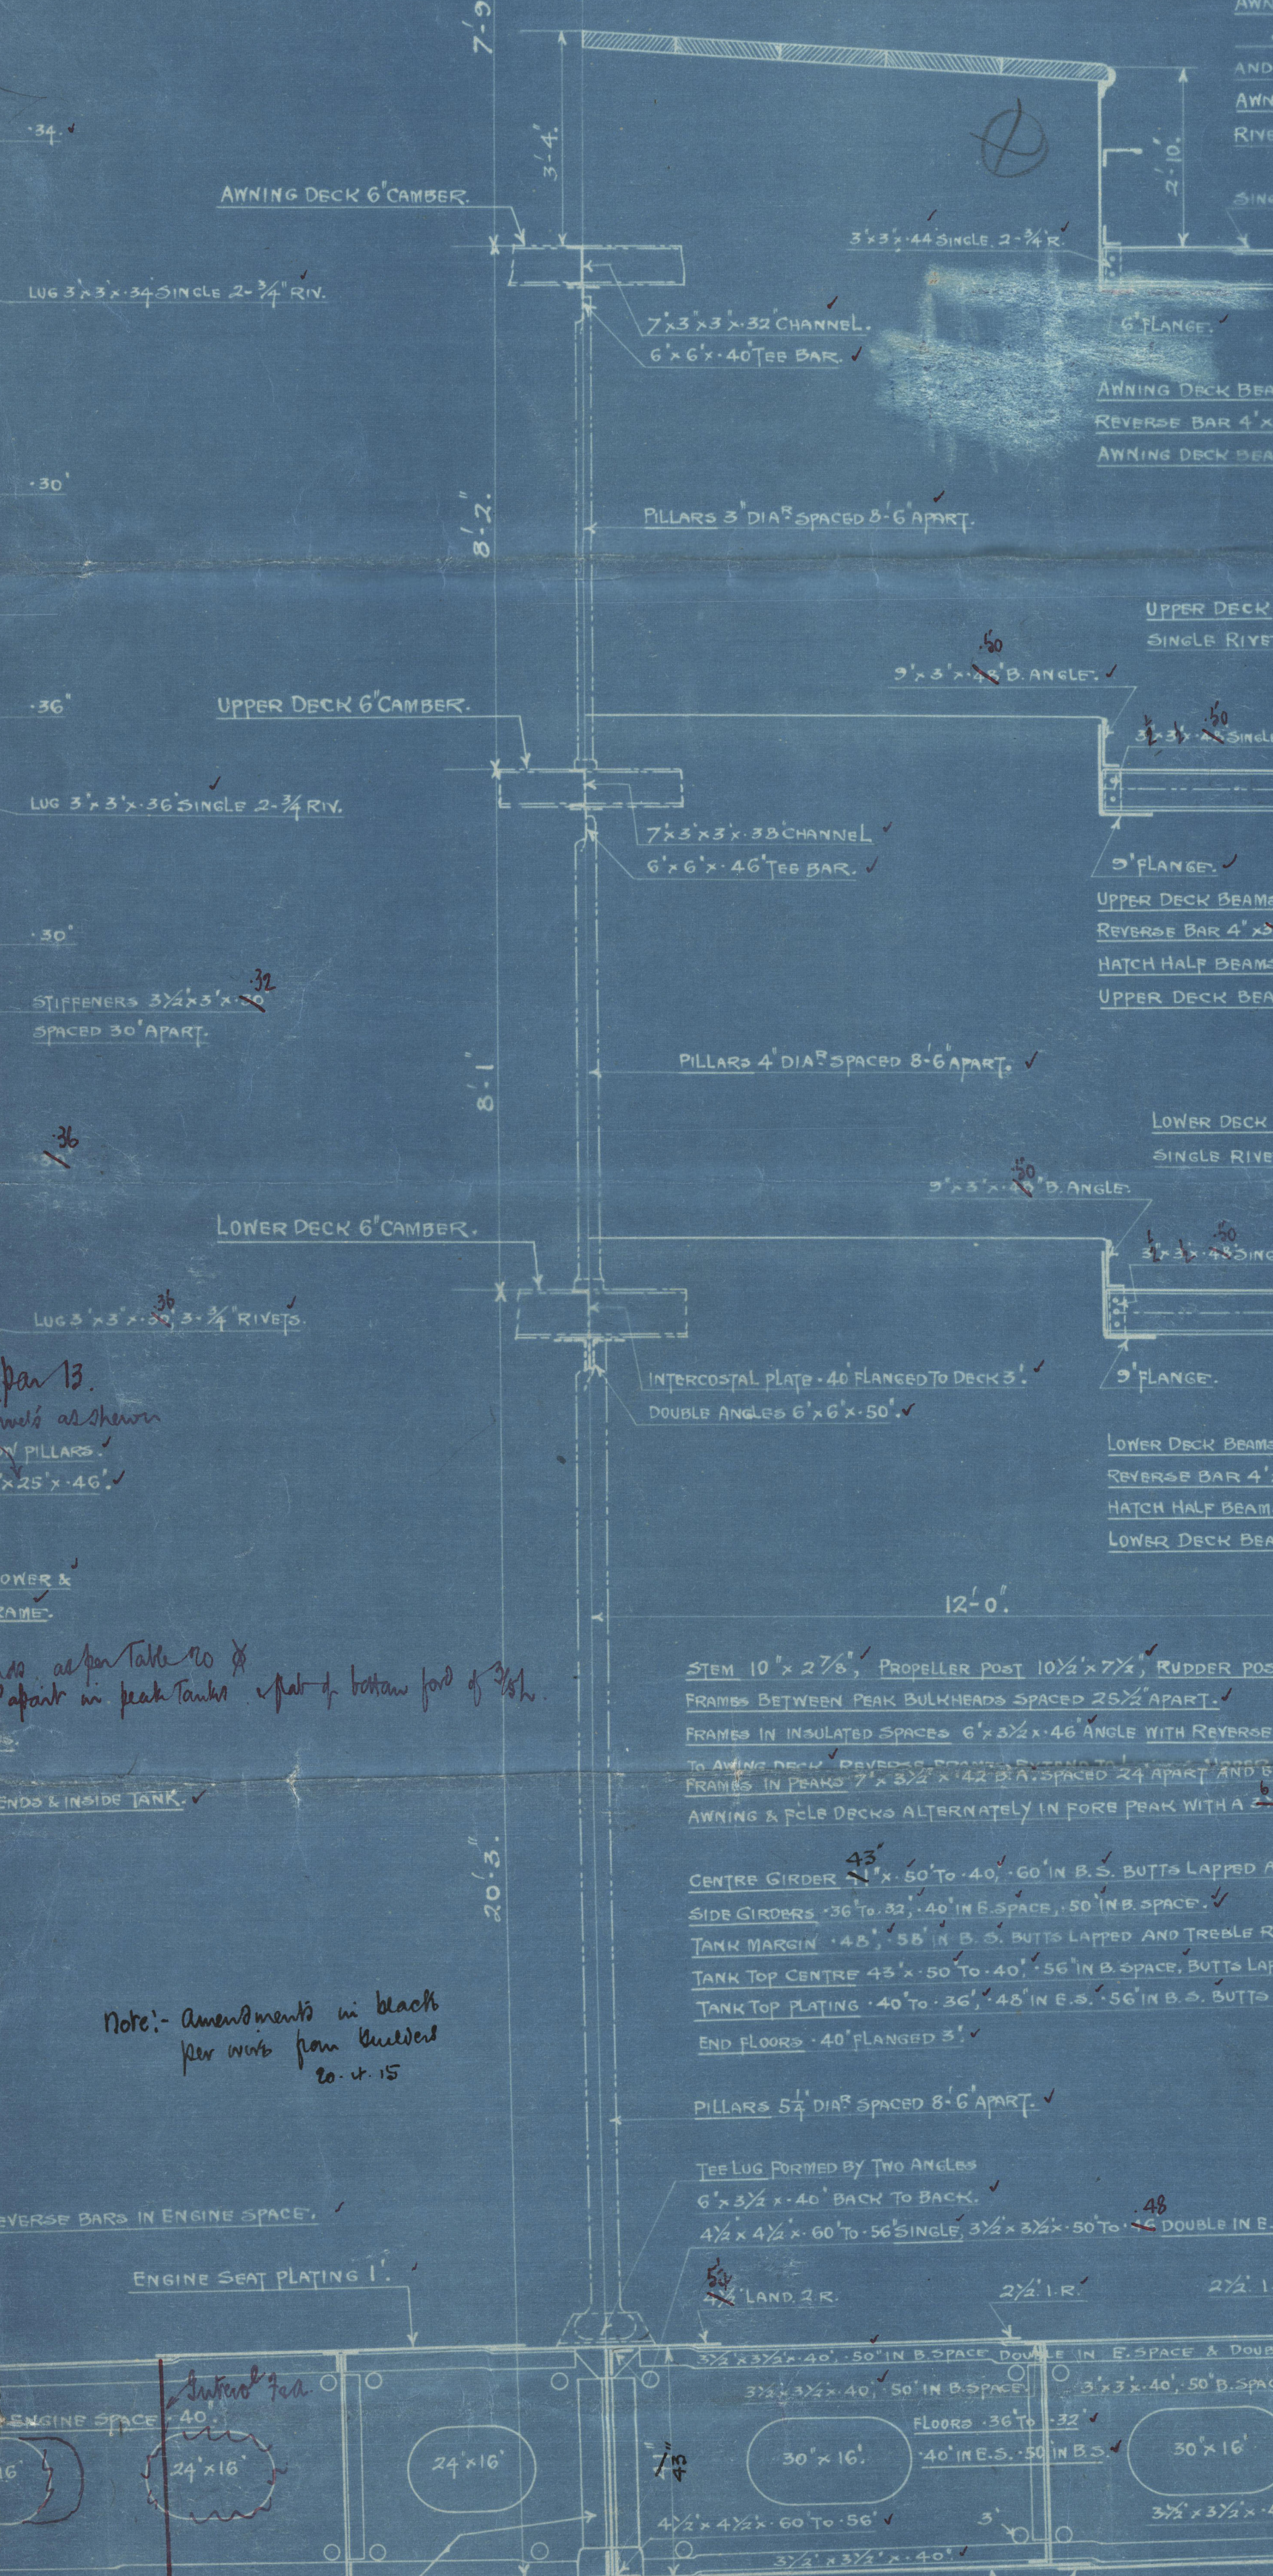

Note: Amendments in black for work from blueprint 20.4.15



BOTTOM STRENGTHENED FORWARD AS PER RULES. A.B.C.D. STRENGTHENED REDUCED BY 1/2" PER RULES. STIFFENERS 3 1/2" x 3 1/2" x 3/4" FITTED ON WT FLOORS WHERE GIRDERS ARE OVER 6'-0" APART.





Dunlop Bremner & Co.

No. 2891 ~~290~~

Midship Section

S. S. Camana

Gk Rep No. 17314.

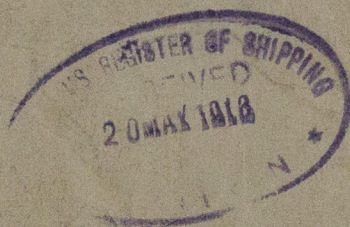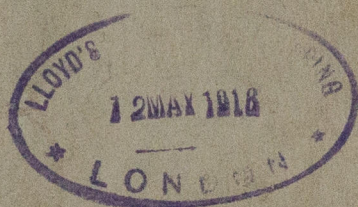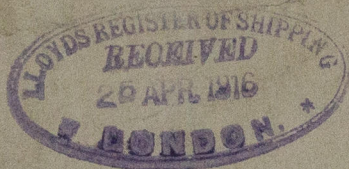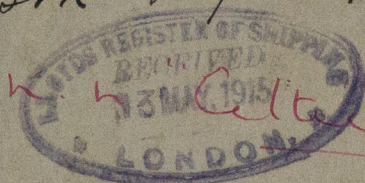

© 2020

Lloyd's Register
Foundation