

28.3.14

PROFILE AND DECK PLANS

SS. No 167

CLASS Lloyds 100 A1

DIMENSIONS 220' 35" x 15' 0" M^{LD}

No. 1 Bulwark: 28" to 26"

Scale 1/8" = 1 foot

SINGLE FRAME 4' 4" x 4' 0"

Rule depth not exceeding 13'


BEAM 3' 8" x 3'

STIFF 5' 3" x 3/4" spaced 30"

No. 2 Bulwark: 28" Bottom 26" Top
Rule depth SINGLE FRAME 4' 4" x 4' 0"
not exceeding 13' BEAM 3' 8" x 3'
STIFF 5' 3" x 3/4" spaced 30"

Masts supported to
Surveyors satisfaction

No. 111 Bulwark: 28" to 26" to be submitted

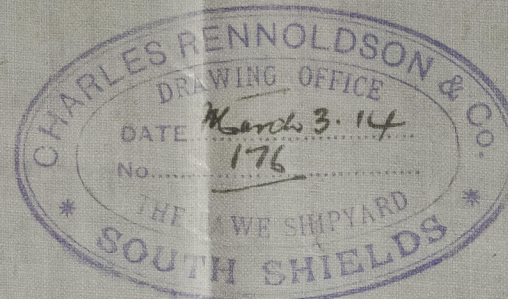




Mast Supported to Surveyors Satisfaction

Mast Supported to Surveyors Satisfaction

No. 11 Bulwark: 28" at Double Bottom, 26" Top
SINGLE FRAME 4' 4" x 4' 0"
SINGLE BEAM 3' 8" x 3'
STIFF 5' 3" x 3/4" spaced 30"

Rule depth not exceeding 13'

WOOD CHART-HOUSE
20' Rating Over Accommodation

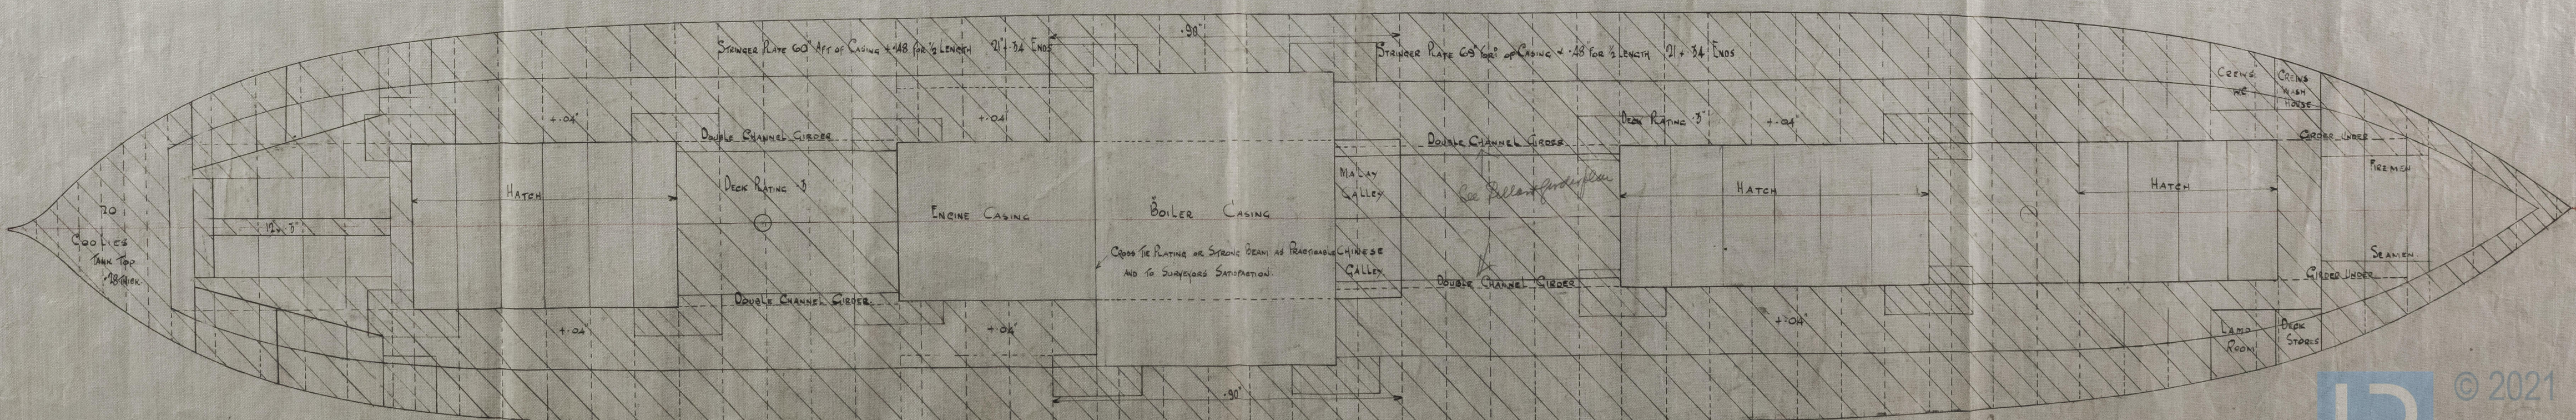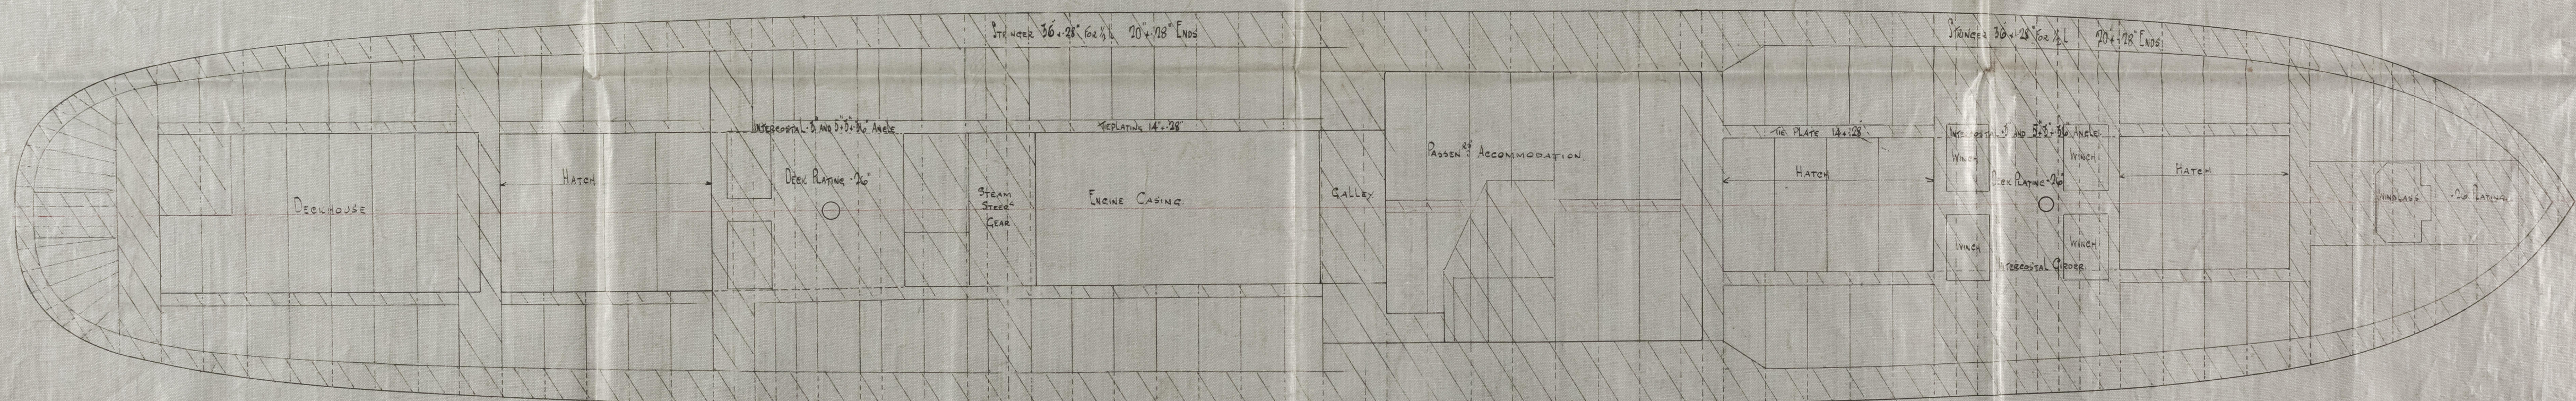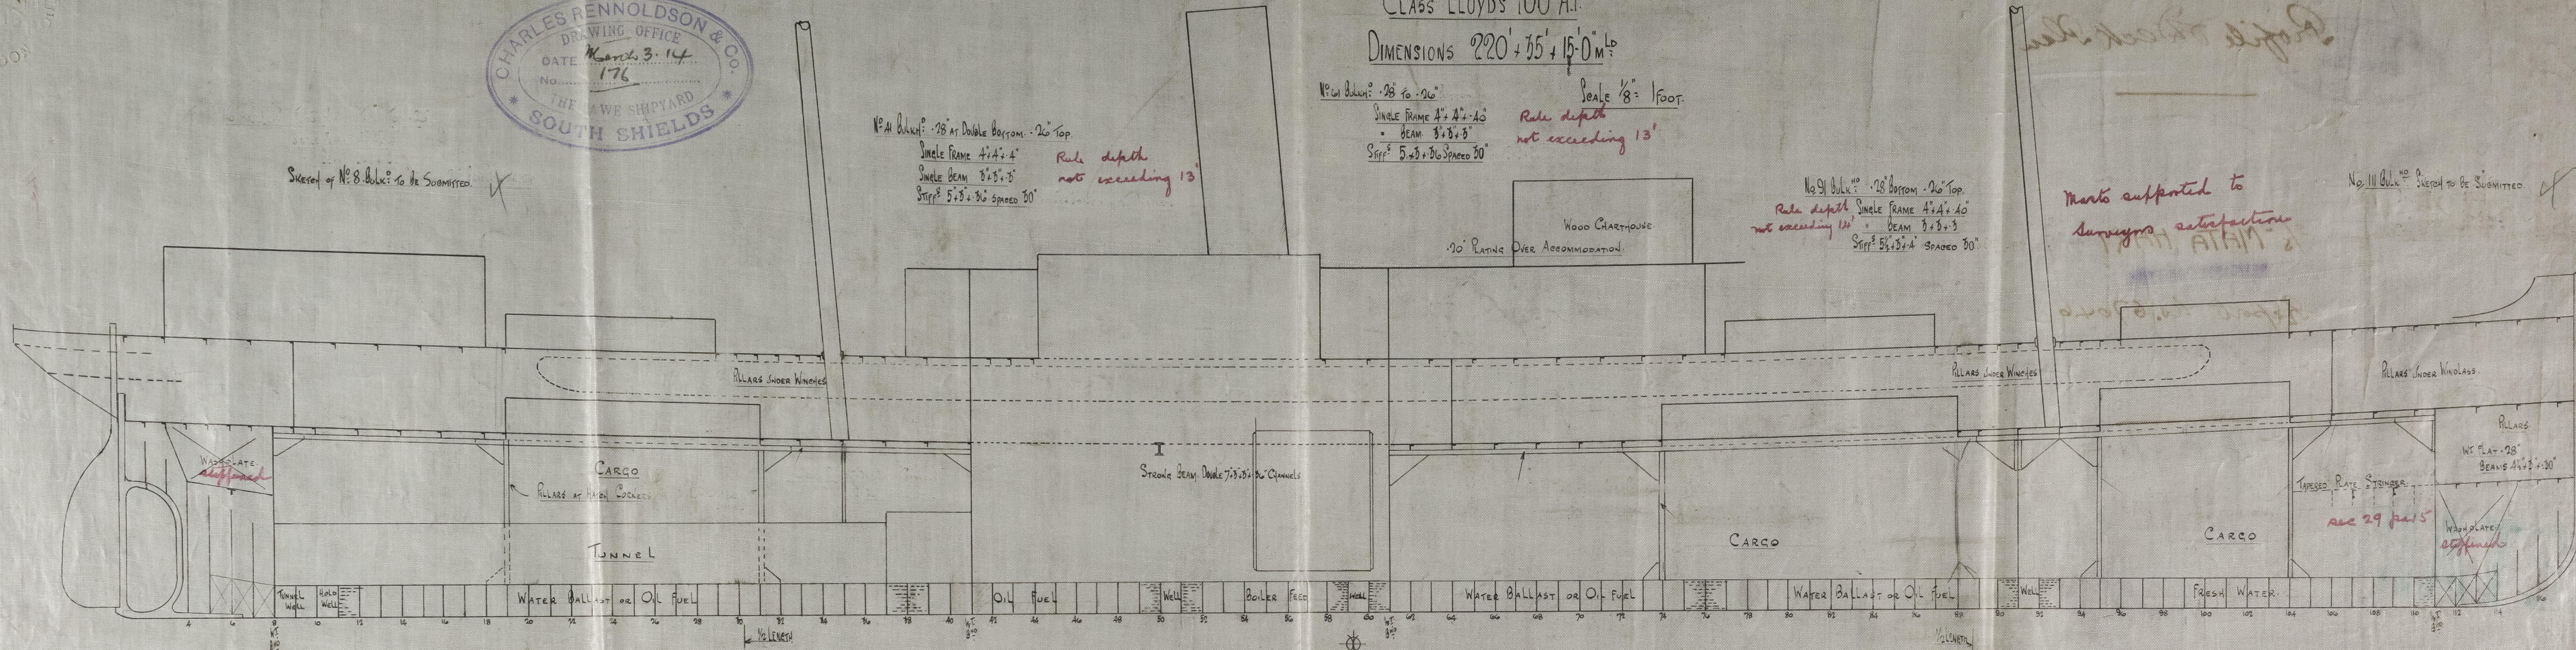

28.3.14



© 2021 Lloyd's Register Foundation 01530-0170

C. Hennoldson & Co

167 ship



Profile & Deck Plan

S/S "MATA HARI"

NEWCASTLE-ON-TYNE

Report no. 67646

18.7

RETAILED



© 2021

Lloyd's Register
Foundation

W1530-0170