

No. 109  
 11.5.07  
 11.5.07  
 11.5.07

No 109

S.S. No 109

MIDSHIP SECTION.

STEEL SCREW FLEETERS.

NUMERALS

1/2 GIRTH	13.16
DEPTH	13.00
1/2 BREADTH	10.75
1st NO	42.91
LENGTH	108.875
2ND NO	4671.826

DIMS 110.088 21.6 12.6 MW

SCALE 1 FOOT

TO CLASS 100A.1 AT LLOYDS.

EQUIPMENT No 4671


ANCHOR	4 3/4 CWT. EYSTOCK
1	4 1/4
1	2 1/2
30 FTMS	5/16 STUD LINK CHAIN
60	5/8 HAWSER
60	4 WARP

L/B = 5.06

L/D = 8.37

24/10/07  
 a.m.

8/5/07  
 a.m.

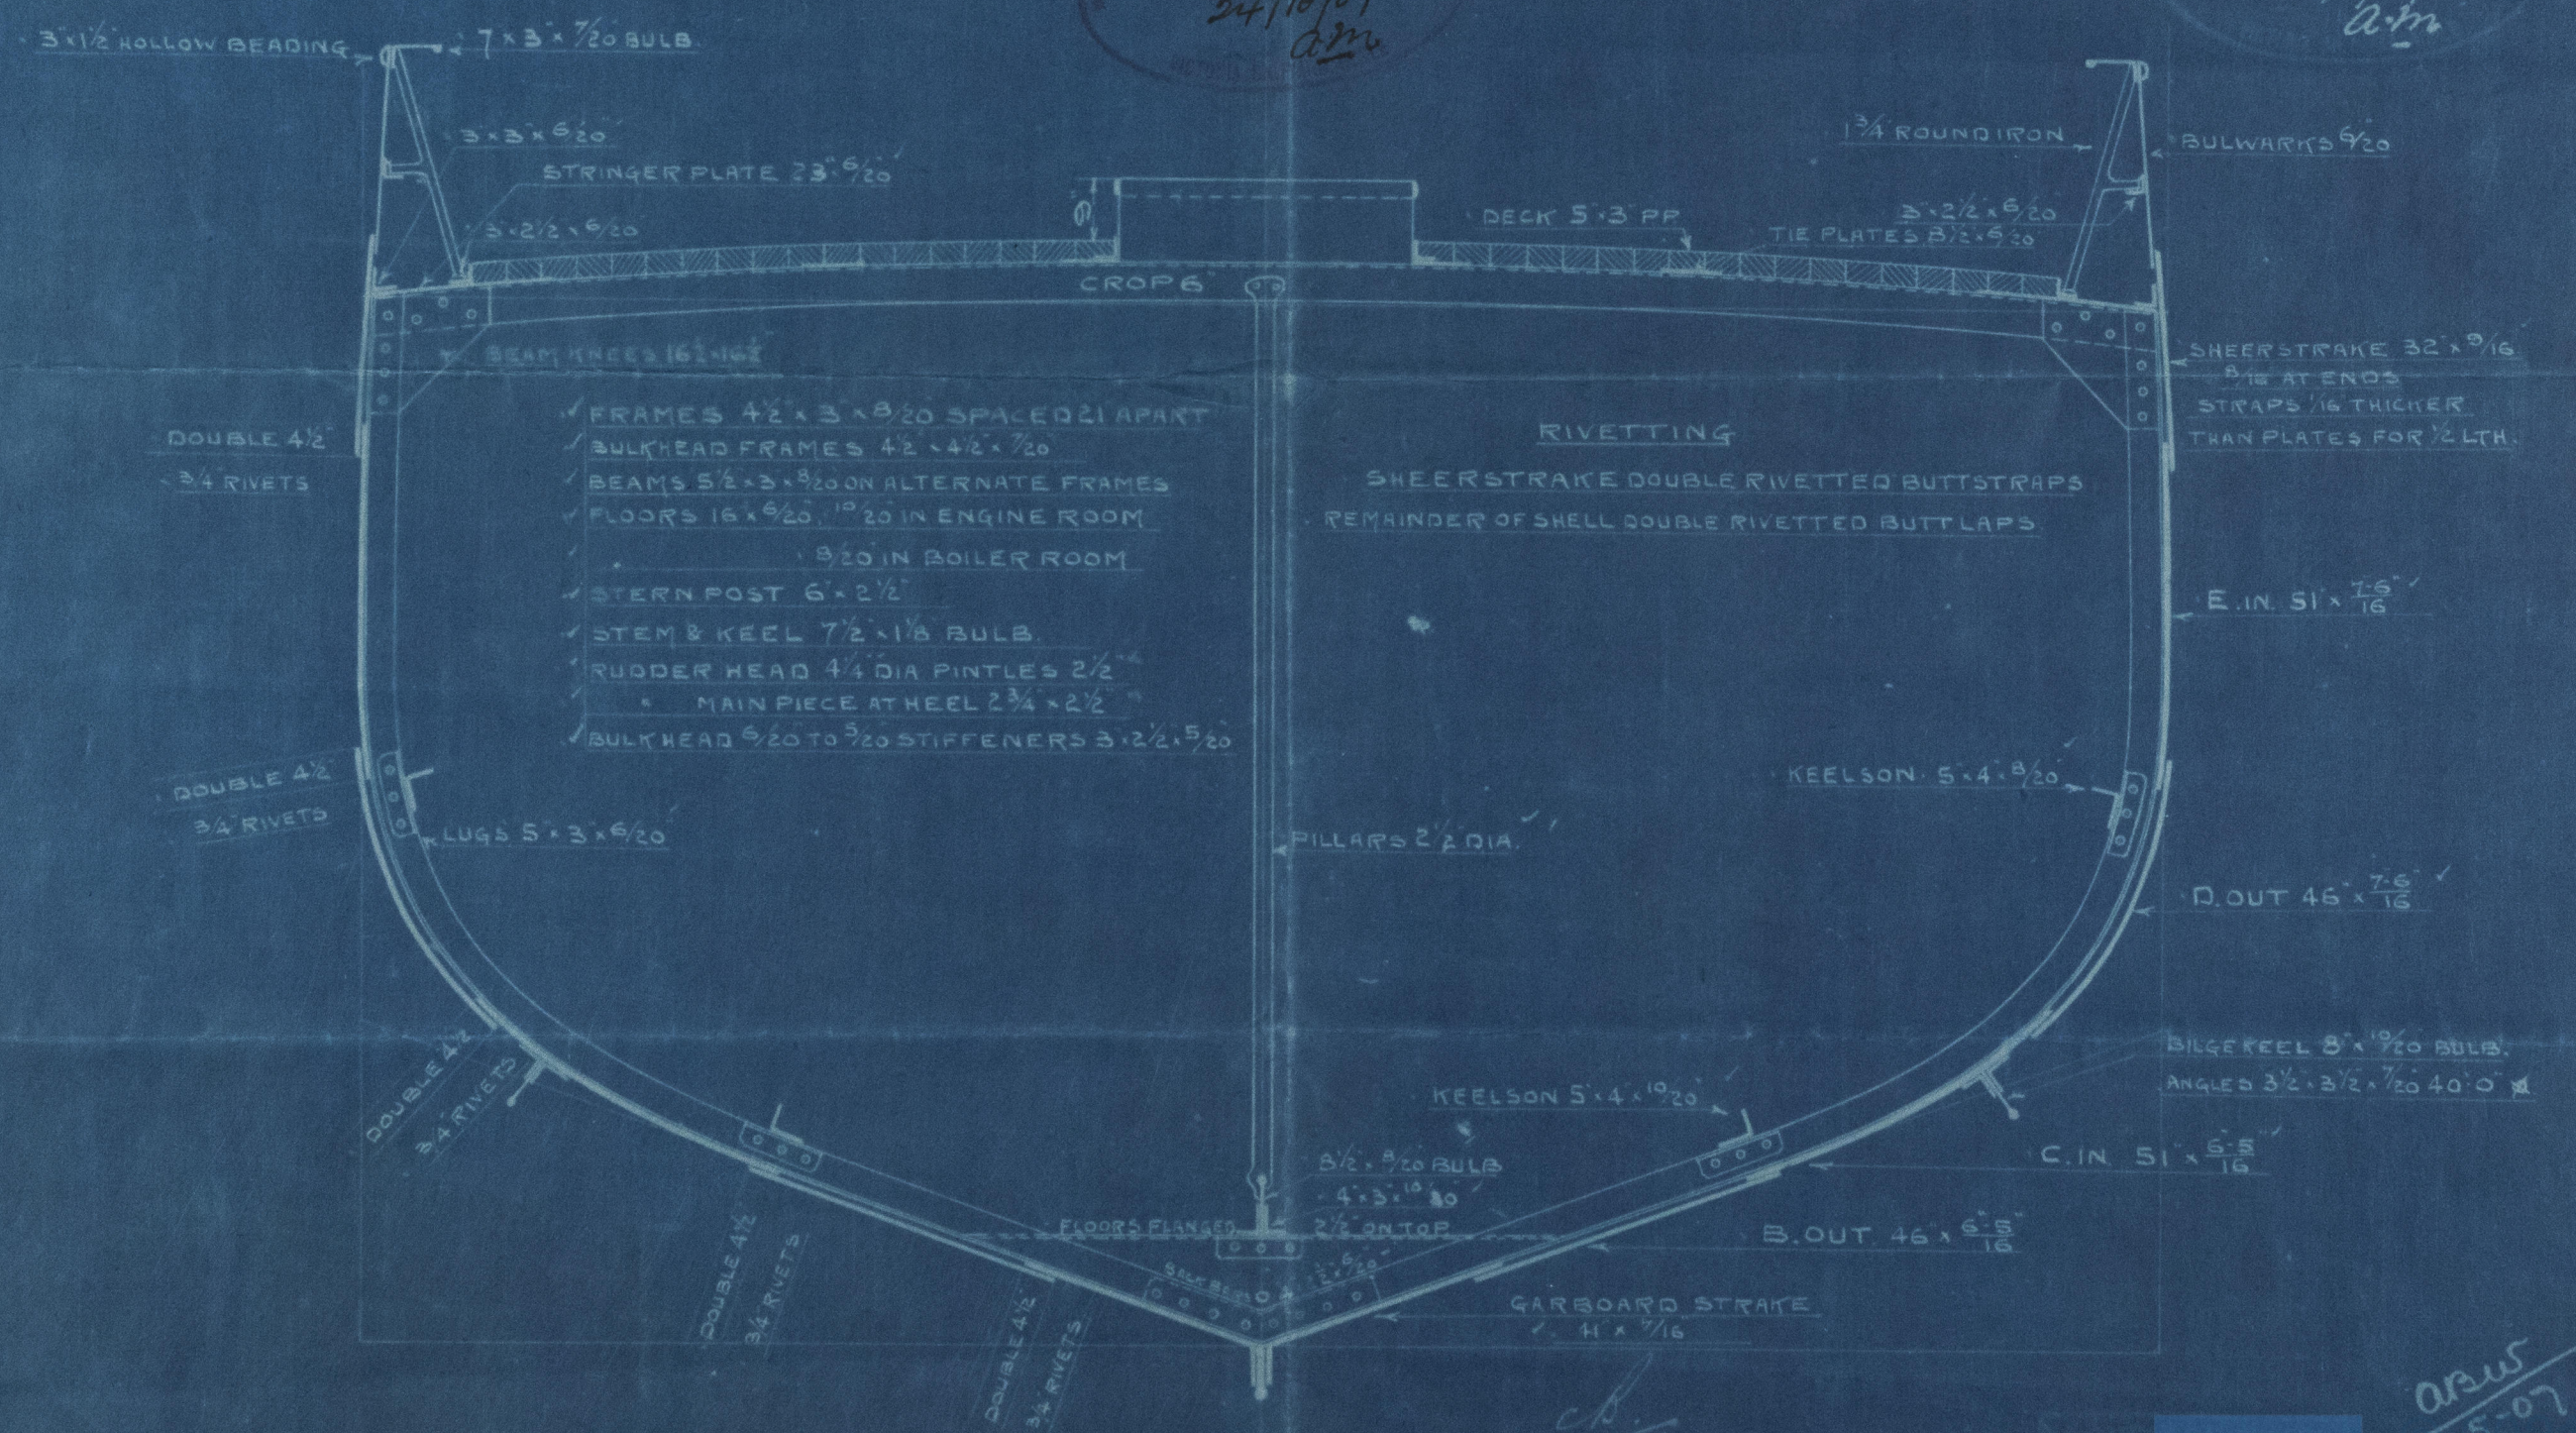

11.5.07

asur  
 9.5.07



Lloyd's Register  
 Foundation  
 01700-0125



Boole S. & R. Co. Ltd.

Duplicate

Midship Section.

No 99. 101. 106. 107

108. 109. 110 & 111

of "Masterwing"

Hull Report No 19967.



RETAIN



© 2021

Lloyd's Register  
Foundation

W1530 - 0183