




23.12.04
14.1.05
30.1.05
15.2.05
10.4.05



Nº 494
PROFILE AND DECK PLANS



THREE D^o RULE.
DIMENSIONS 340-0 B.P. x 50-0 E. x 27-0 M.L.D.
LLOYDS " 338-16 x 49-8 x 28-0

Sketch showing method of fitting
Hatch Cranes on Upper & Middle decks.

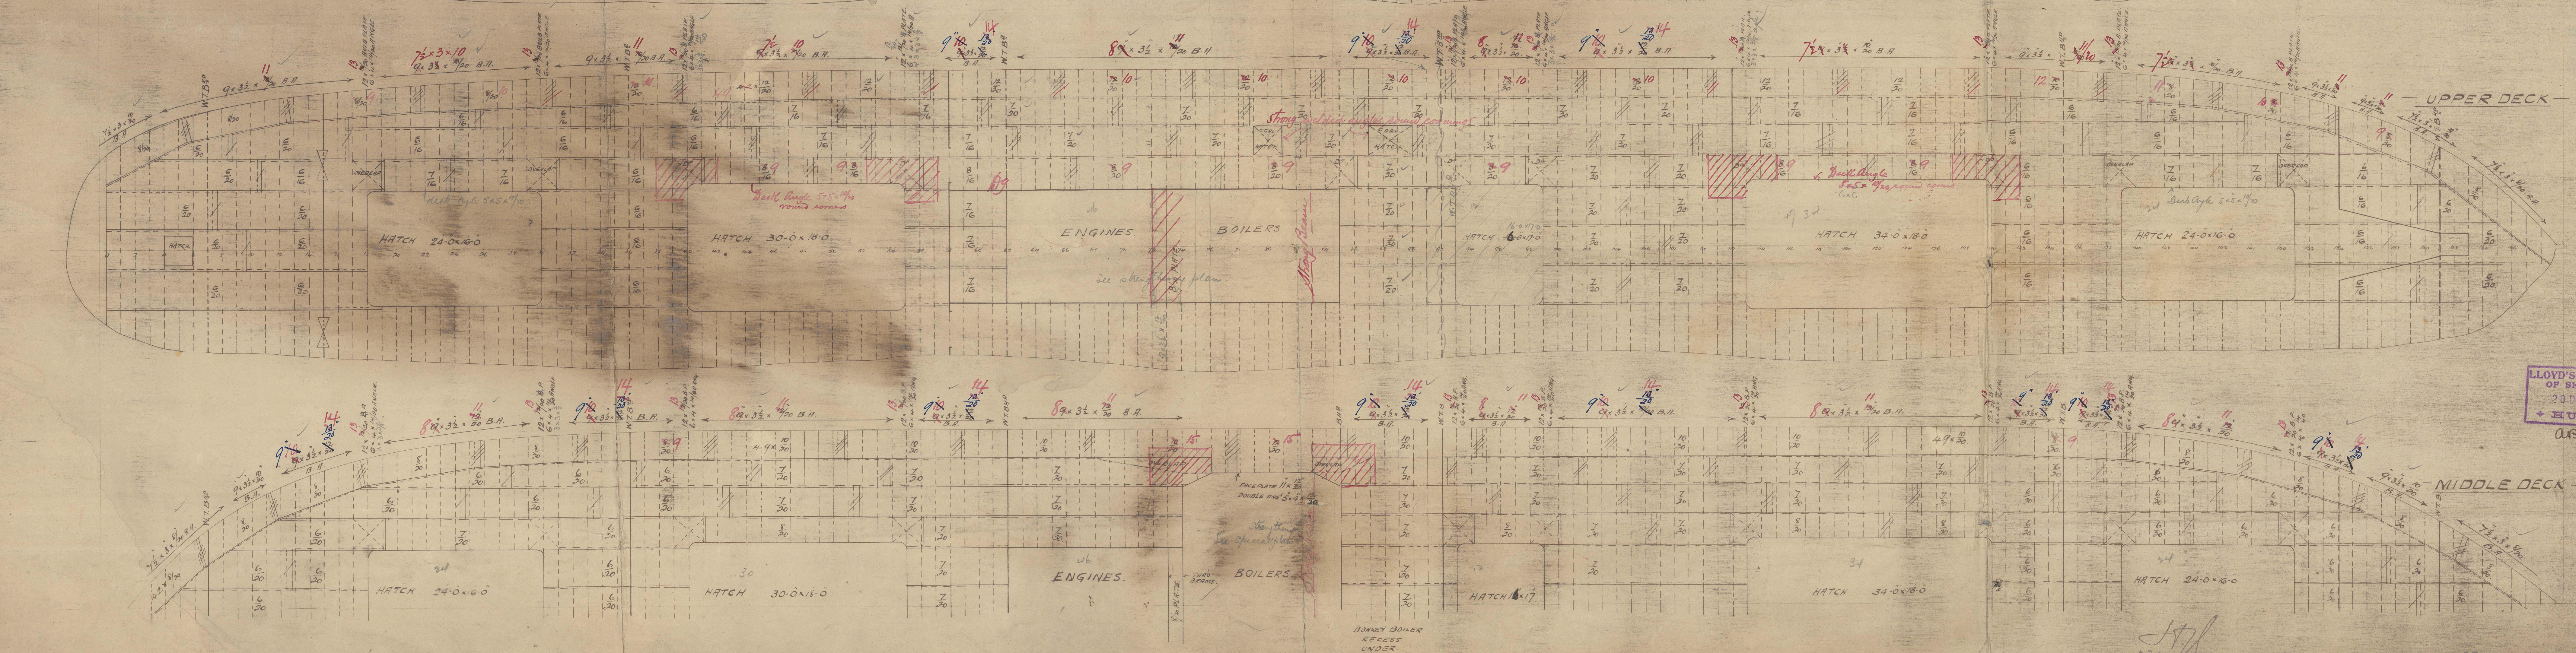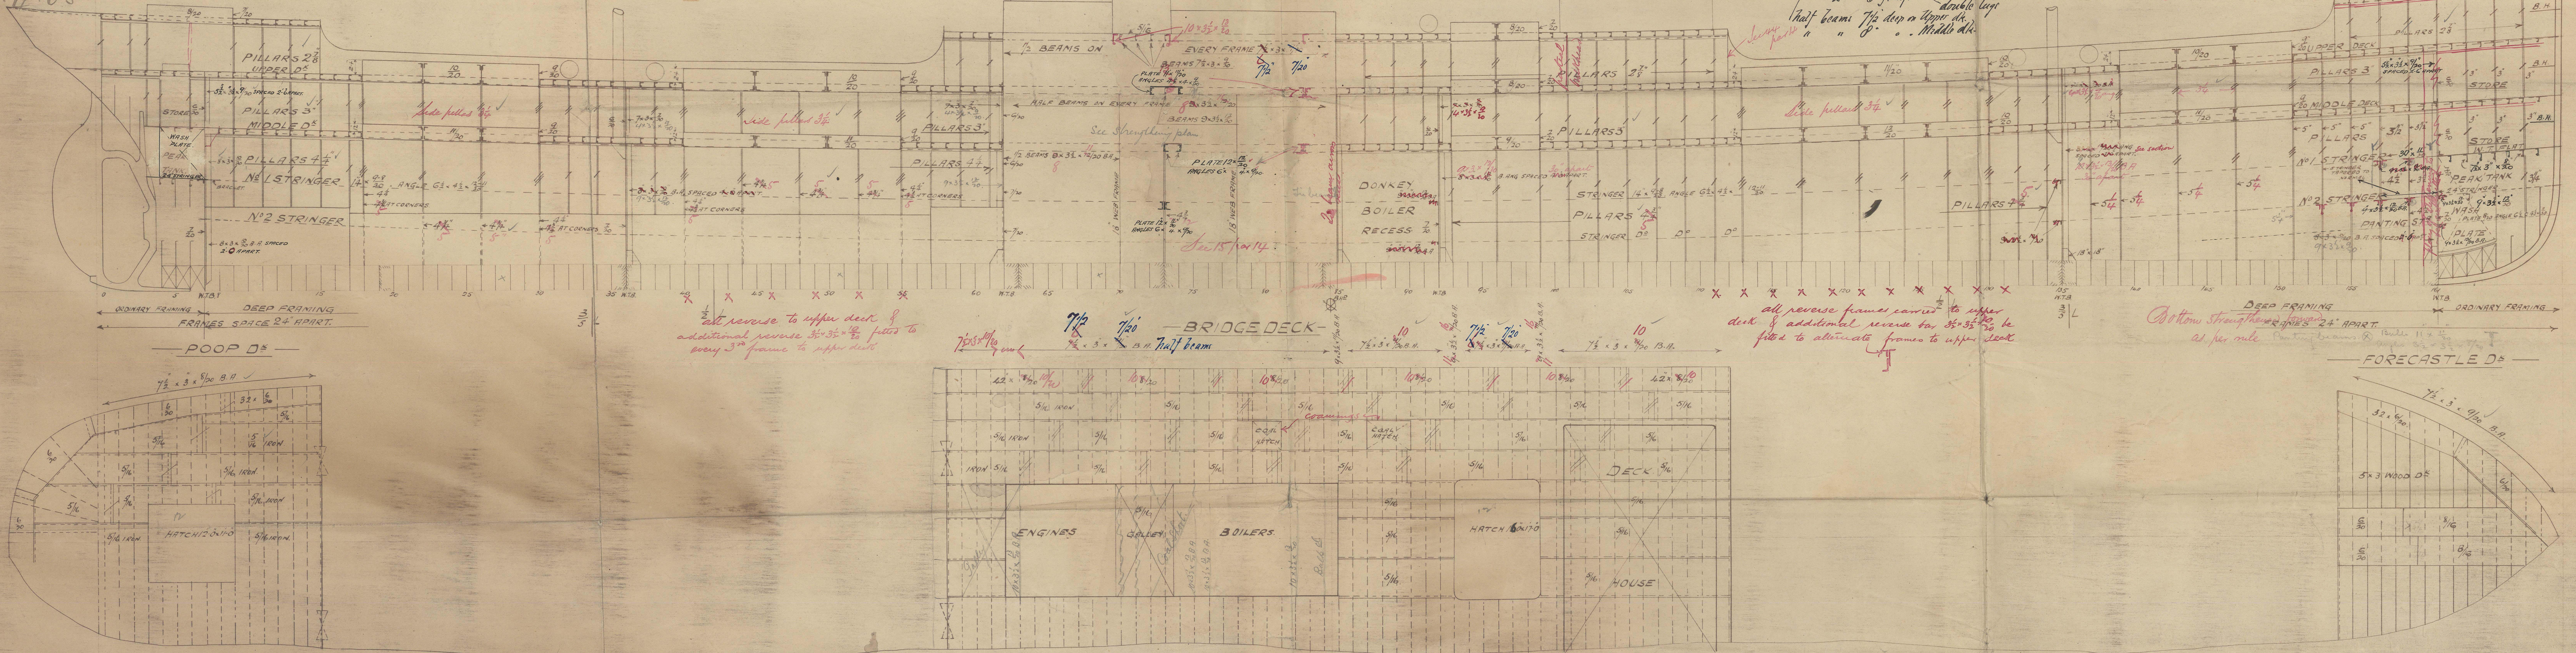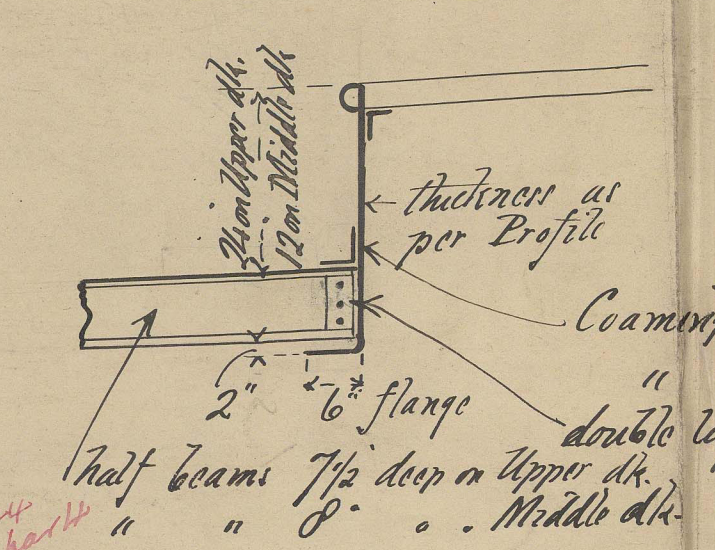

LLOYD'S REGISTER
OF SHIPPING
20 DEC 1904
HULL
A.S.W.

Earles S. & E. Co. Lim.
N^o. 494.
Profile & Deck Plans.

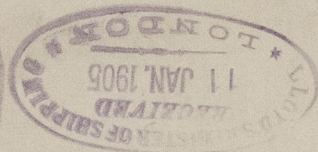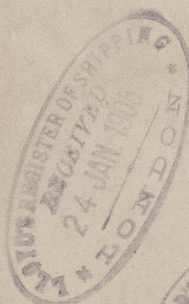

ss "Phoenix"
Hull Rpt no. 17135

RETAIN



© 2021

Lloyd's Register
Foundation

W1532-0133