

13.2.14
16.3.14
12.10.14


Filed as approved: alternative plan not adopted

BRIDGE DECK GIRDERS				UPPER DECK GIRDERS			
FRAMES	APPROVED	DEPTH	ALTERNATIVE	FRAMES	APPROVED	DEPTH	ALTERNATIVE
32-39	20 YxYx56 ANGLE	12 1/2	10 Yx3 1/2 x 40 BA	9-24	20 YxYx50 ANGLE	14 1/2	12 Yx3 1/2 x 40 BA
39-53	YxYx80	"	12 Yx3 1/2 x 7 1/4	24-39	YxYx70	14 1/2	12 Yx3 1/2 x 80
53-66	GxGx70	11 1/2	10 Yx3 1/2 x 70	39-53	YxYx80	13	12 Yx3 1/2 x 7 1/4
66-74	GxGx60	"	10 Yx3 1/2 x 60	53-68	YxYx80	"	12 Yx3 1/2 x 80
74-119	YxYx80	12 1/2	12 Yx3 1/2 x 7 1/4	68-104	YxYx80	"	12 Yx3 1/2 x 7 1/4
119-133	YxYx80	"	12 Yx3 1/2 x 7 1/4	104-119	YxYx80	"	12 Yx3 1/2 x 7 1/4
133-139	YxYx50	"	Yx3 1/2 x 40	119-133	YxYx80	"	12 Yx3 1/2 x 7 1/4
				133-147	YxYx60	14 1/2	12 Yx3 1/2 x 70
				147-160	GxGx70	"	10 Yx3 1/2 x 70

brackets to girder every 14 1/2 beam
with angle lug to intermediate beams
carried to bottom of girder.

LONGITUDINAL SECTION

CLASS 100A1 LLOYDS.
SCALE 1/8"=1 FOOT.
RULE DIMENSIONS: 351.87x49.92x25.25.
UNDERDECK TONNAGE ABOUT 3400 TONS.

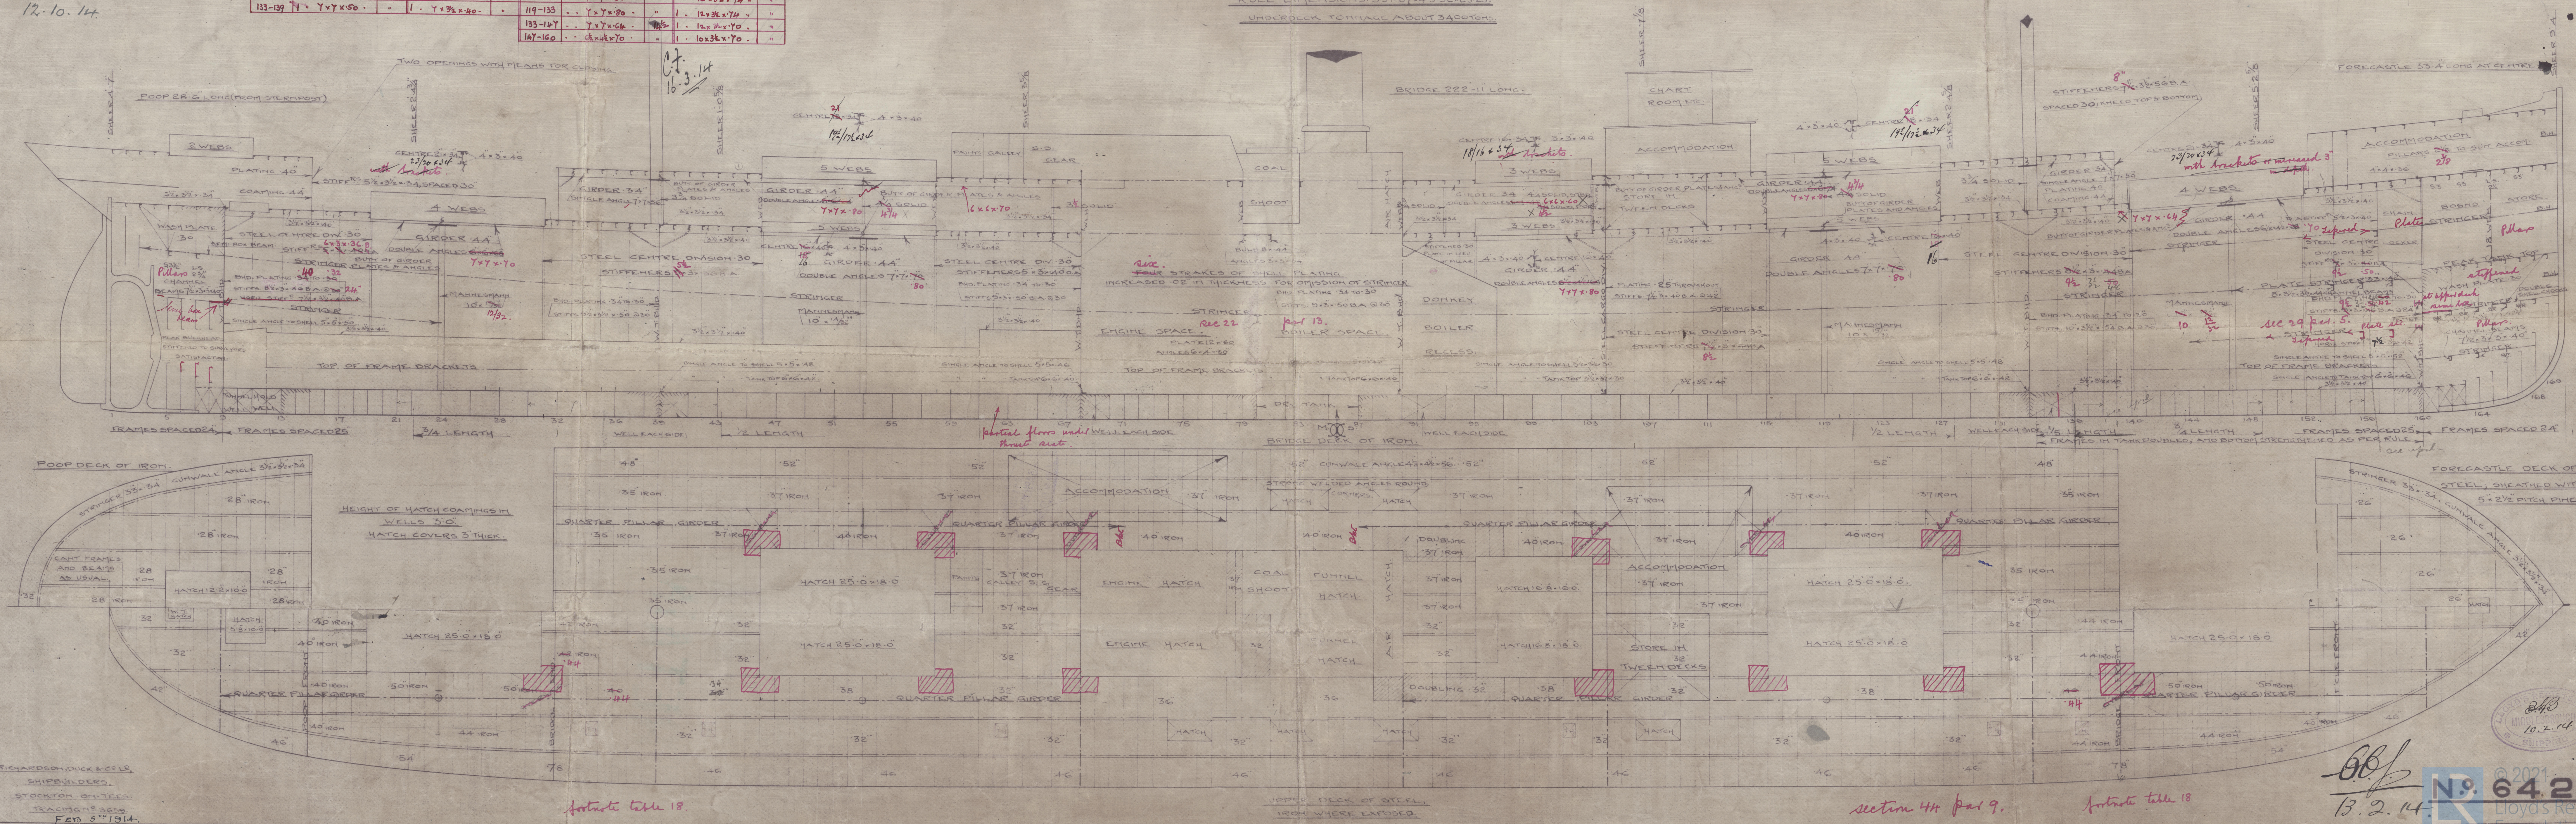

RICHARDSON, DUCK & CO. LD.
SHIPBUILDERS,
STOCKTON-ON-TEES.
TRADING IN 36-38
FEB. 5th 1914.

fortnote table 18.

UPPER DECK OF STEEL
IRON WHERE EXPOSED

section 44 par 9.

fortnote table 18


BB
13.2.14

© 2021
N^o 642
Lloyd's Register
Foundation
41535-0087

Trust Richardson & Co. & Co. d
No 42

Profit & debts

Sp. Bureak

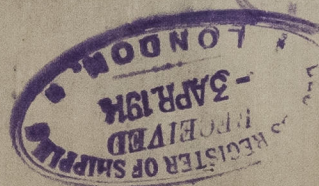

Grab Rpt. No. 8721.



RETAIN



© 2021

Lloyd's Register
Foundation

W1535-0087