


CLASS 100 A.I. LLOYDS.

TRANSVERSE №	77-92
LONGITUDINAL №	29600
DEPTH d	2392
% BRIDGE DECK	10-7
% UPPER DECK	13-9
EQUIPMENT №	31752

2 30WZRS	56 $\frac{1}{2}$ CNT	STOCKLESS
1 "	47 $\frac{1}{2}$ CNT	"
1 STREAM	15 CNT	EX STOCK
1 KEDGE	6 $\frac{1}{2}$ CNT	" "
270 FATHOMS	2 $\frac{3}{8}$ "	STUD CHAIN CAB
90 "	4 $\frac{1}{2}$ "	MOORING WIRE
120 "	4 $\frac{1}{2}$ "	STEEL TOWLINE
2 OF 90 "	2 $\frac{3}{8}$ "	STEEL HANSEK
2 OF 90 "	7	MANILLA WARP

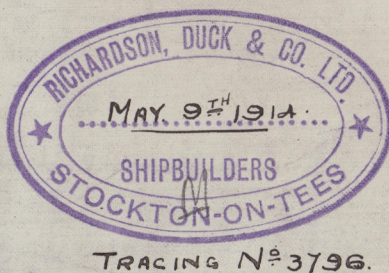




Miss R<sup>n</sup>. Duck Clerk

No 638

Mid: Lic: as Built

Sr. Busk

Mat. Rpt. No. 8420

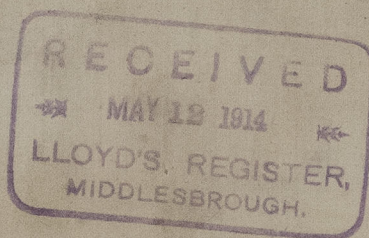

RETAIN



© 2021

Lloyd's Register  
Foundation

W1535-0097