

Length on Load line	345.0	
Depth mtd. to Main dk	18.00	
Estimated Funnage buff <sup>4</sup> - uncovered	57	
Length of Vireos	209.7	} Prop. x Bridge 168.0" Full 41.7" 209.7
Shew for	84	
" aft	36	
" & L. from Shew	467.4	
" & L. " Shew	197.7	
Mean Shew at & Length	33 1/8	

Sides of after  
width hatch  $\frac{1}{30}$

Scale  $\frac{1}{8}" = \text{one foot.}$

Sides of after

9/20 Sales ✓ P ✓ End Coatings 20

red 6" Sides

8  
30 Coaming

Hatch 16'-0" x 10'-0"

Water 16'-0" x 10'-0" Low

Painting Beans  $8 \times 3 \times \frac{9}{29}$  &

88	92	96	100
----	----	----	-----

12 15

11

[illegible]

0	8	1	6/30
---	---	---	------

Hand-drawn diagram of a hatch section. It shows a vertical line on the left labeled "Hatch" and a horizontal line on the right labeled "Hatch".

Handwritten notes on lined paper, including the word "Horse" and some illegible scribbles.


96	100
----	-----


Sketch

For below

Mod.

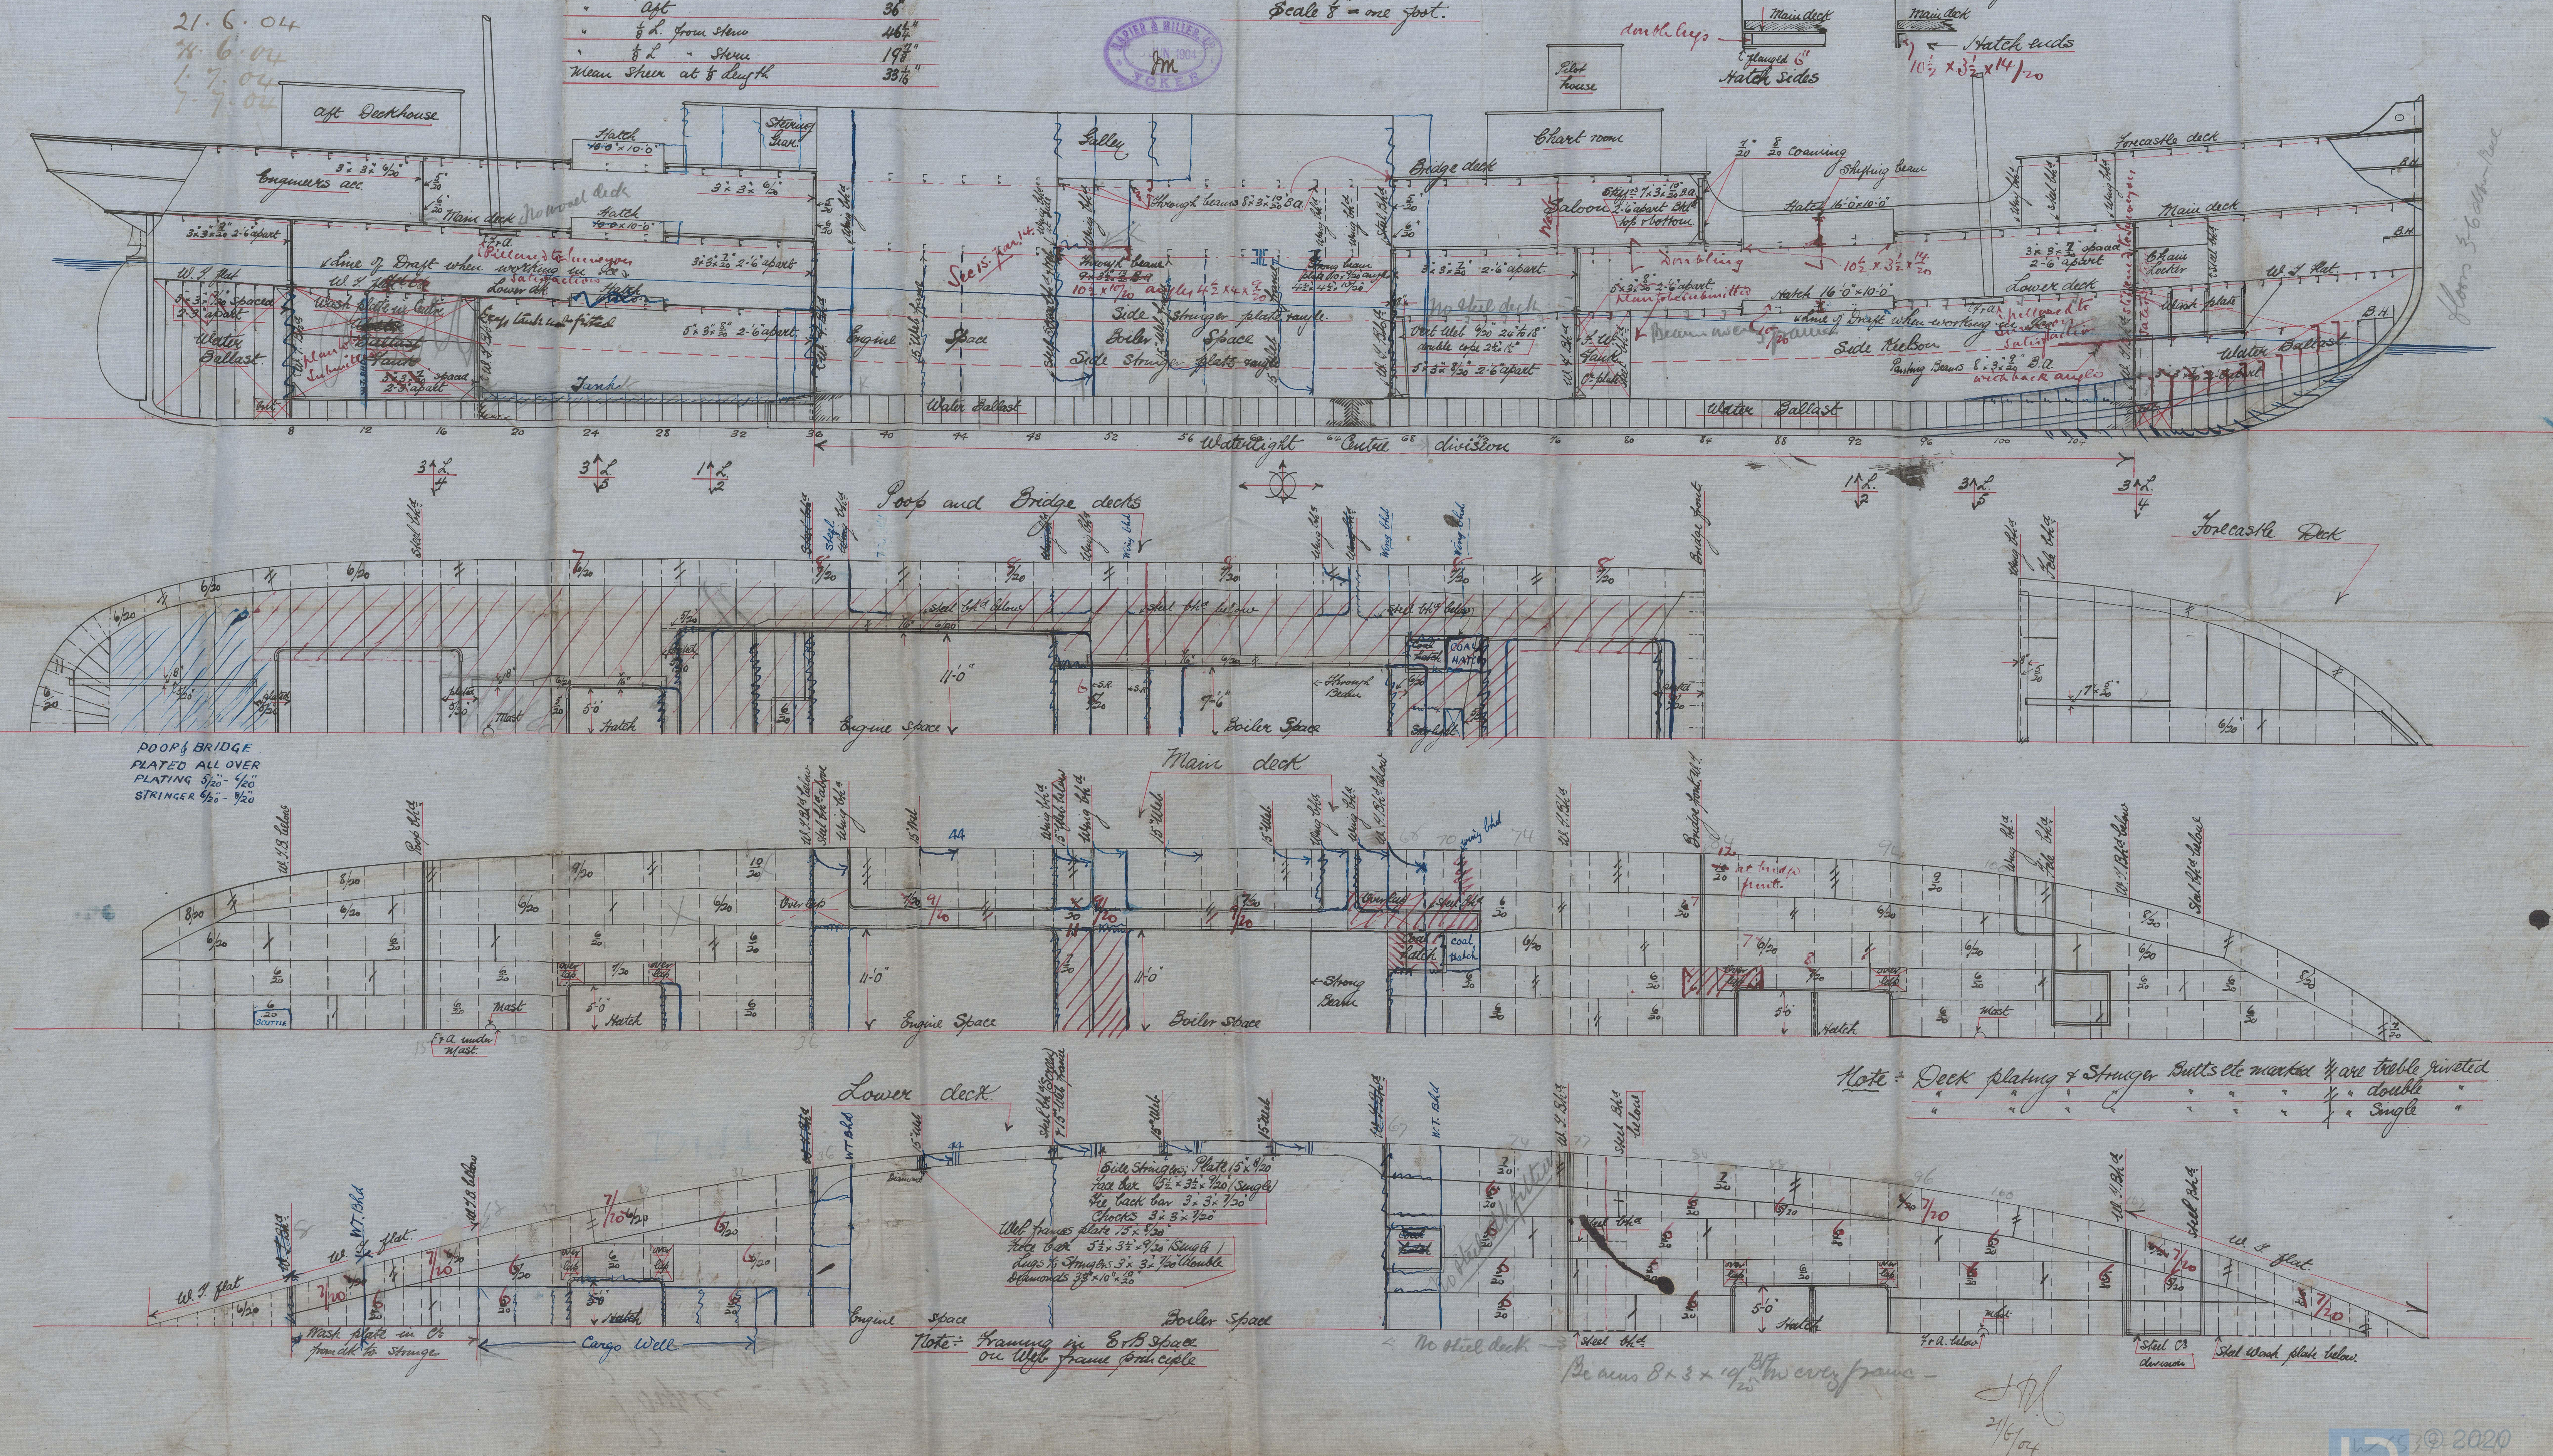



People - 137  
Proposed Steam A  
"Montcalm"  
Glasgow No 22300

D19T

W 1537 - 0124



© 2020

Lloyd's Register  
Foundation