


Section
Proposed Steam ¹³⁷ P.
MONTCALEM
Glasgow npt No 22300

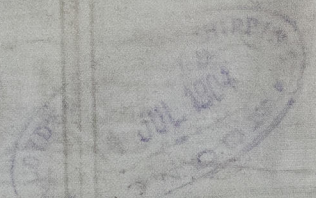

W1537-0126



© 2020

Lloyd's Register
Foundation

ms

"A" No 10
MONTAGNA

W 1537-0126





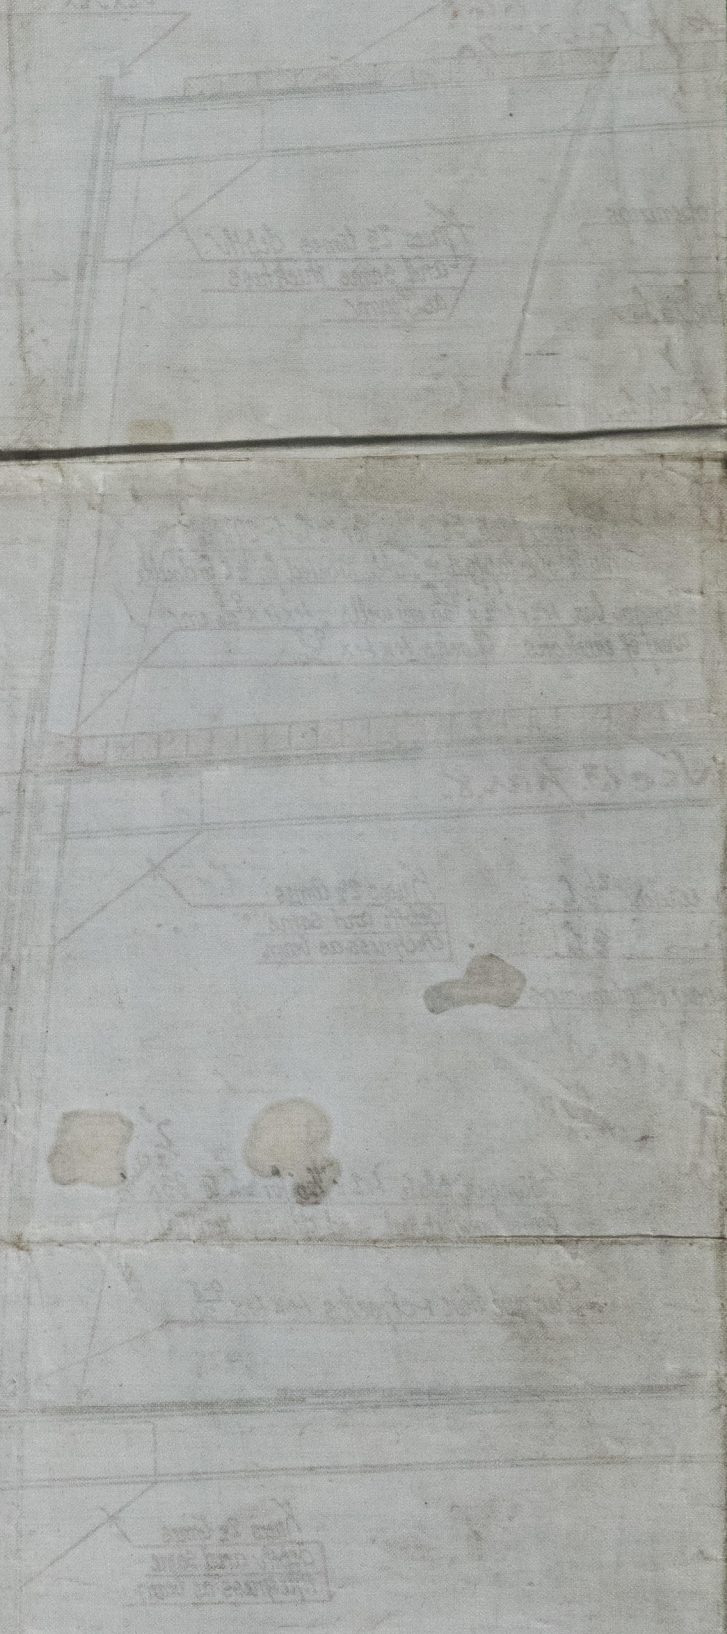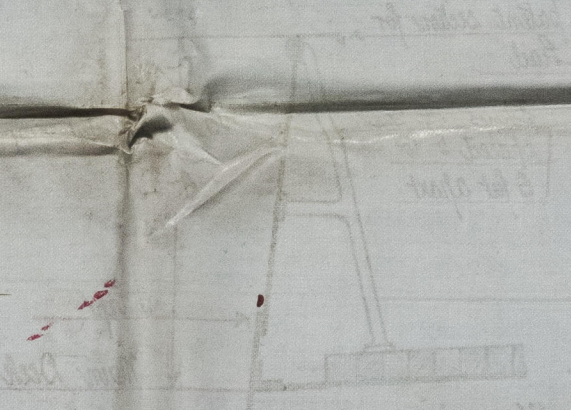

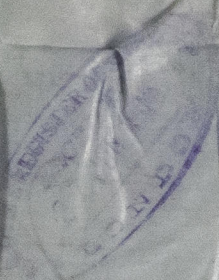

© 2020

Lloyd's Register
Foundation