


PROFILE

Scale. $\frac{1}{8} = \text{One Foot.}$

Scale: 1" = 0' x 100' "

To. Class 100 A.1 AT. Lloyds SPAR. DECK. RULE

MOULDED DIMENSIONS 54'0" x 61'0" x 37'3"

 


Profile
Barclay Curle No. No 71

Mr. Moore

GLASGOW Report No 27199

W1539 - 0008

5. 3. 08
2. 5. 08
9. 15. 05
15. 10. 04
17. 10. 04
17. 10. 04
30. 8. 07

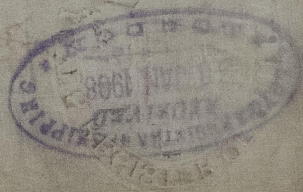

Barclay Curle
1771



© 2021

W1539 - 0008
Lloyd's Register
Foundation

Loyds. Profile
471.

W1539-0008

Lloyd's Register
Foundation