


MOULDED · DIMENSIONS · 540' x 61' x 37'-3" TO SPAR DECK

SCALE $\frac{1}{2}" = \text{ONE FOOT}$

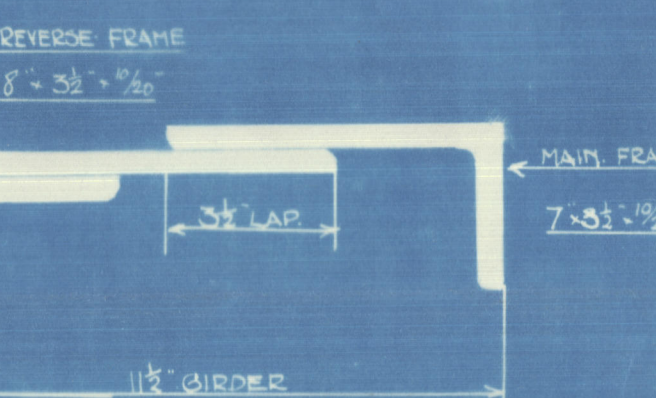


Loni L.S. Morea.

cls. 27199.

Copy as Built.

M/S

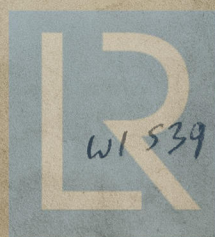

© 2021

W1539-0014

Lloyd's Register
Foundation

Barday Curle & Co


471

S/S. "MOREA"

Midship Section

GLASGOW

Report. No. 27199

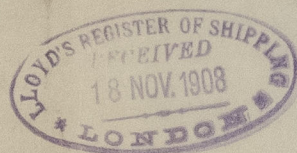

W1539-0014



© 2021

Lloyd's Register
Foundation