

Nº 24.

MIDSHIP SECTION.

SCALE 1/4" = 1 FOOT.

DIMENSIONS - 363'-0" x 52'-2 3/4" EX x 33'-6" MP TO SHELTER DECK.
TO CLASS AT LLOYDS + 100 A1 SHELTER DECK WITH FREEBOARD.

LLOYDS NUMERALS

LENGTH	363'-0"
BREADTH	52'-0"
DEPTH	24'-1 1/8"
+ 1 1/8" FOR 8'-3" TWEEN DECK S	
B + D = 52' + 25' 5" = 77' 5" TRANS N°	
L (S + D = 363' + 77' 5" = 440' 5" LONG. N°	
DEPTH MP TO UPPER DN	24'-0"
C D B RULE	3'-5"
	21'-4"
1/2 DIFF RULE & ACTUAL TANK KNEE HT.	8 1/2"
DEPTH 2	20'-7 1/2"
1/2 SHELTER DECK	10'-8 1/2"

GRADES

KEEL STEM 3 STERNPOST	265/28200
FRAMES 1 1/8" 18"	20/21
DOUBLE BOTTOM	265/28000
BEAMS	50/55
SHELL	5 1/2"/29200
TOP SIDES	27 1/2"/28500 PL 10/11
EQUIPMENT	273/28200

FOR PILLARS SEE PROFILE

EQUIPMENT


NUMERAL		28105
SHELTER DECK	363' x 8' x 3/4"	2178
POOLE	605' x 8' x 3/4"	417
HOUSES	150'0' x 8' x 1/2"	636

RULE EQUIPMENT

- 1 BOWER ANCHOR 55 1/4 CWTB STOCKLESS
- 1 BOWER ANCHOR 55 3/4 CWTB STOCKLESS
- 1 BOWER ANCHOR 48 CWTB STOCKLESS
- 1 STREAM 18 CWTB STOCKLESS EX STOCK
- 1 KEDGE 6 1/2 CWTB STOCKLESS EX STOCK
- 270 FATHOMS 2 1/2" DIA BTUD
- 80 " 4 1/2" STEEL WIRE STREAM
- 120 " 4 1/2" TOWLINE
- 4 10 DO. " HAWKERS & HARPS.

CENTRE KEELSON

TOP BARS 3 1/2" x 3/4" x 45' FOR 1 1/2 L TO 40' AT ENDS. 38' IN B.S.
C.K. 4 1/2" 50' TO 40' 50' IN B.S.
BUTTS TREBLE RIVT ALL FOR & AFT.
VERT LUGS 5 1/2" x 5 1/2" SINGLE 1/2 LEN.
2 1/2" x 2 1/2" SINGLE AT ENDS.
BOTTOM BARS 4 1/2" x 4 1/2" x 38' - 54'

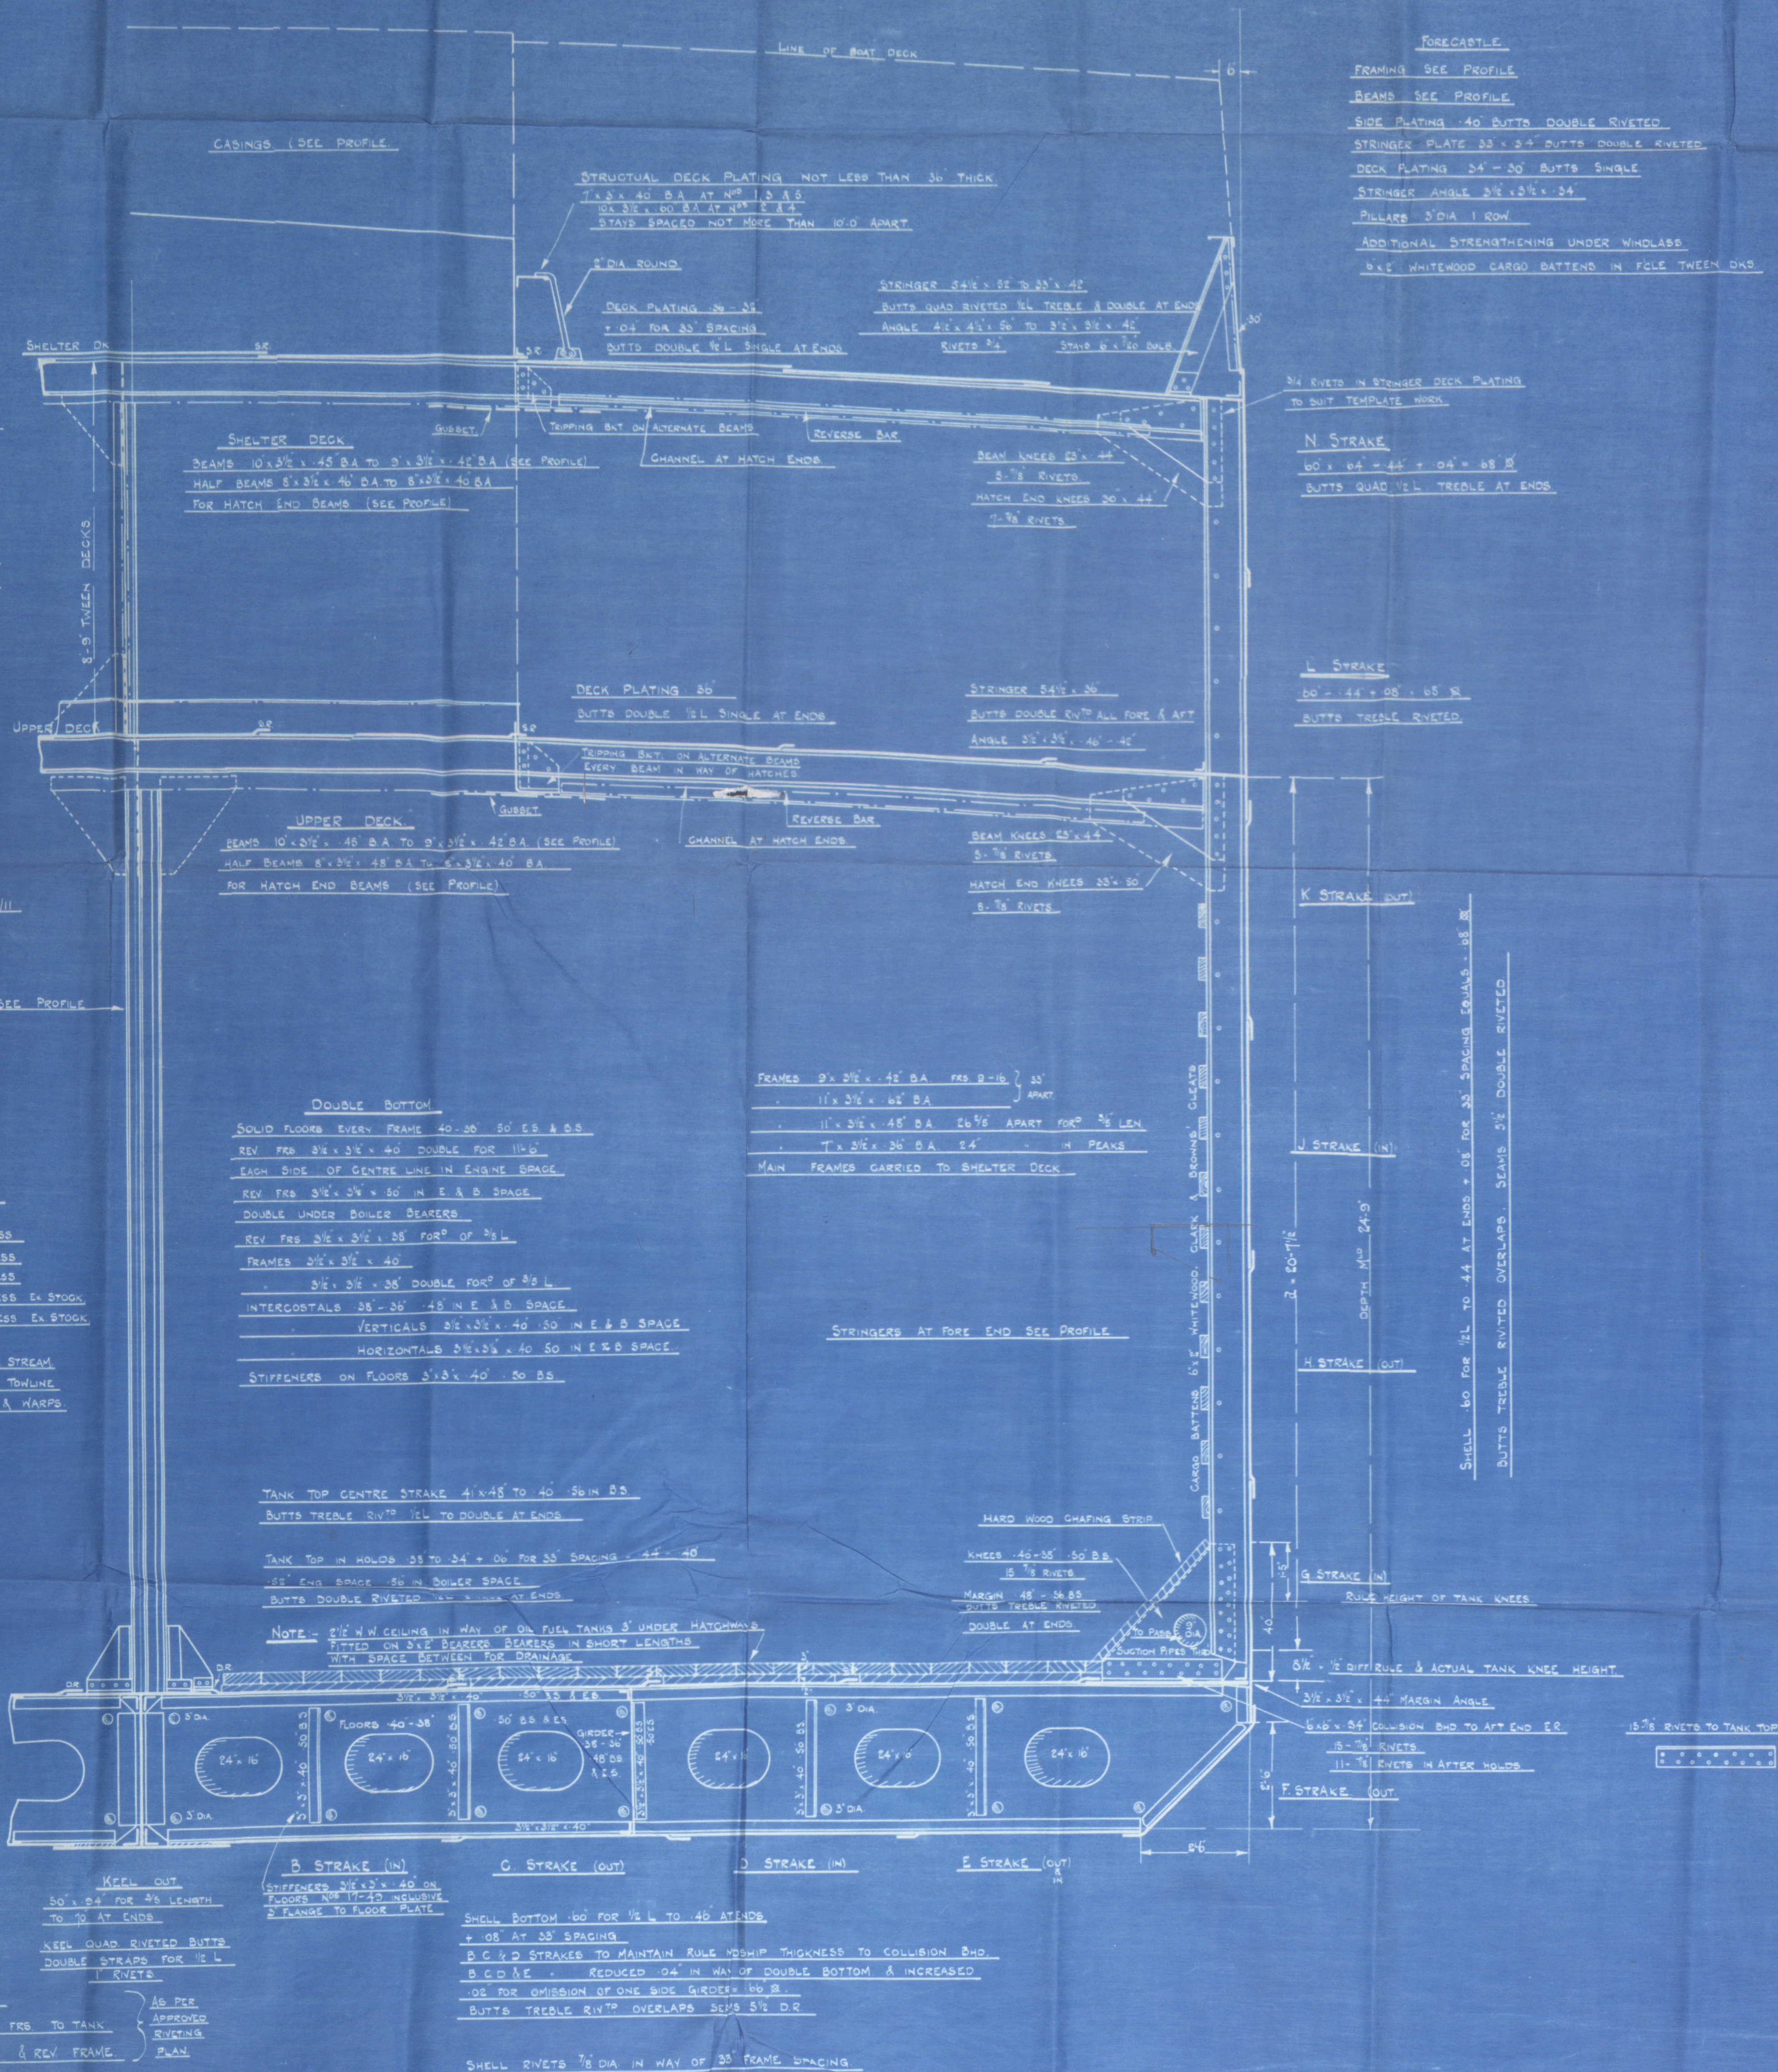

1.500
2706
30.8/21

W154-0137

Friend James S B Ld

Nº 24

MIDSHIP. SECTION
(AS. BUILT)

S. S. Junisiana

On 26. Rpt. 18 11 28

n. n. Champerois



© 2019

Lloyd's Register
Foundation

W154-0137