

30.8.00
21.9.00 (no 525 1524)

Hatch 6.8 x 10.0



Hatch 20.10 x 17.0

Hatch 27.1 x 17.0

Hatch 20.10 x 15.0

Hatch 27.1 x 17.0

Hatch 22.11 x 17.0

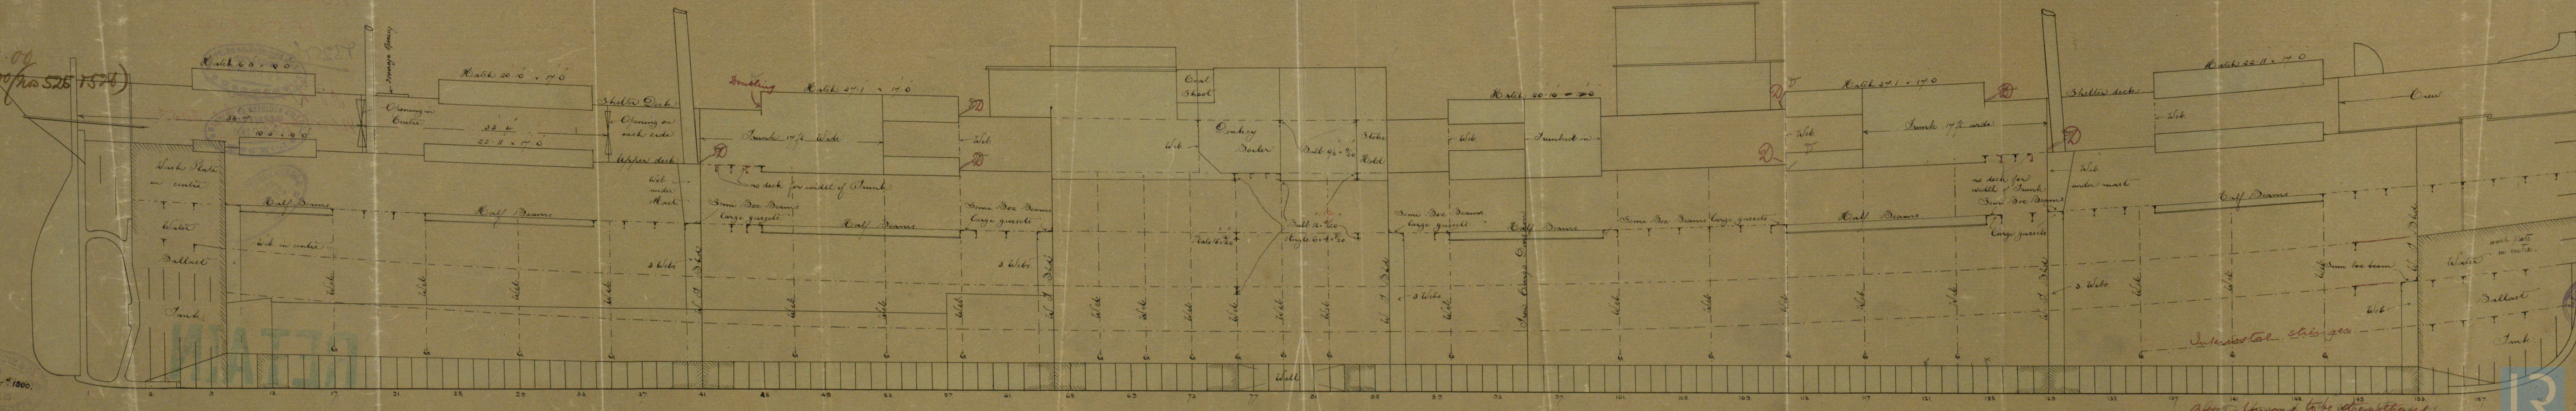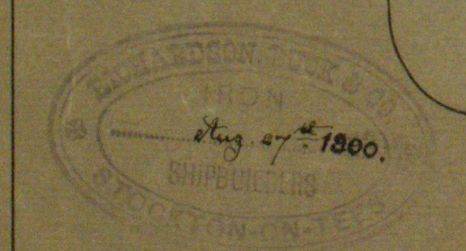

Scale 5 = 1 Foot

Station forward to be strengthened
Per Circular No 1012. also has 525 1524
W 1540-0112
Appd 20.9.00




2021
16-524
16-520
Register
Foundation

*Amend Profile
Richardson Duckter*


no 520 15-24

952546

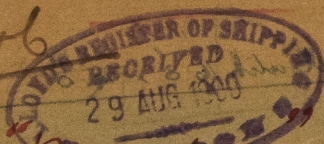

P.S. Works

no 10 reported 3053

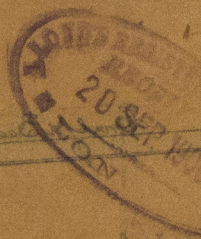

RETAIN



Lloyd's Register
Foundation

W1540-0112