
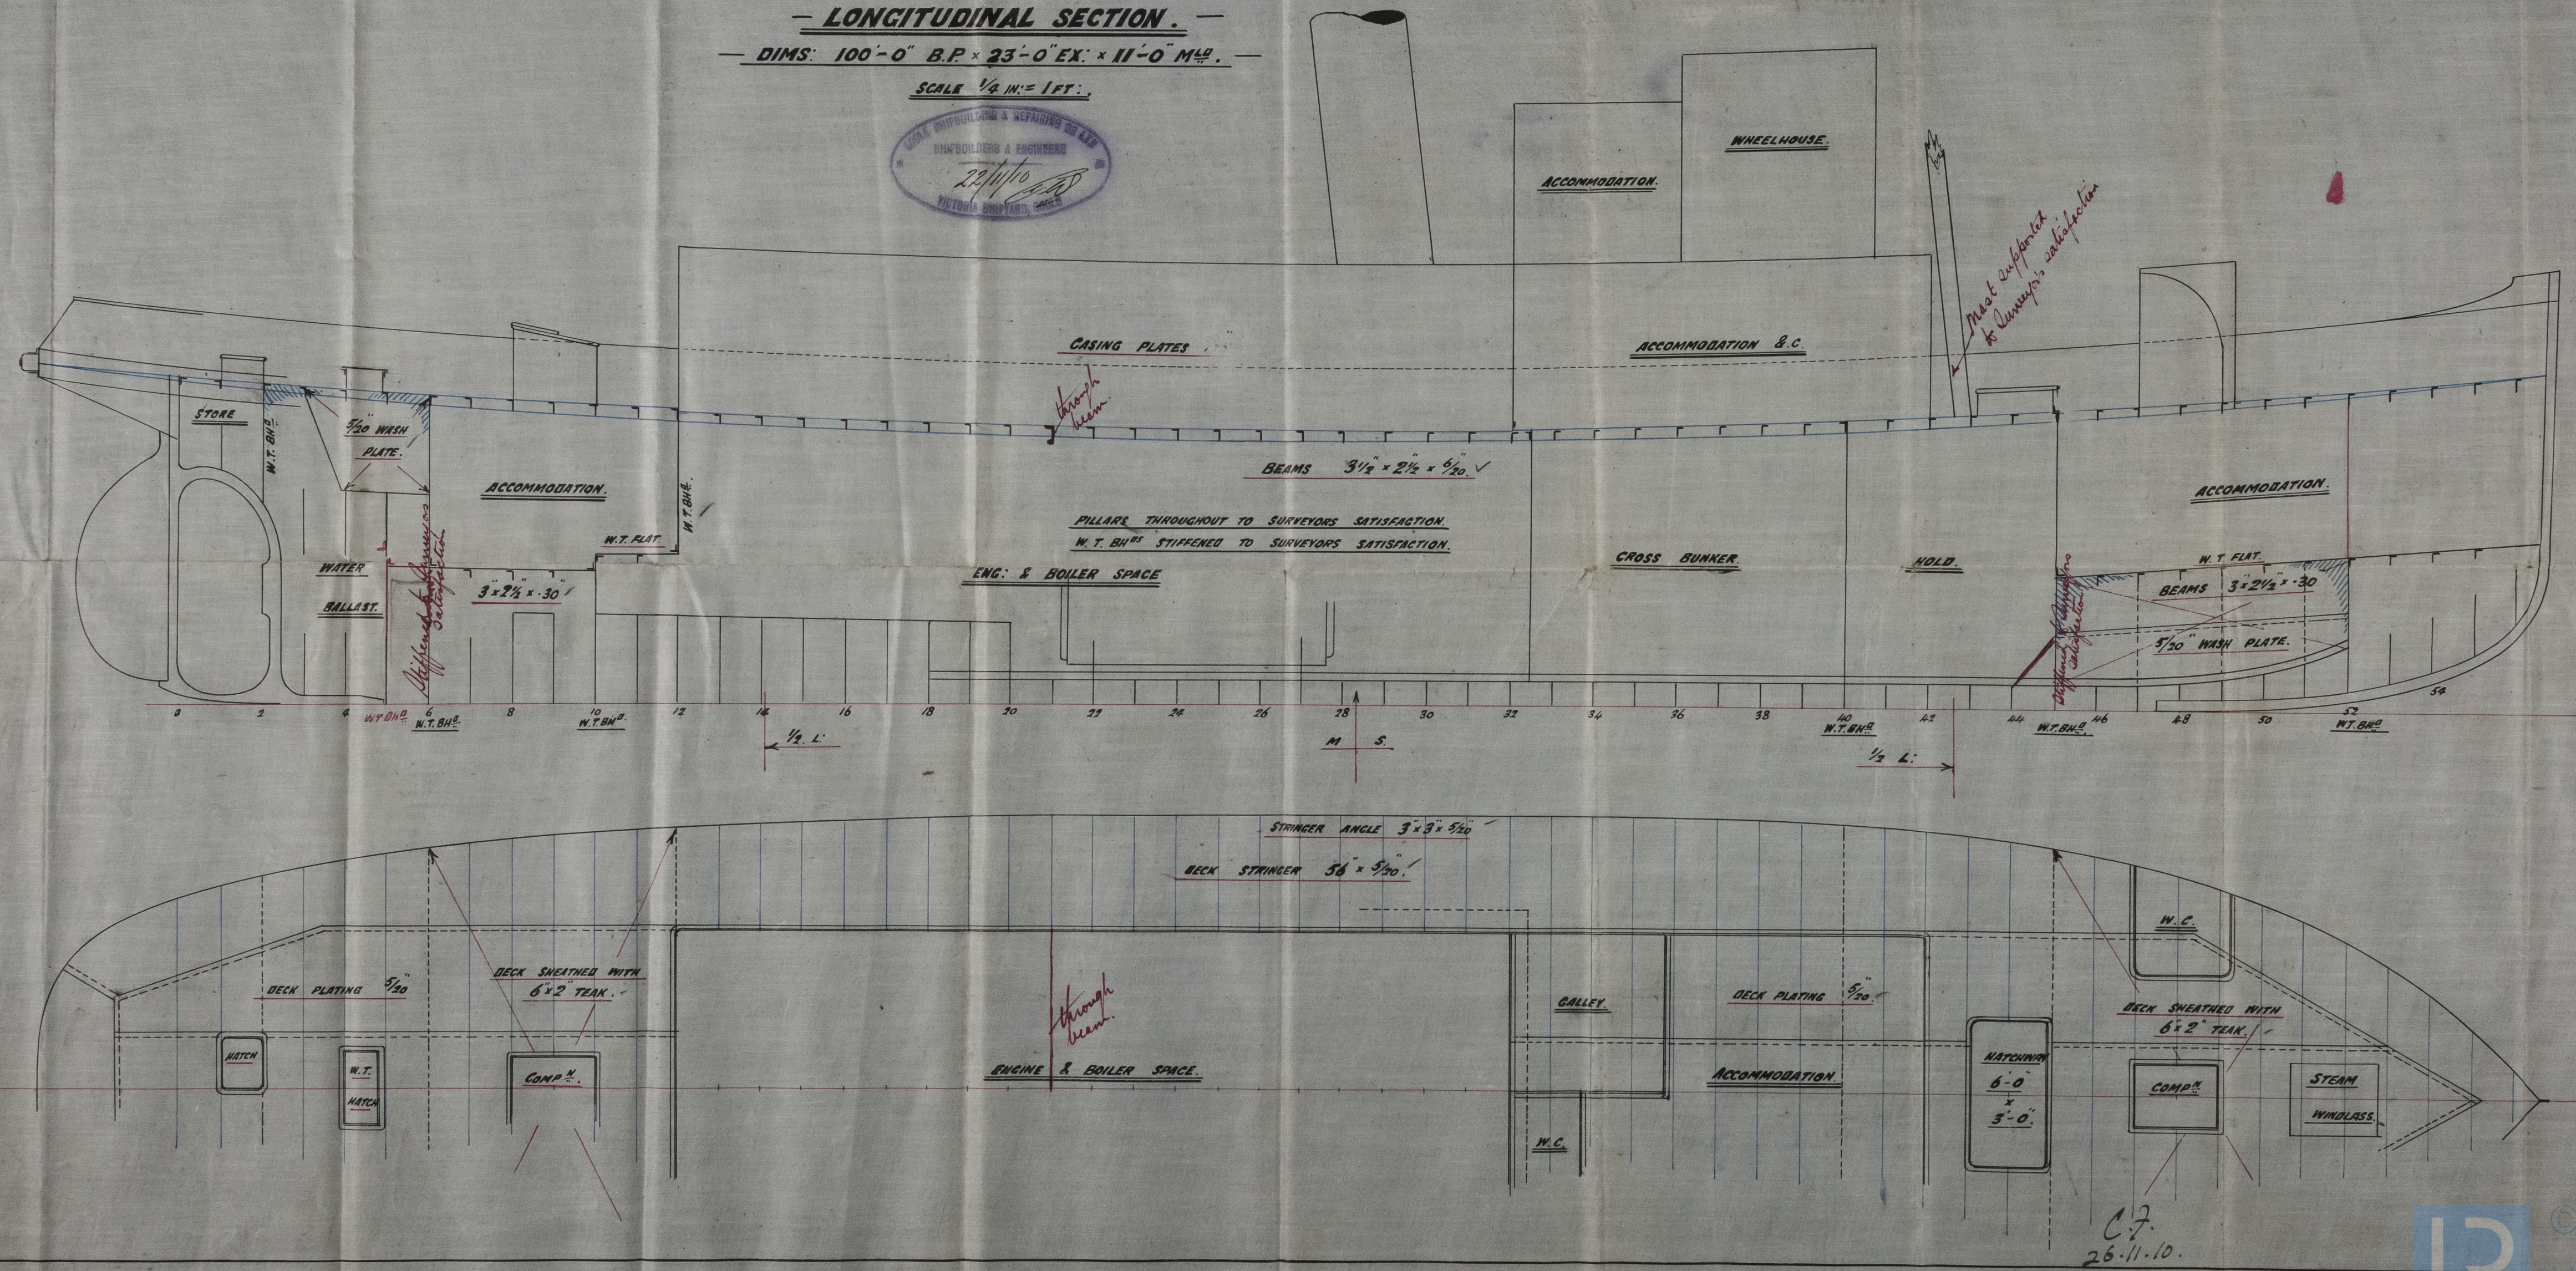


26.11.10
31.12.10
28.1.11

S. S. Nos 141 & 142.
LONGITUDINAL SECTION.
DIMS: 100'-0" B.P. x 23'-0" EX. x 11'-0" MLD.

SCALE 1/4" IN. = 1 FT.

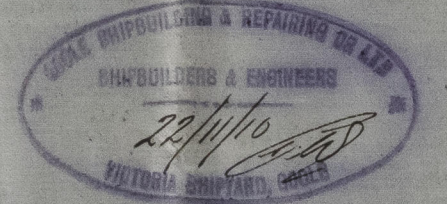


Boole S + R.C.: 22.

Nº 141 v 2

Profile & Deck Plan.

S/S Marenco

Hull Rpt n. 24 207

 

© 2020

Lloyd's Register
Foundation

W1 541-0113