

Numeral.
 26.11.10 22.9 + 11.0 = 33.9 Transverse No.
 31.12.10 33.9 x 100 = 3390 Longitudinal No.
 28.1.11

$L/D = 9.09$

Nos 141-2.

Midship Section
of
Steel Screw Tugs.

Dims: 100'-0" x 23'-0" x 11'-0".


Scale 1/2" = 1 Foot.

To Class — A1. Lloyds. (Coasting Tug.)



Equipment.


1 Anchor	4 3/4" cuts ex stock.	✓
1 "	4 1/4" " " "	✓
1 "	2 1/2 " " "	✓
90 Fathoms	15/16" Glad Link Chain	✓
60 "	5 1/2" Hawser	✓
60 "	4" Warp.	✓

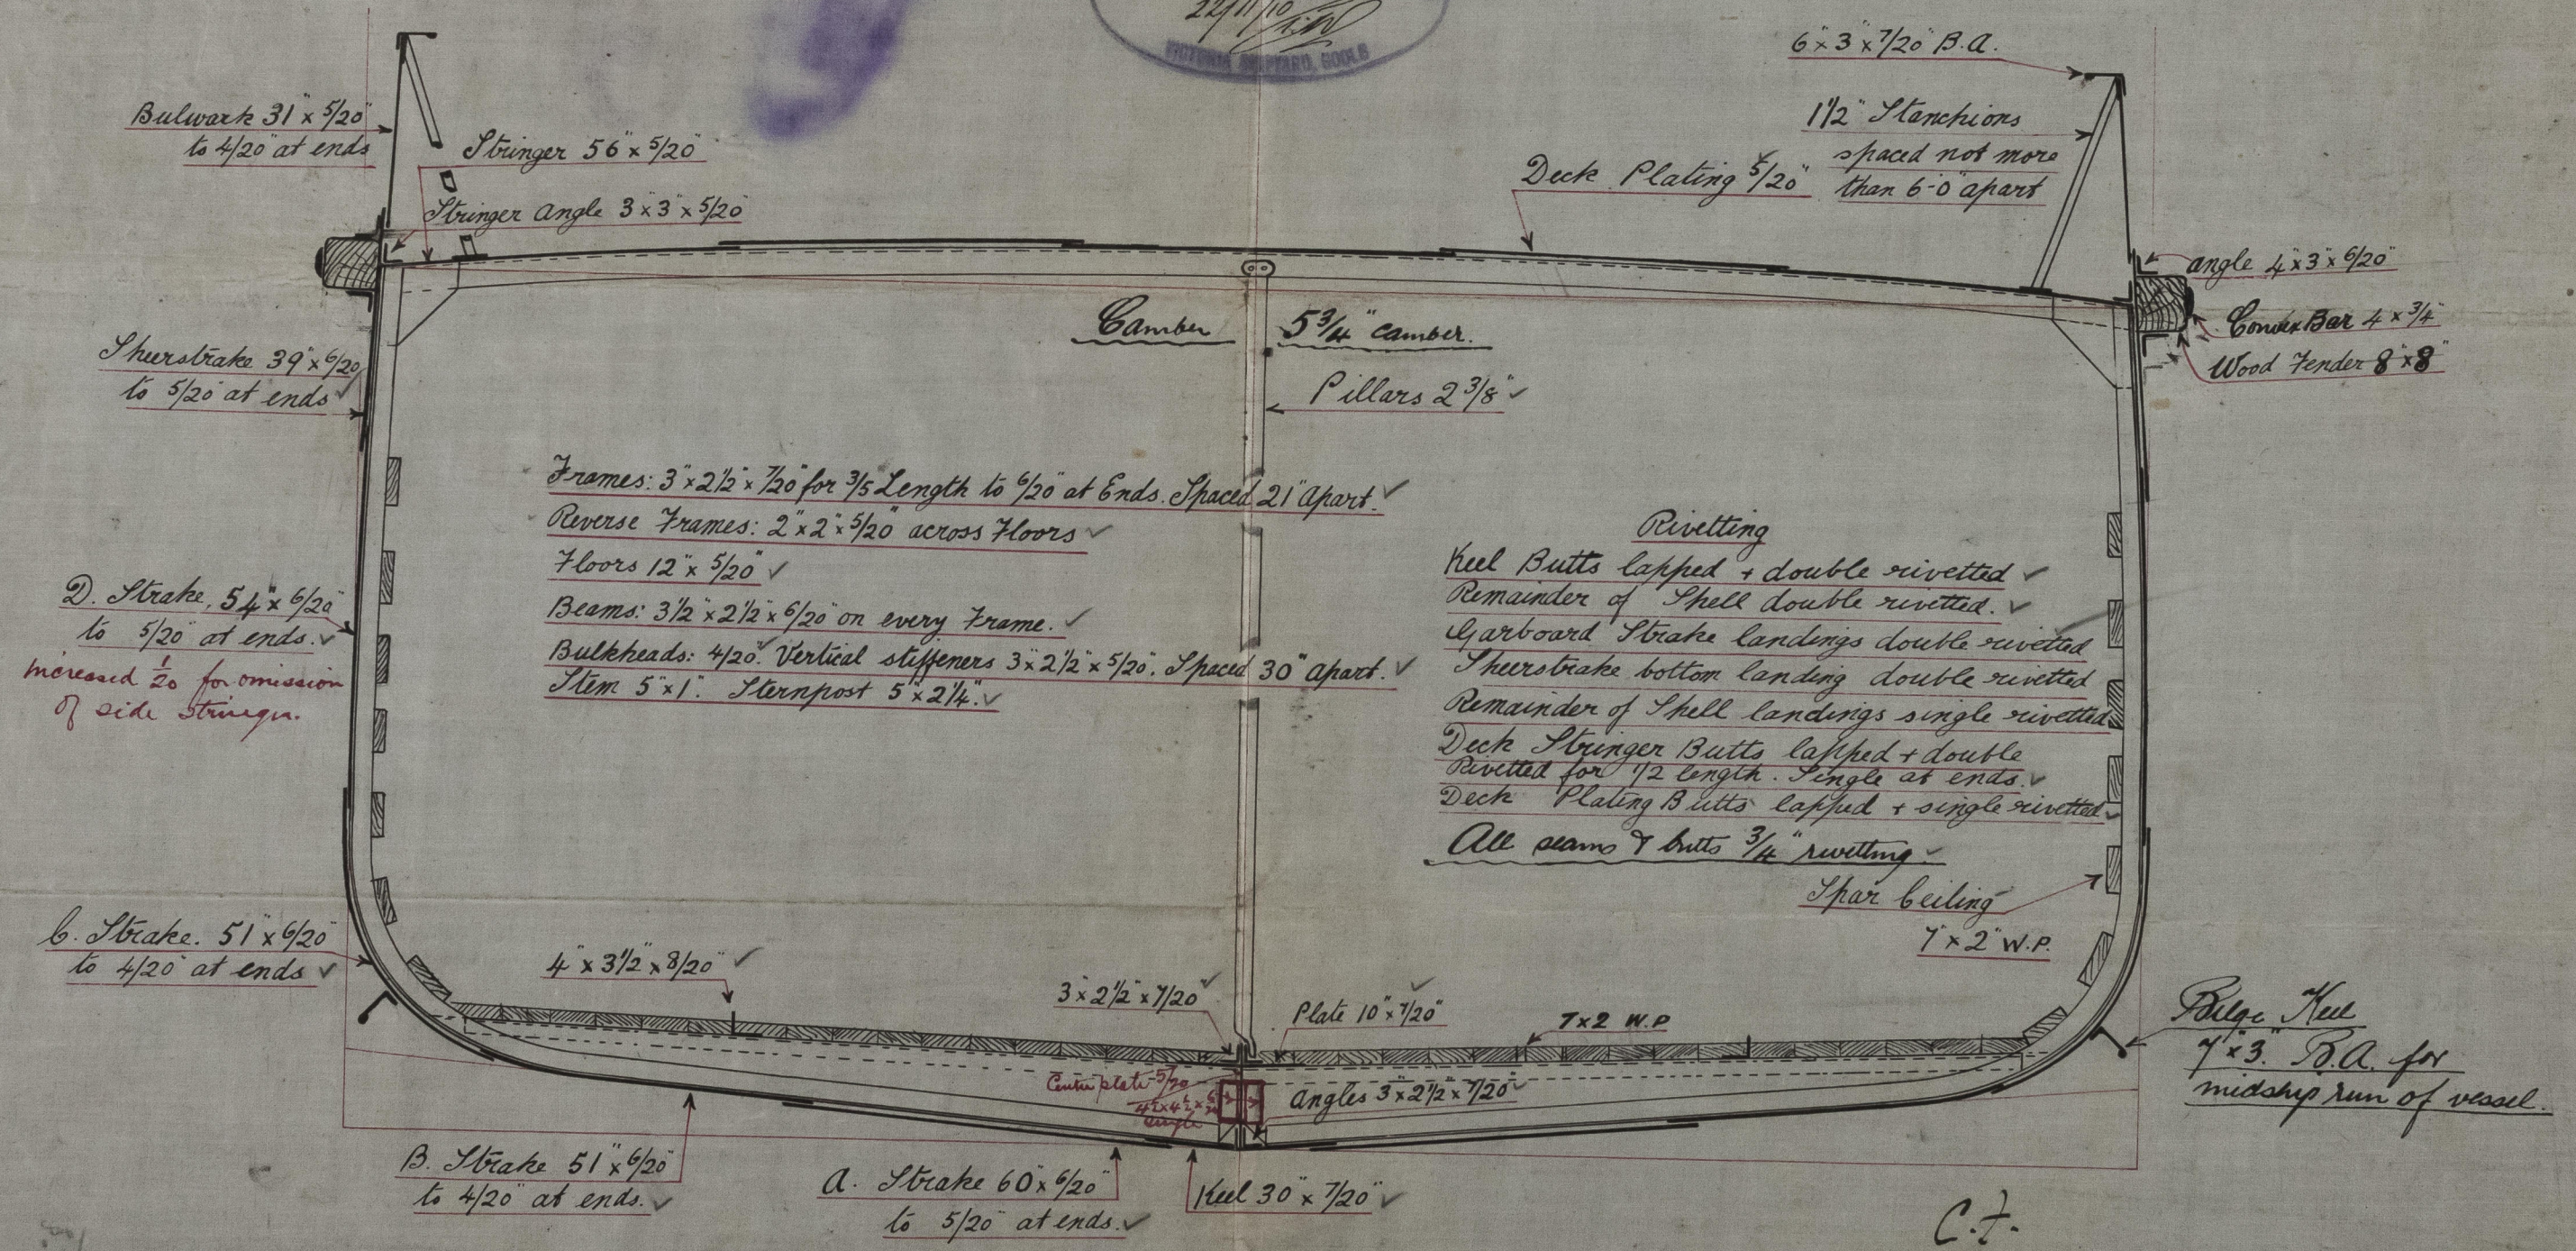

C.F.
 26.11.10.

Escoe S. & R. C. Co. Sta
No 141 + 2

Midship Section.
S/S Moreno
Hull Report No.

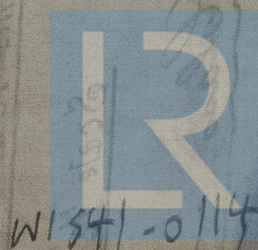

© 2020

Lloyd's Register
Foundation