

NOS 309 & 310

MIDSHIP SECTION


STEEL TWIN SCREW STEAMER

M.L.D. DIMS. 450' x 52' x 33' 6" UPPER DECK.


TO CLASS 100 AT LLOYD'S - 3 DECK RULE

SCALE 1/2" = 1'-0"

also 81172
(app'd 29.05)

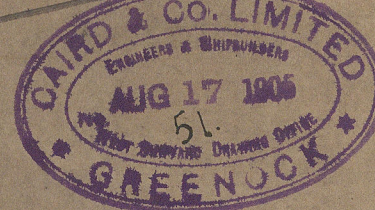

24.8.05
2.9.05 (N^o 31172)
18.9.05
12.10.05
24.10.05
15.6.06

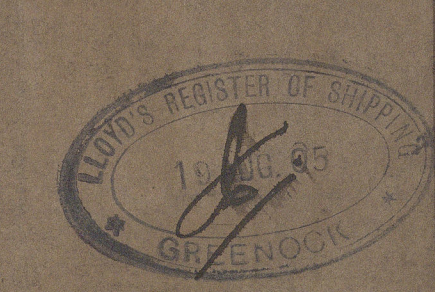

July Namur


31192

M/S

No 310 : T. S. S. "Namur"
Grk report No 14835

No 311. "NYANZA"
GRK RPT No 14904.

No 312. T. S. S. "Nore"
GRK RPT No 14953

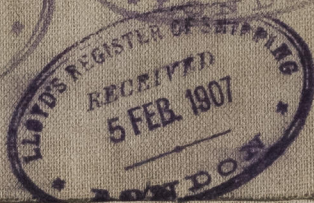

© 2020

W1541-0139

Lloyd's Register
Foundation

NAMUR



© 2020

Lloyd's Register
Foundation