


28.8.06

PROFILE & DECK PLAN.



STEEL SCREW TRAWLER.
No 390

Dim: 96-0 x 20-6 x 11-0 HOLD 11-7" M³

SCALE 1/4" = ONE FOOT.

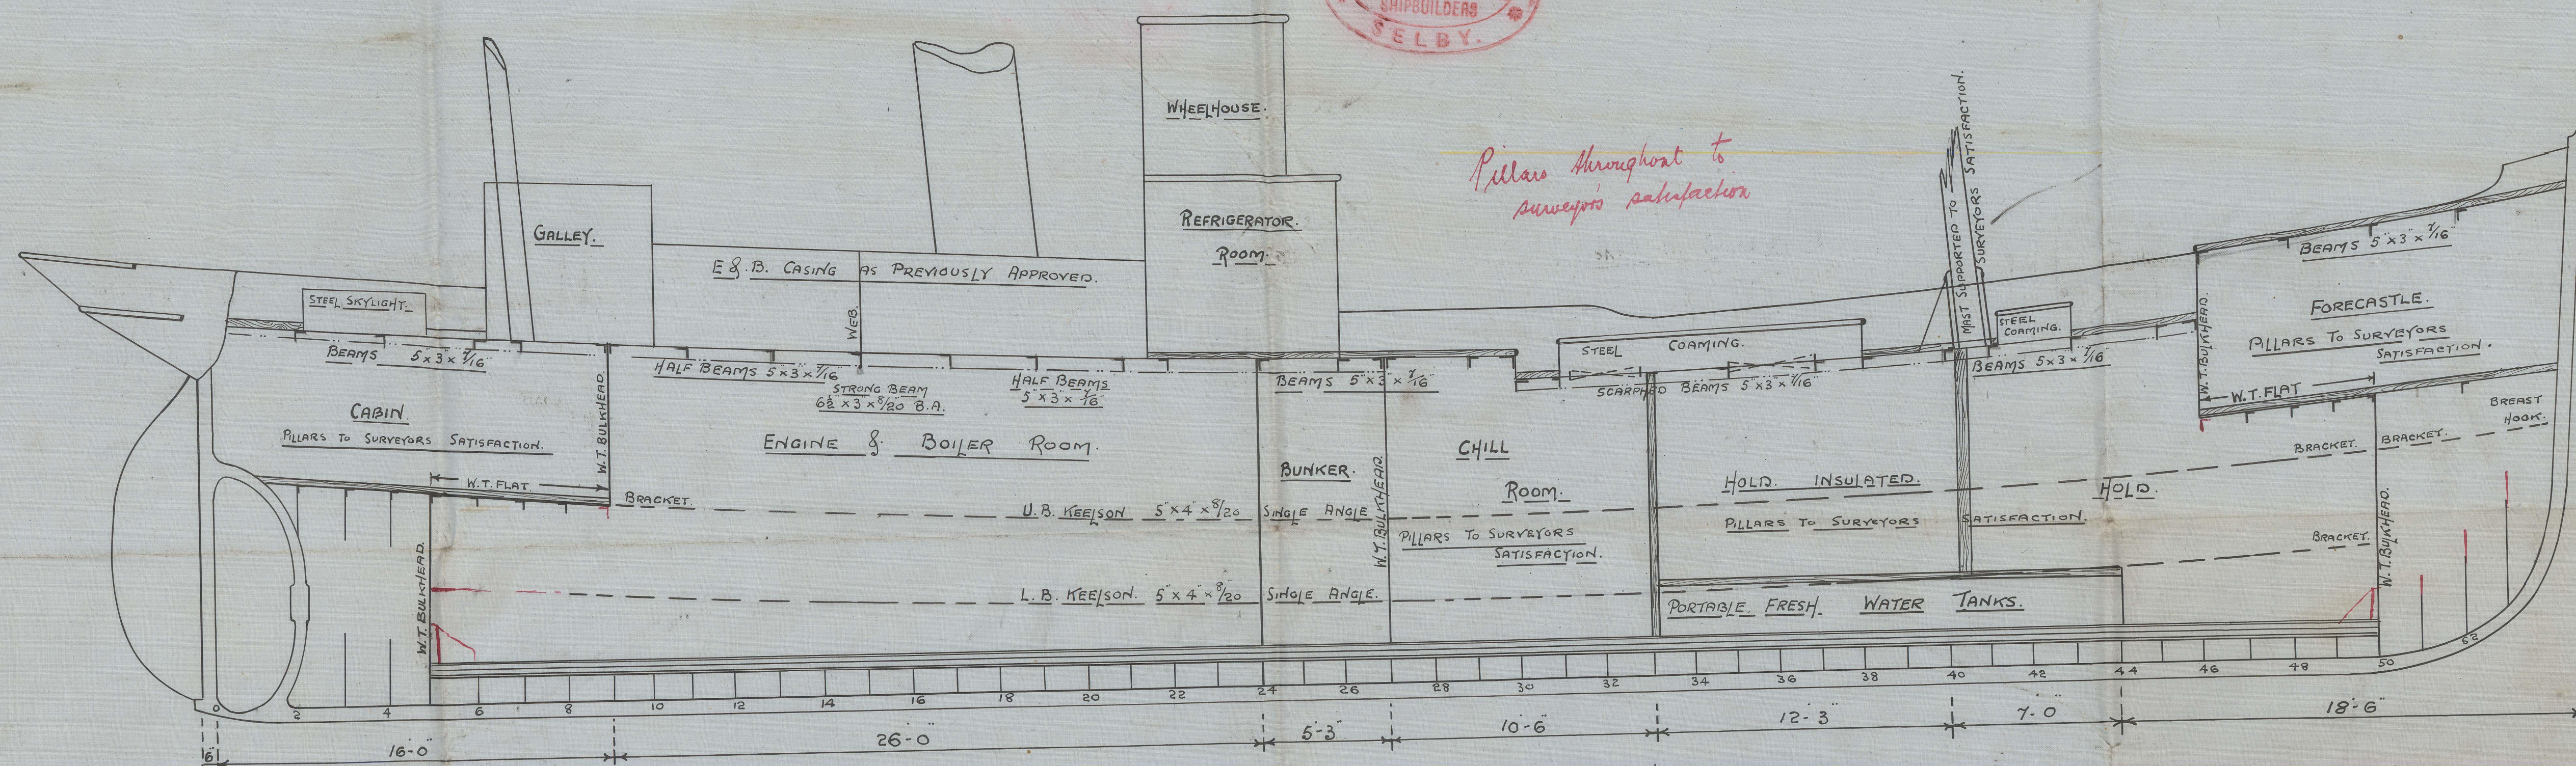

*Pillars throughout to
surveyors satisfaction*

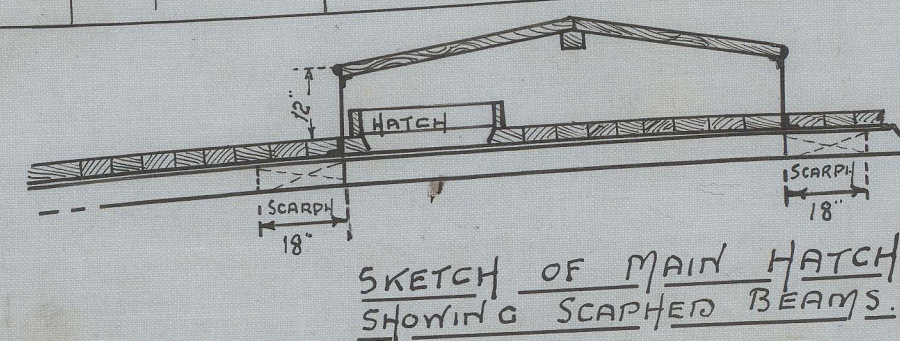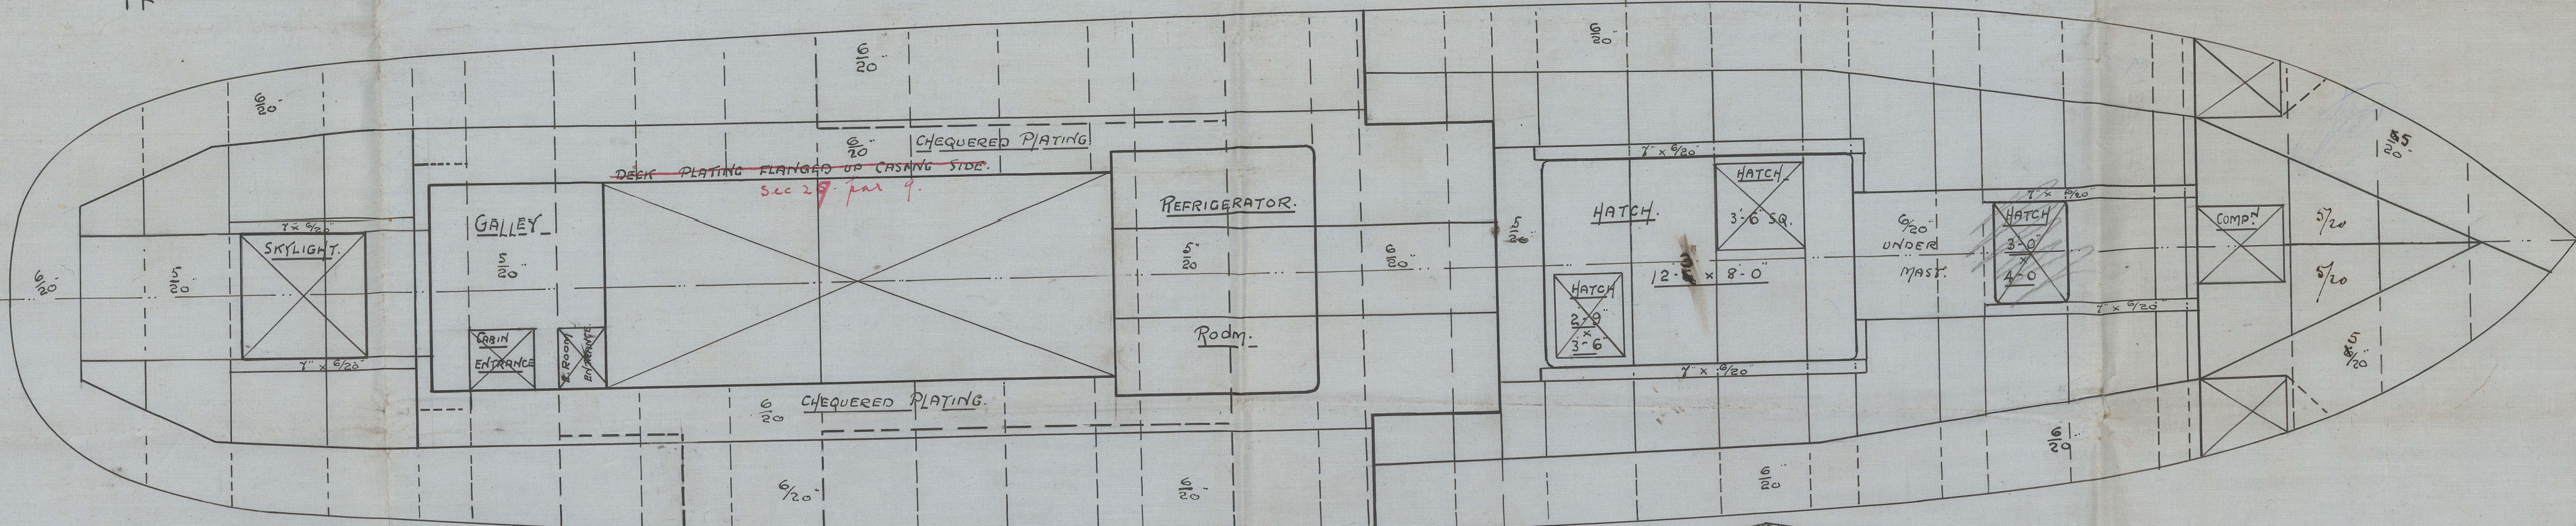

c.b.
28.8.06


arsw
27.8.06

W1541-20213


Cochran & Sons

No 390

Profile & Decks
of "Kora Nieuw"

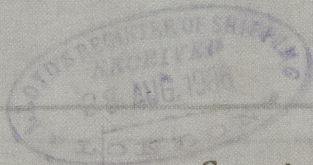

Hull Report No. 18676

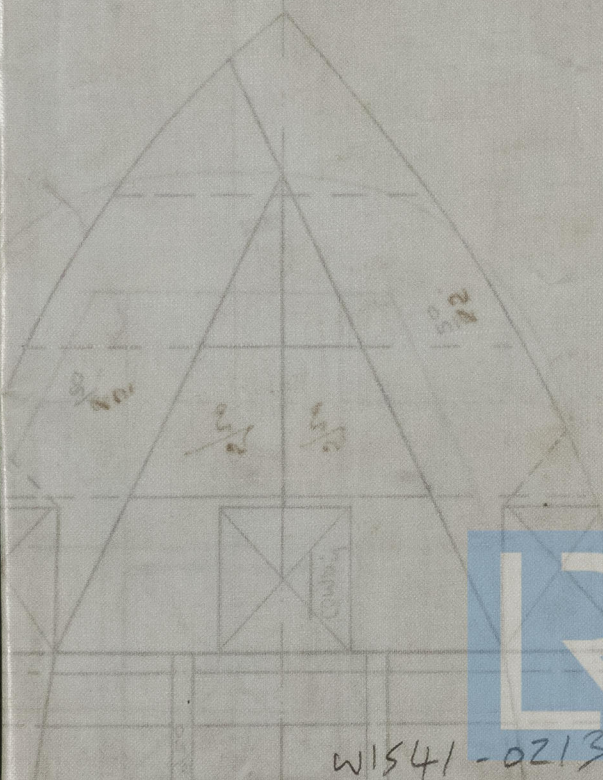

© 2020

Lloyd's Register
Foundation

W1541-0213