


Received at

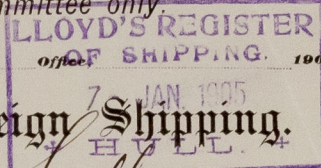

Lloyd's Register of British & Foreign Shipping.

(Report on Vessel No. 16118

Port

Hull
of Nautilus

No. 8226

SHIP FORGINGS OR CASTINGS.

I have to report that the undermentioned Iron or Steel Forgings or Castings,
manufactured by Emerson, Walker & Co.

of Dunston

for the Vessel No. 334, being built

by Cochran & Sons

of Hull

have been inspected by me as set forth below, and found to be, so far as can be seen,

Sound

Mark on Forgings.

Lloyd's

No. 2635-N.

W.C.

W. Campbell



Newcastle 3/1/05.

	STERN FRAME.	RUDDER FRAME.	STEM.
Material*	Scrap.	Scrap	
How made	Forged & Smithed	Forged & Smithed	
Dimensions	6x3	4 1/2	
Progress on Inspection	Smithing	Smithing	

SKETCHES OF FRAMES SHOWING POSITION AND DESCRIPTION OF WELDS OF FORGINGS, OR PARTICULARS OF TESTS APPLIED TO CASTINGS.



Welds.

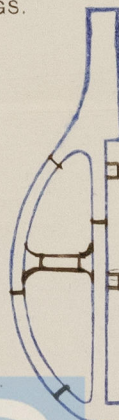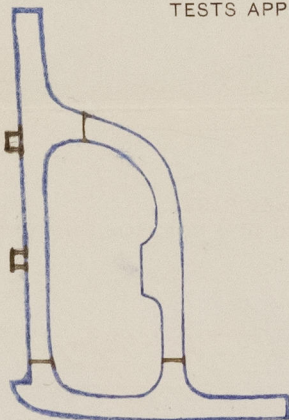

Fee (if any chargeable) £

To be paid at

* If of Iron, state whether scrap or puddled Iron.