

6. 10. 04  
8. 10. 04

# MIDSHIP SECTION

Steel Screw Trawler

No 334.

Dimensions 120'0" x 22'0" x 13'10" Moulded


Scale 1/2" = 1'00"

To be classed 100.A1 Steam Trawler


Raised Quarter 10' 48'3" x 12'

Forecastle 20'0" x 12'

6+13 Casings as previously approved.

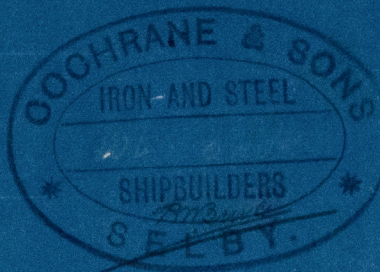

Section 112 Way of  
Raised Q<sup>r</sup> Deck.

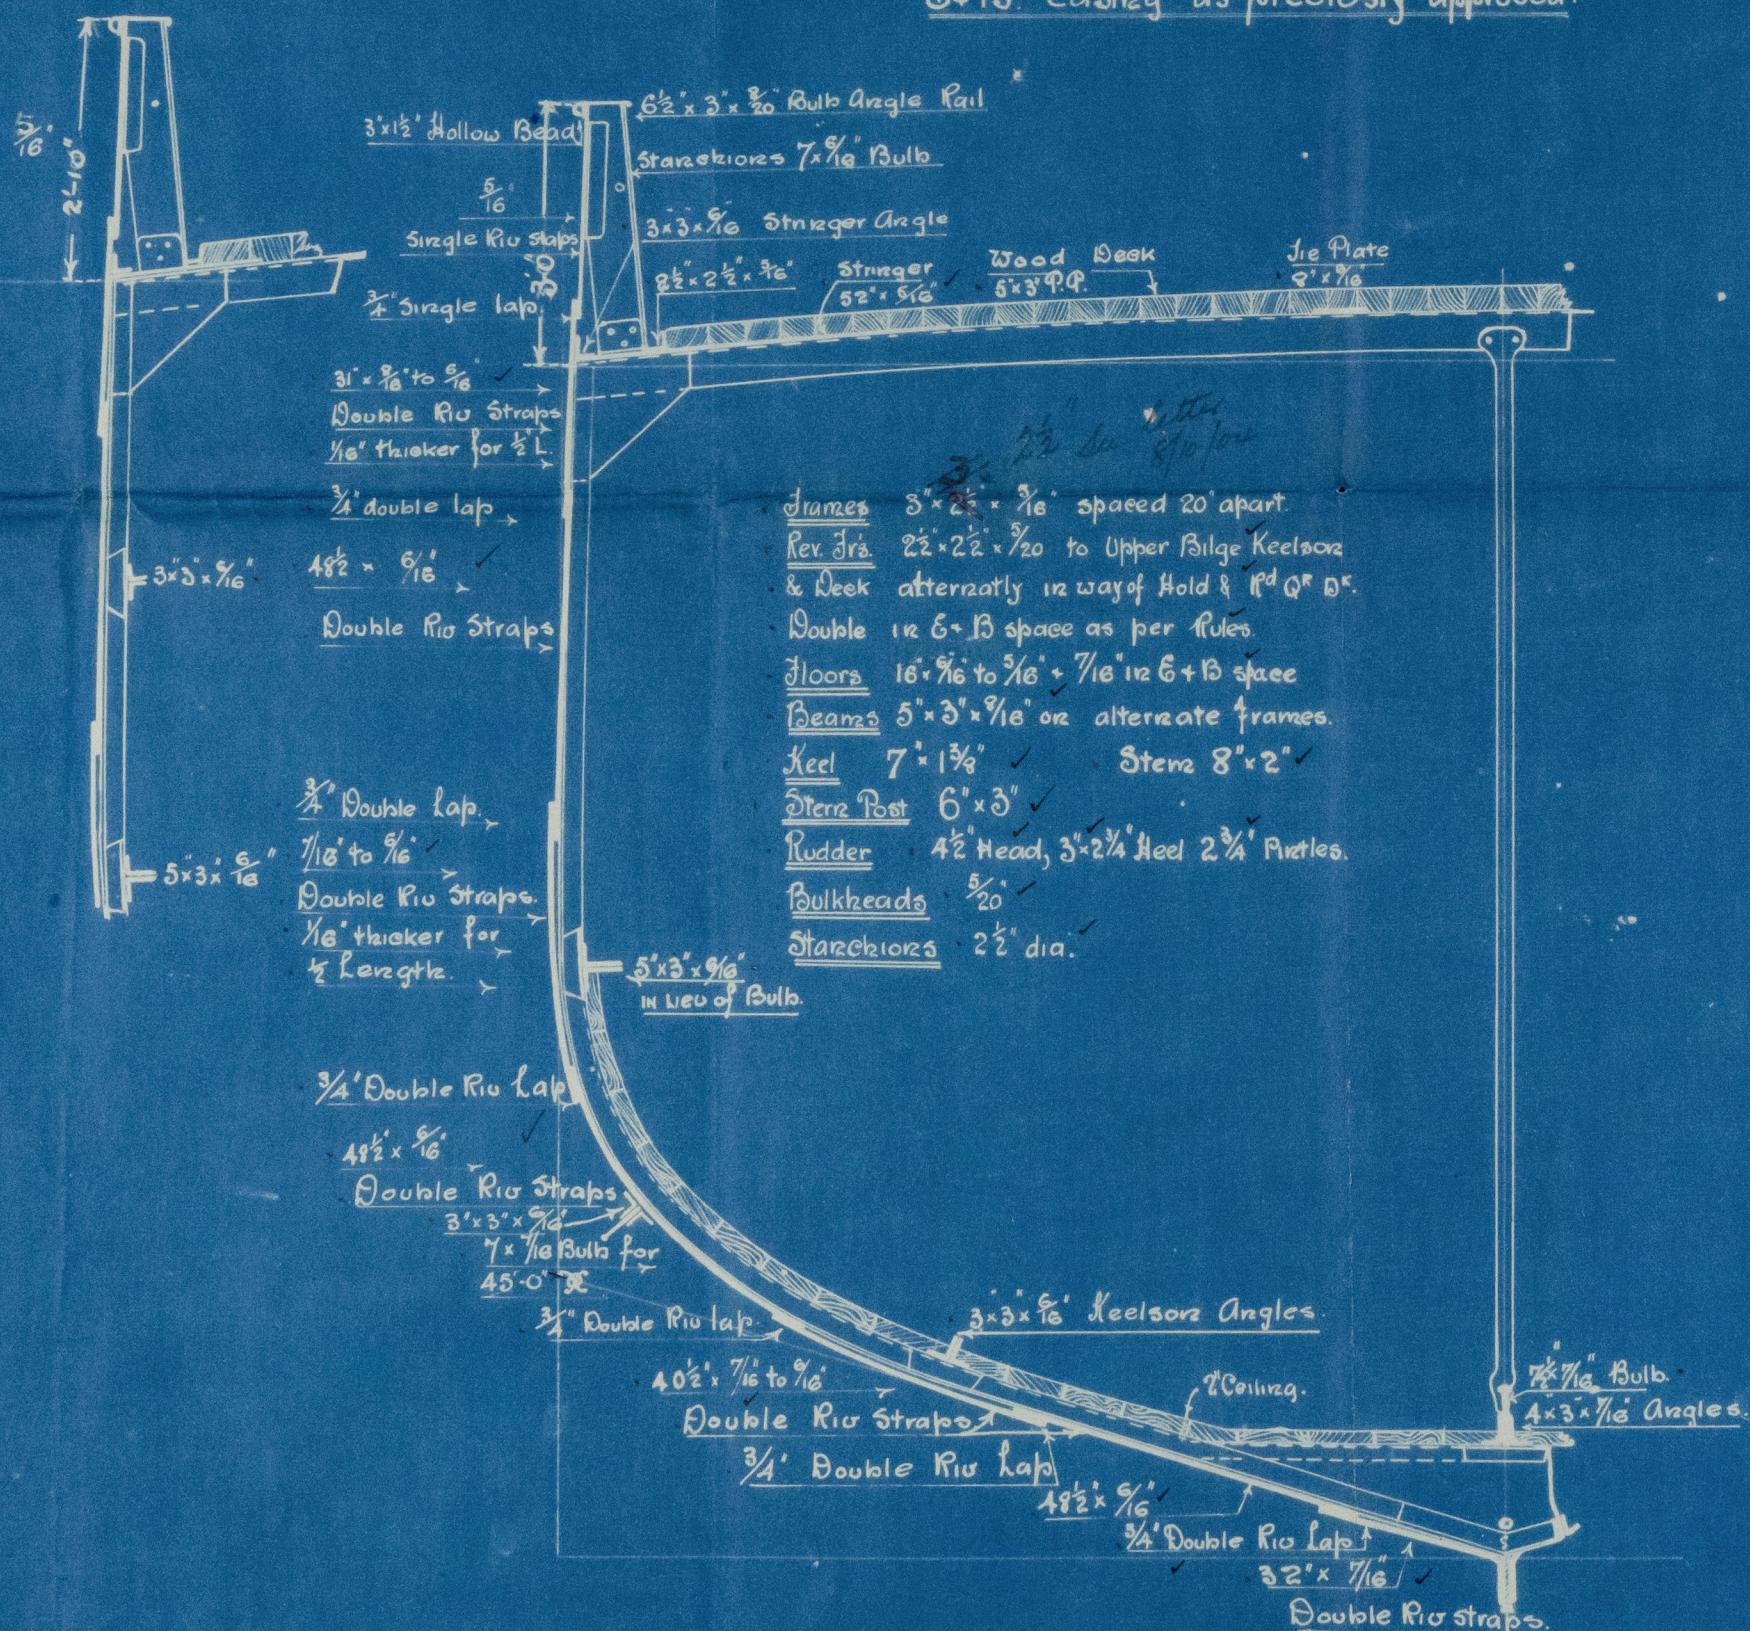

Breadths to Length 5.4

Depths to Length 8.3

1/2 Breadth Mid 10.95

1/2 Girth 20.83

Depth as per Rule 14.29

46.07 = 1<sup>st</sup> 12°


Length as per Rule 118.9

5486.72 = 2<sup>nd</sup> 12°

## Equipment

- 1<sup>st</sup> Bower ex stock 5 1/2 cwt.
- 2<sup>nd</sup> " " 5 "
- 3<sup>rd</sup> " " 2 1/2 "
- 105 fathoms 1 1/2" short Link Cable.
- 60 " 6" Hawser
- 60 " 4 1/2" Warp.

COCHRANE & SONS  
SHIPBUILDERS  
SELBY  
YORKSHIRE.

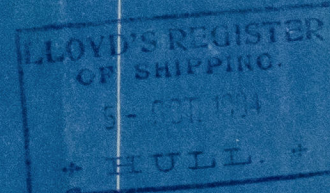

C.B.  
6. 10. 04.





Lloyd's Register  
Foundation



Midship Section


Cochrane & Sons

- No 334 1/2 -

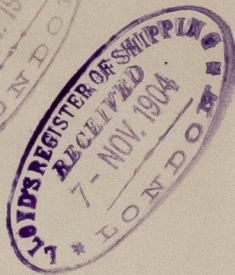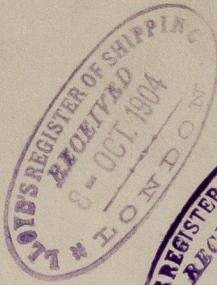

per Vantulus

Hull Report No 16118

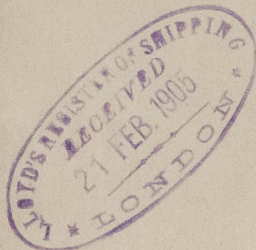

W1542-0141