

***MIDSHIP SECTION.***

## STEEL SCREW TRAWLER.

DIMS 140'-0" BP x 23'-0" MLD x 13'-0" MLD

TO CLASS 100 A.I. LLOYDS - FOR FISHING PURPOSES.

SCALE  $\frac{1}{2}$  IN = 1 FT.

EQUIPMENT N° 6301.

**NUMERALS.**

HALF GIRTH ----- 20.38

" **BREADTH**----- 11.5.

DEPTH ----- 13.5.

1<sup>ST</sup> No ----- 45.38

LENGTH ----- 138.87.

2<sup>ND</sup> No. ----- 6301.52

$$\frac{1}{2} = 10.2$$

1 ANCHOR-----6 1/4 CWT EX STOCK

1 - - - - -  $5\frac{3}{4}$  " " "


/ " ———— 3 1/4 " " "

✓

60 " ~~2~~ FLEX: STEEL WIRE

60 " 1 3/4 " " "

2 with owner's consent  
to steel wire.

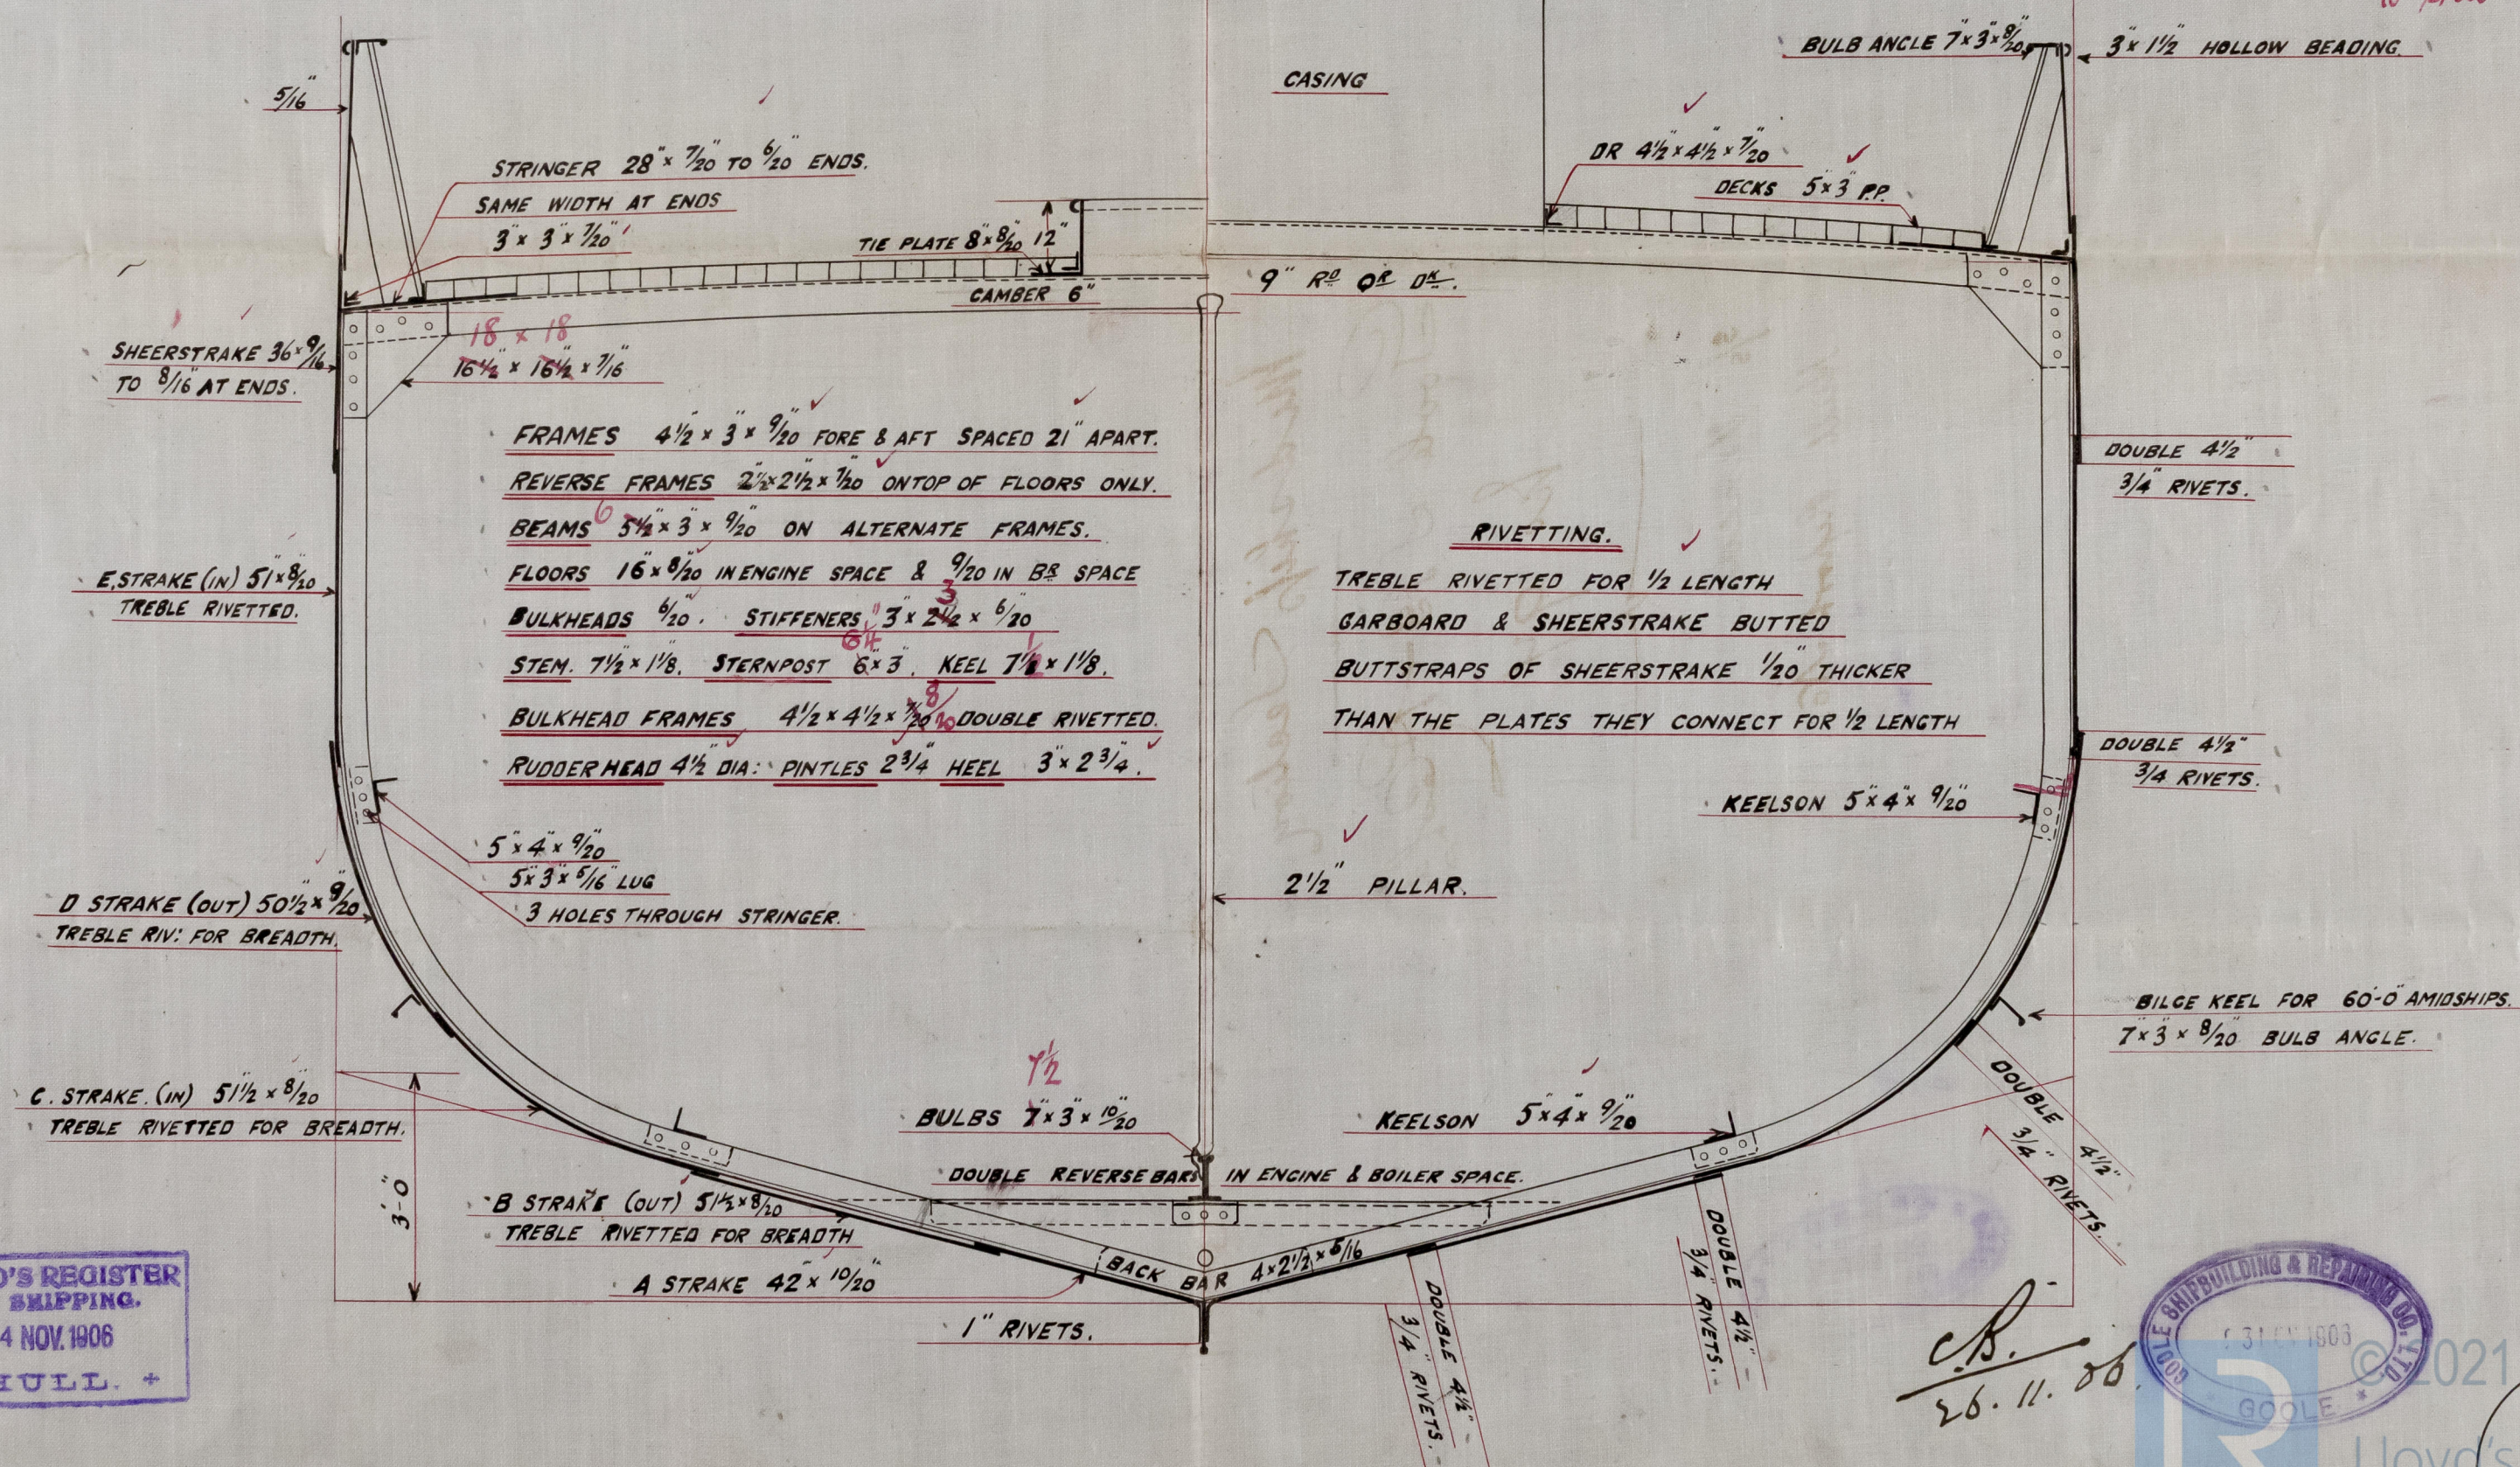

LLOYD'S REGISTER  
OF SHIPPING.  
24 NOV. 1906  
+ HULL. +



Lloyd's Register  
Foundation



Midship Section  
Goole S B + R Cold  
No 94

s/s 'Vined'  
Hull Report No.

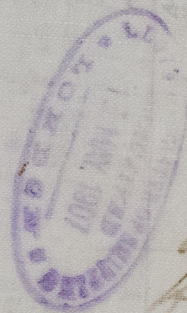

© 2021

Lloyd's Register  
Foundation