



76.11.06

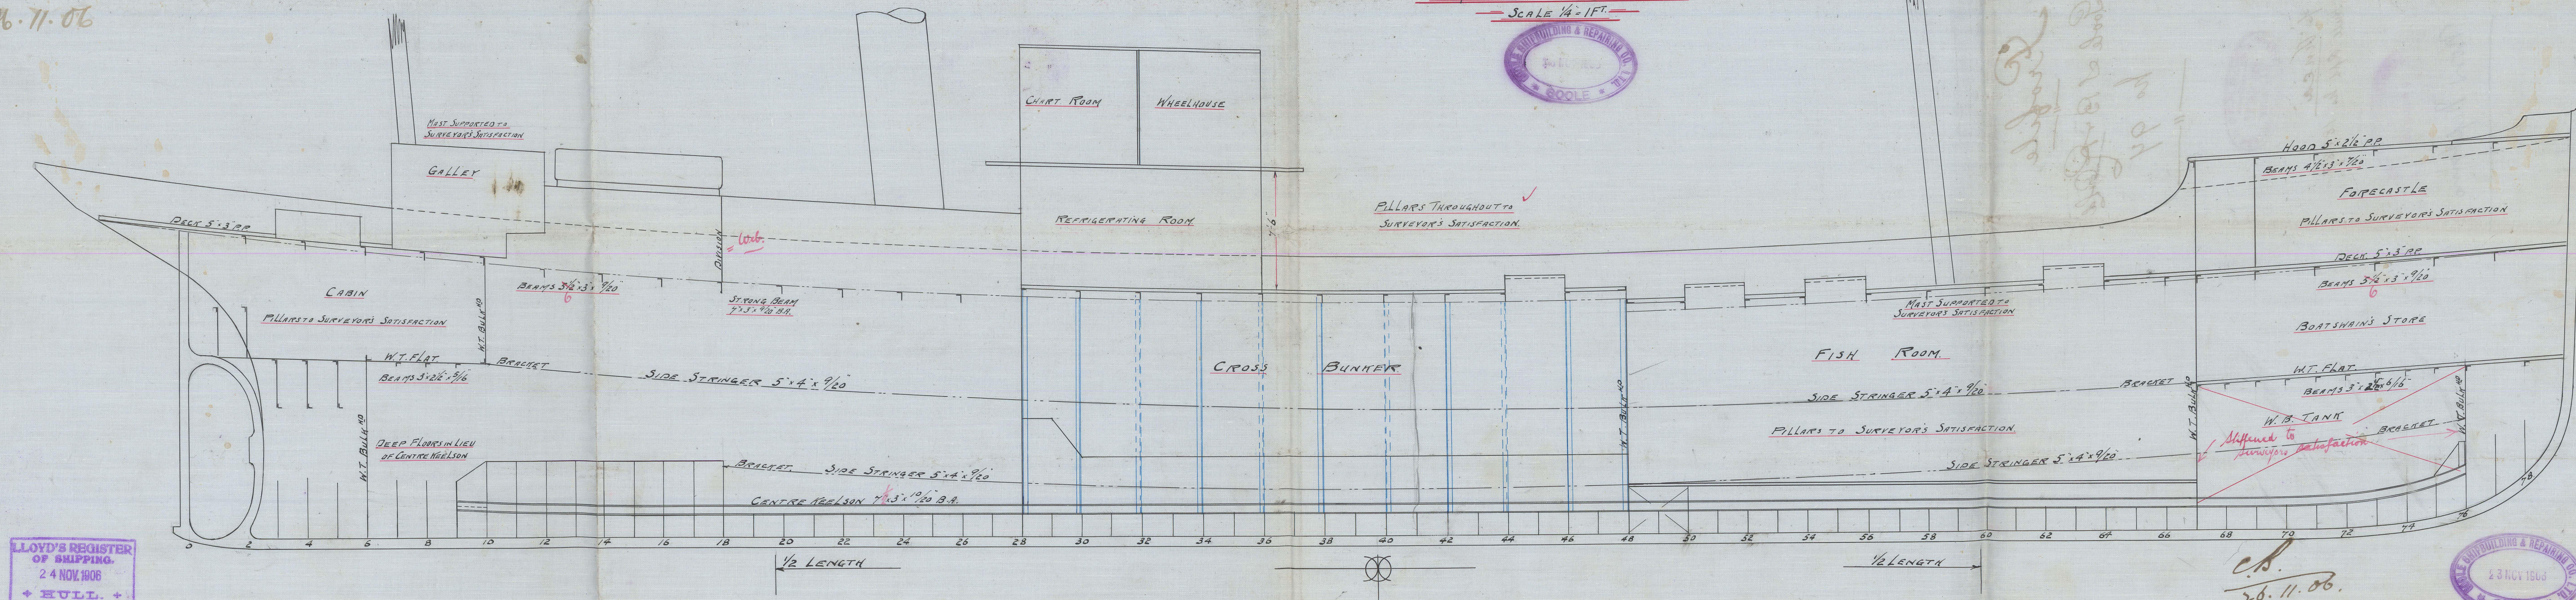

SSN°97
ELEVATION.
DIMS: 140'0" BP x 23'0" MD x 13'0" MD
SCALE 1/4" = 1 FT.

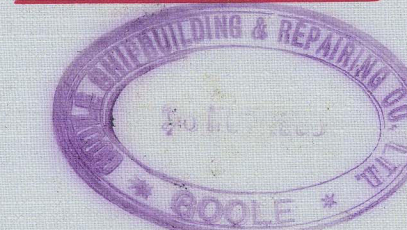

LLOYD'S REGISTER
OF SHIPPING
24 NOV. 1906
HULL.




Profile

Goole S B & R Gold
no 94

of Venca

Hull Rpt no. 18987

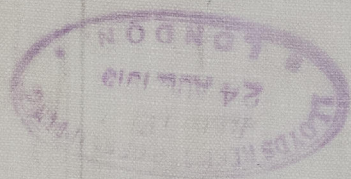

Now kept in



© 2021

Lloyd's Register
Foundation

W1543-0026