





Earle's D & C Co. Ltd.

No 571 & 572.

Amended.





Midship Section

s/s Normandy

Hull Report No 22786

s/s Brittany

Hull Report No 22923

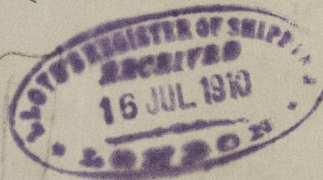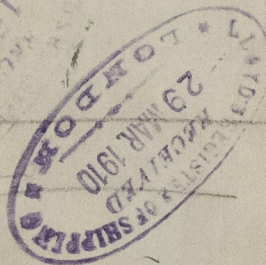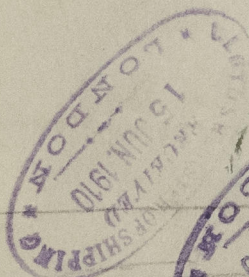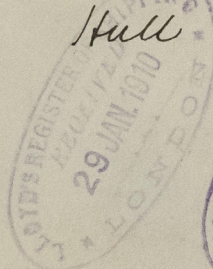

© 2020

Lloyd's Register  
Foundation

W1544-0097