
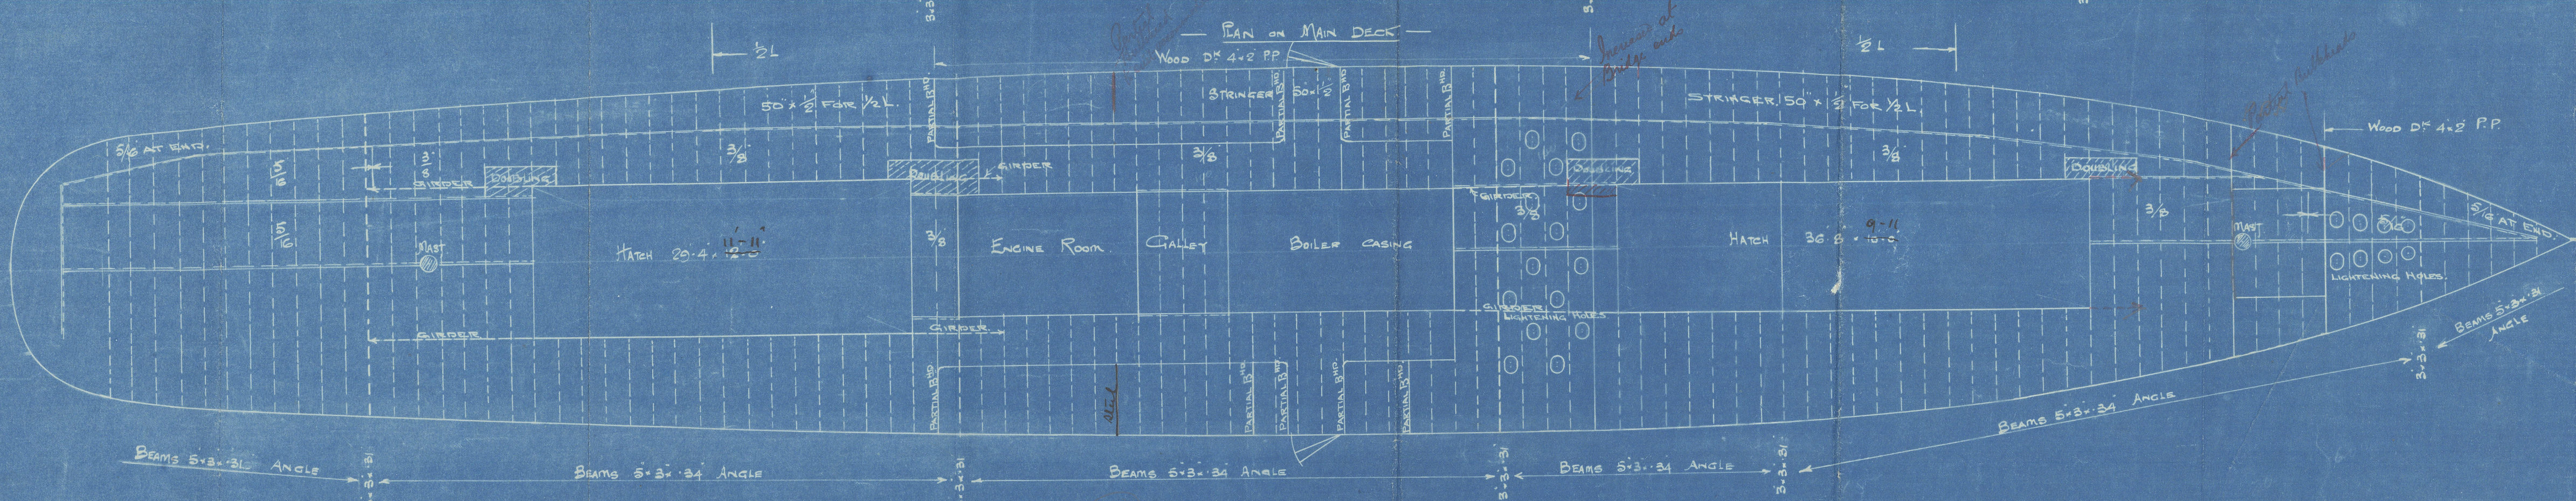
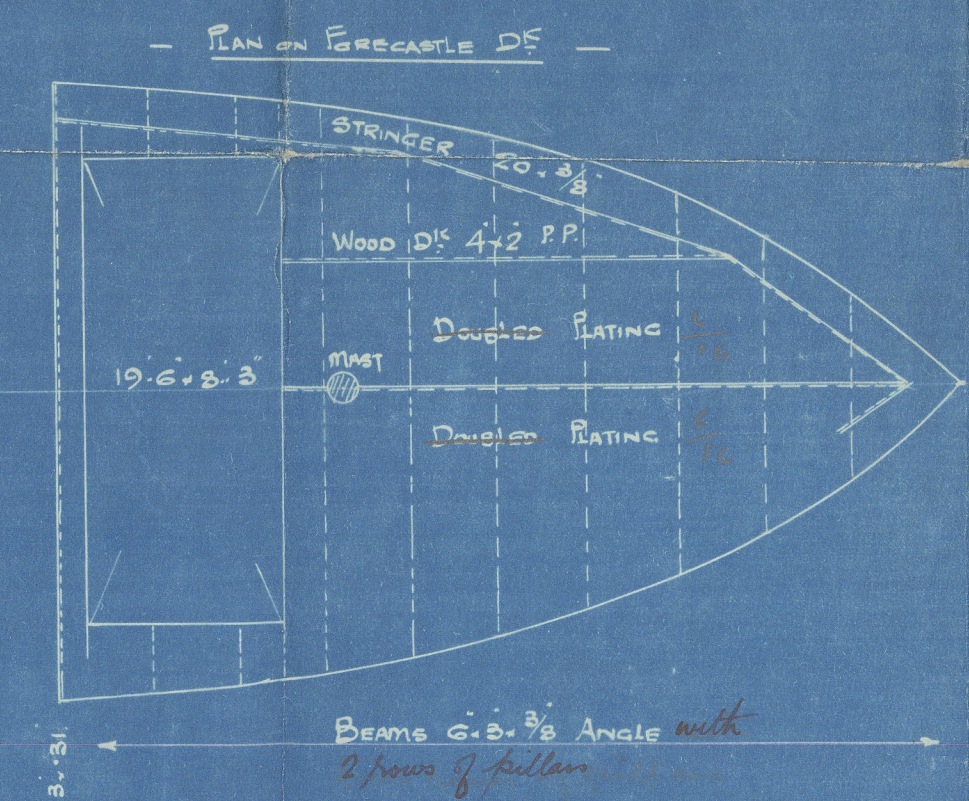
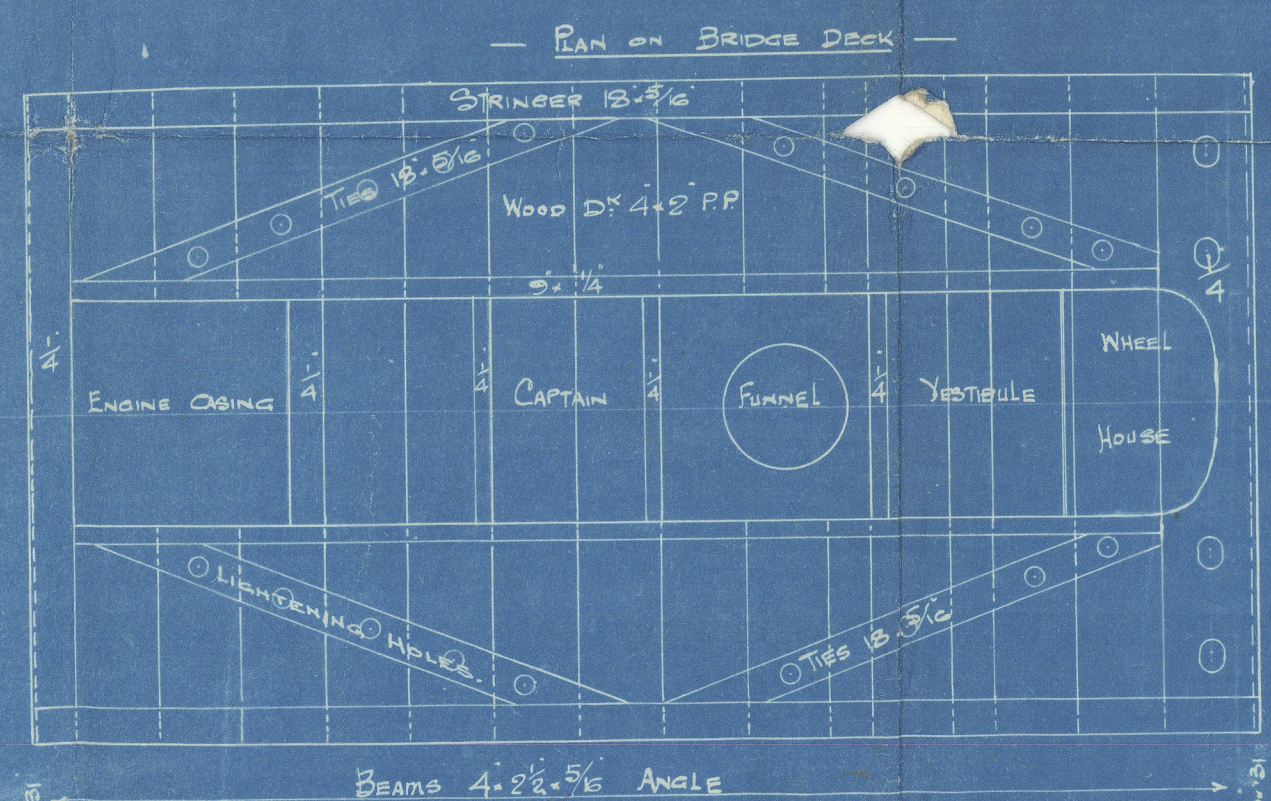
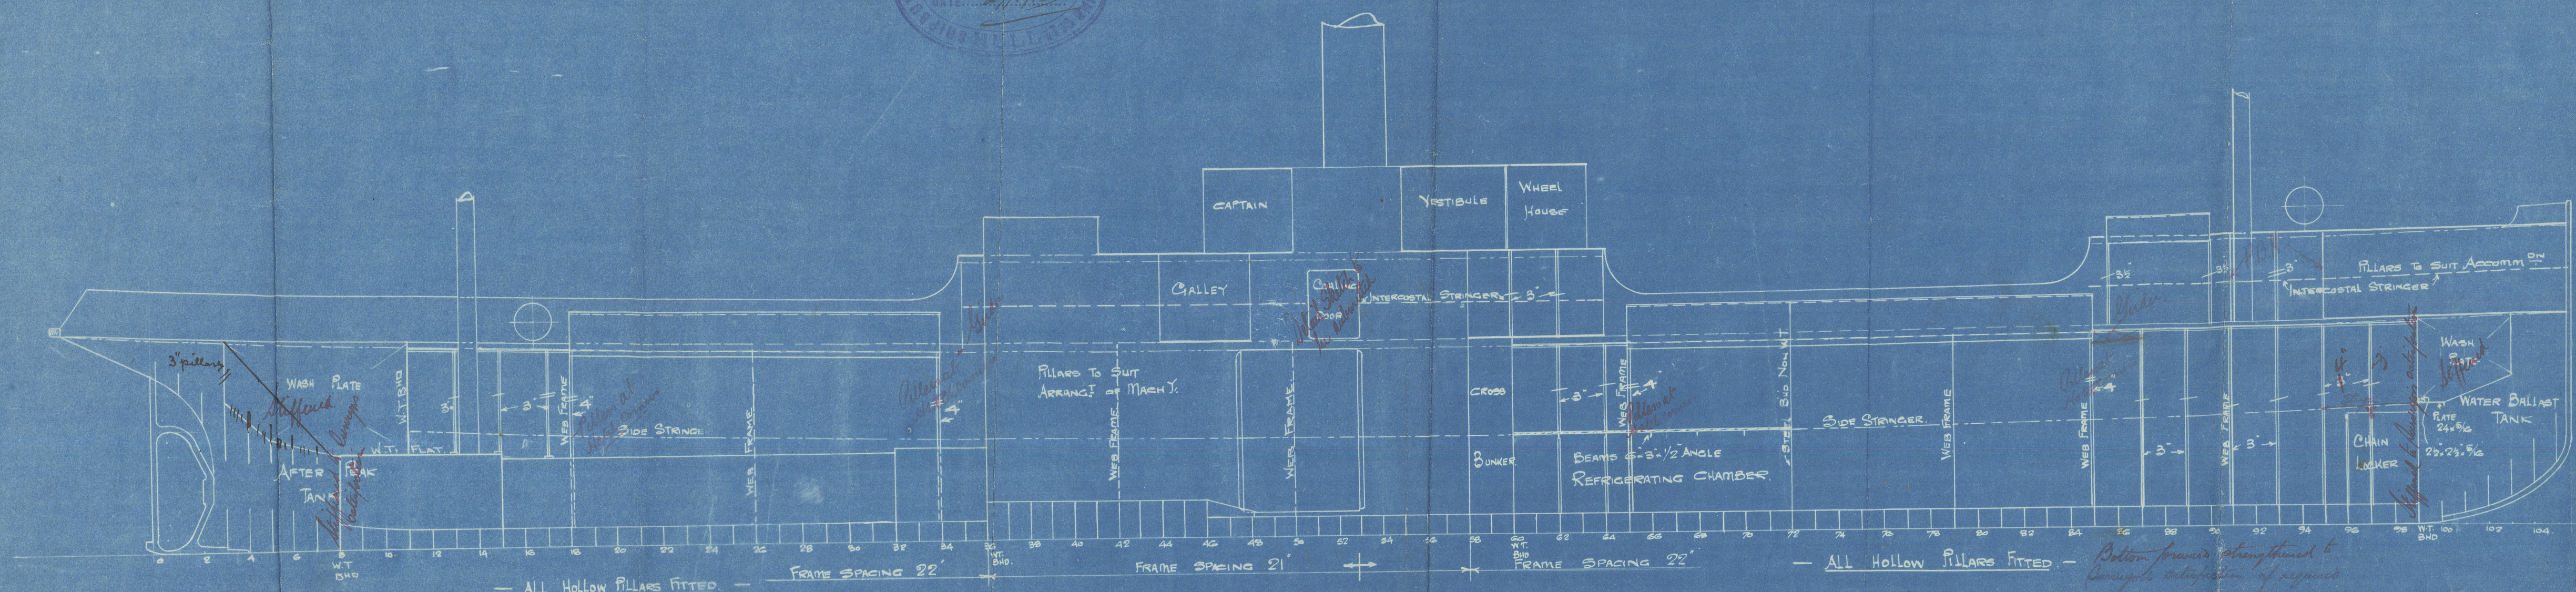


31.1.10
7.2.10.
14.4.10

- Nos 571-572 -
- PROFILE AND DECK PLANS -
- DIMS 132'0" B.P. x 29'0" x 15'0" -
- SCALE 1/8" = ONE FOOT -

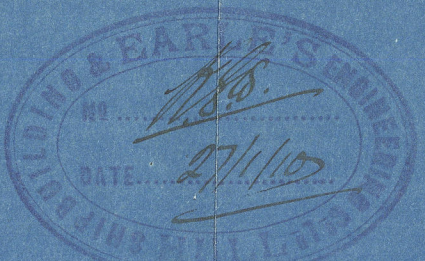

C.T.
24/1/10

LLOYD'S REGISTER
OF SHIPPING
6 JAN 1910

FULL © 2020

Lloyd's Register
Foundation

Charles A. & R. C. Sim.

N^o 541 + 572

Amended





Profile + Decks.

s/s Normandy

Hull Report No. 22736

s/s Brittany

Hull Report No. 22923

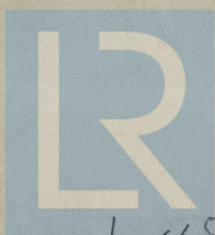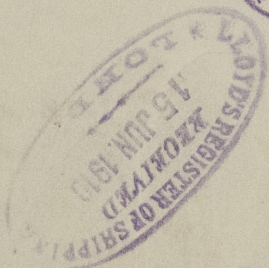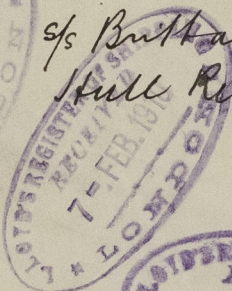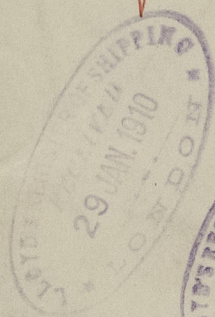

© 2020

Lloyd's Register
Foundation

W1544-0098