

19/4/10

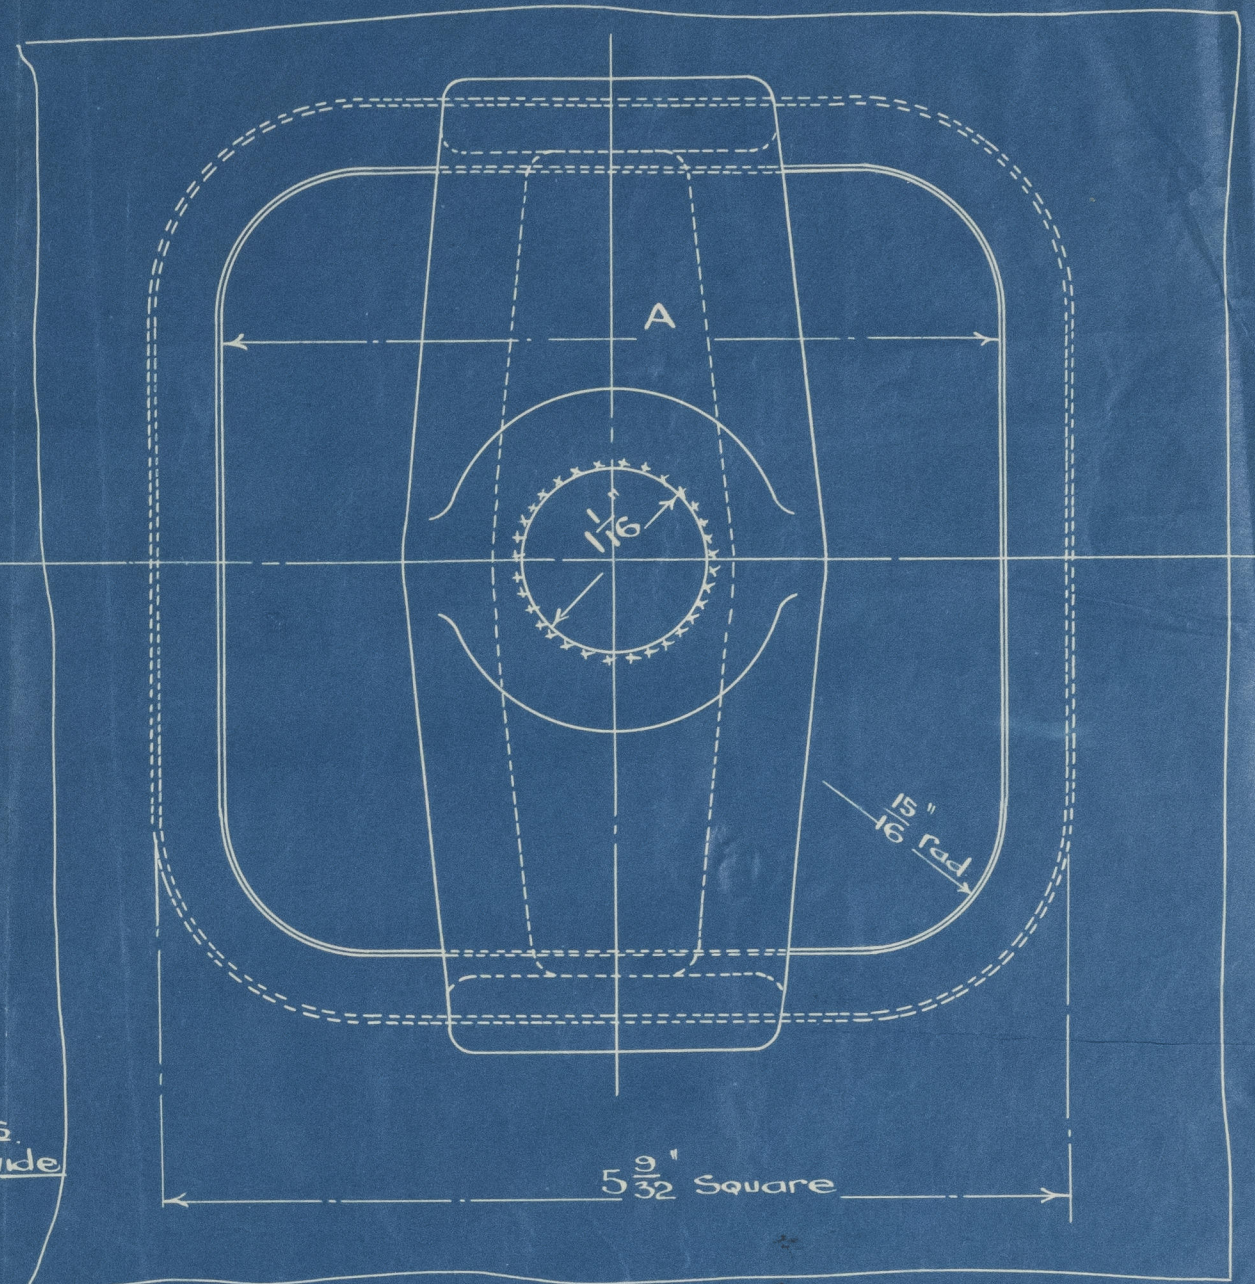
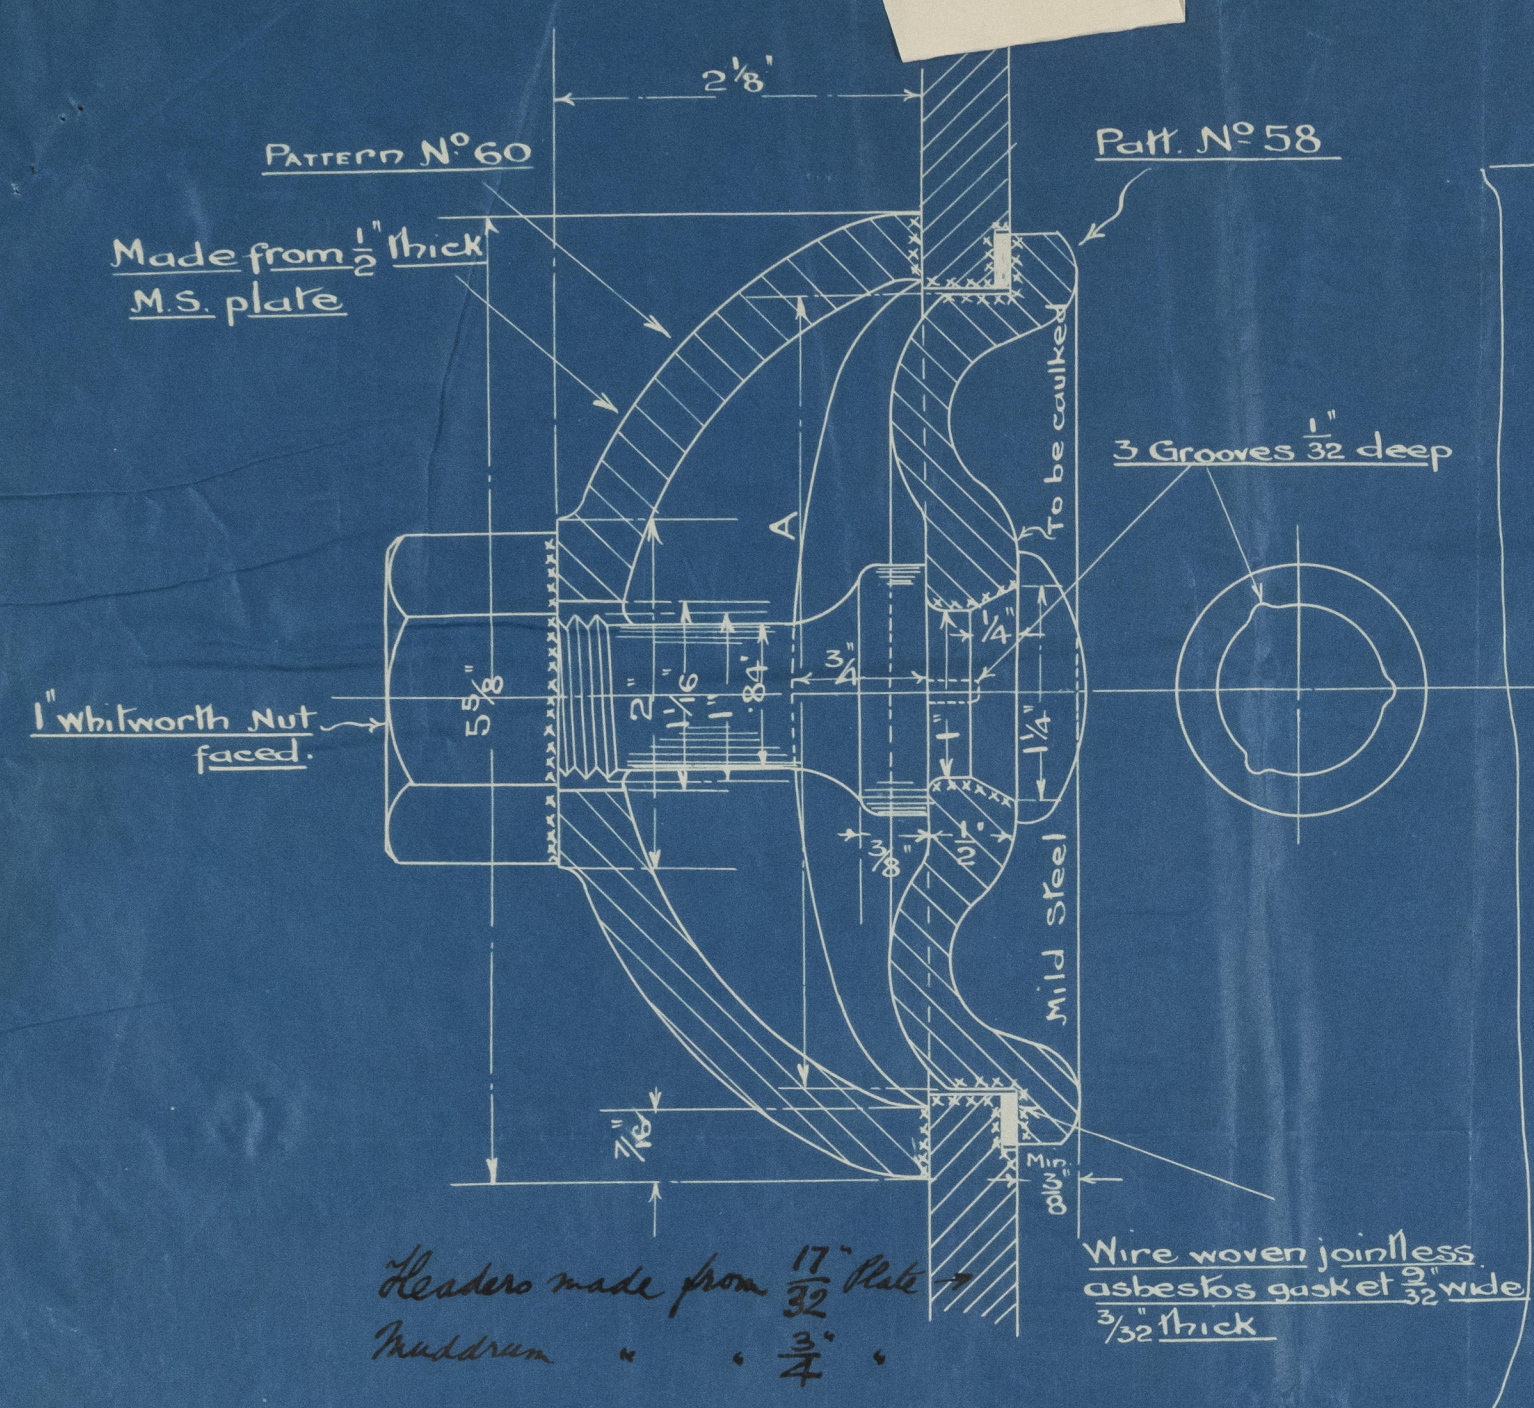


Table of Limit Sizes		
	Max.	Min.
A	4.671.	4.66.

4 1/16" sq. Handhole Fitting.

BABCOCK & WILCOX LTD
MARINE DEPT
FARRINGTON ST LONDON E.C.

M. 159.
D. N° 1980/10
1/4/10
Lloyd's Register
Foundation


WIS45-0116 1/2

R 7

From BABCOCK & WILCOX, Ltd., RENFREW,

FOR ENCLOSURE TO

M

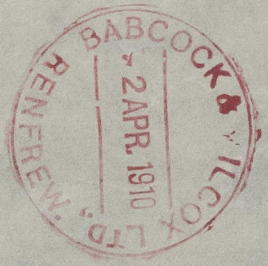

ES 11 28 15

