
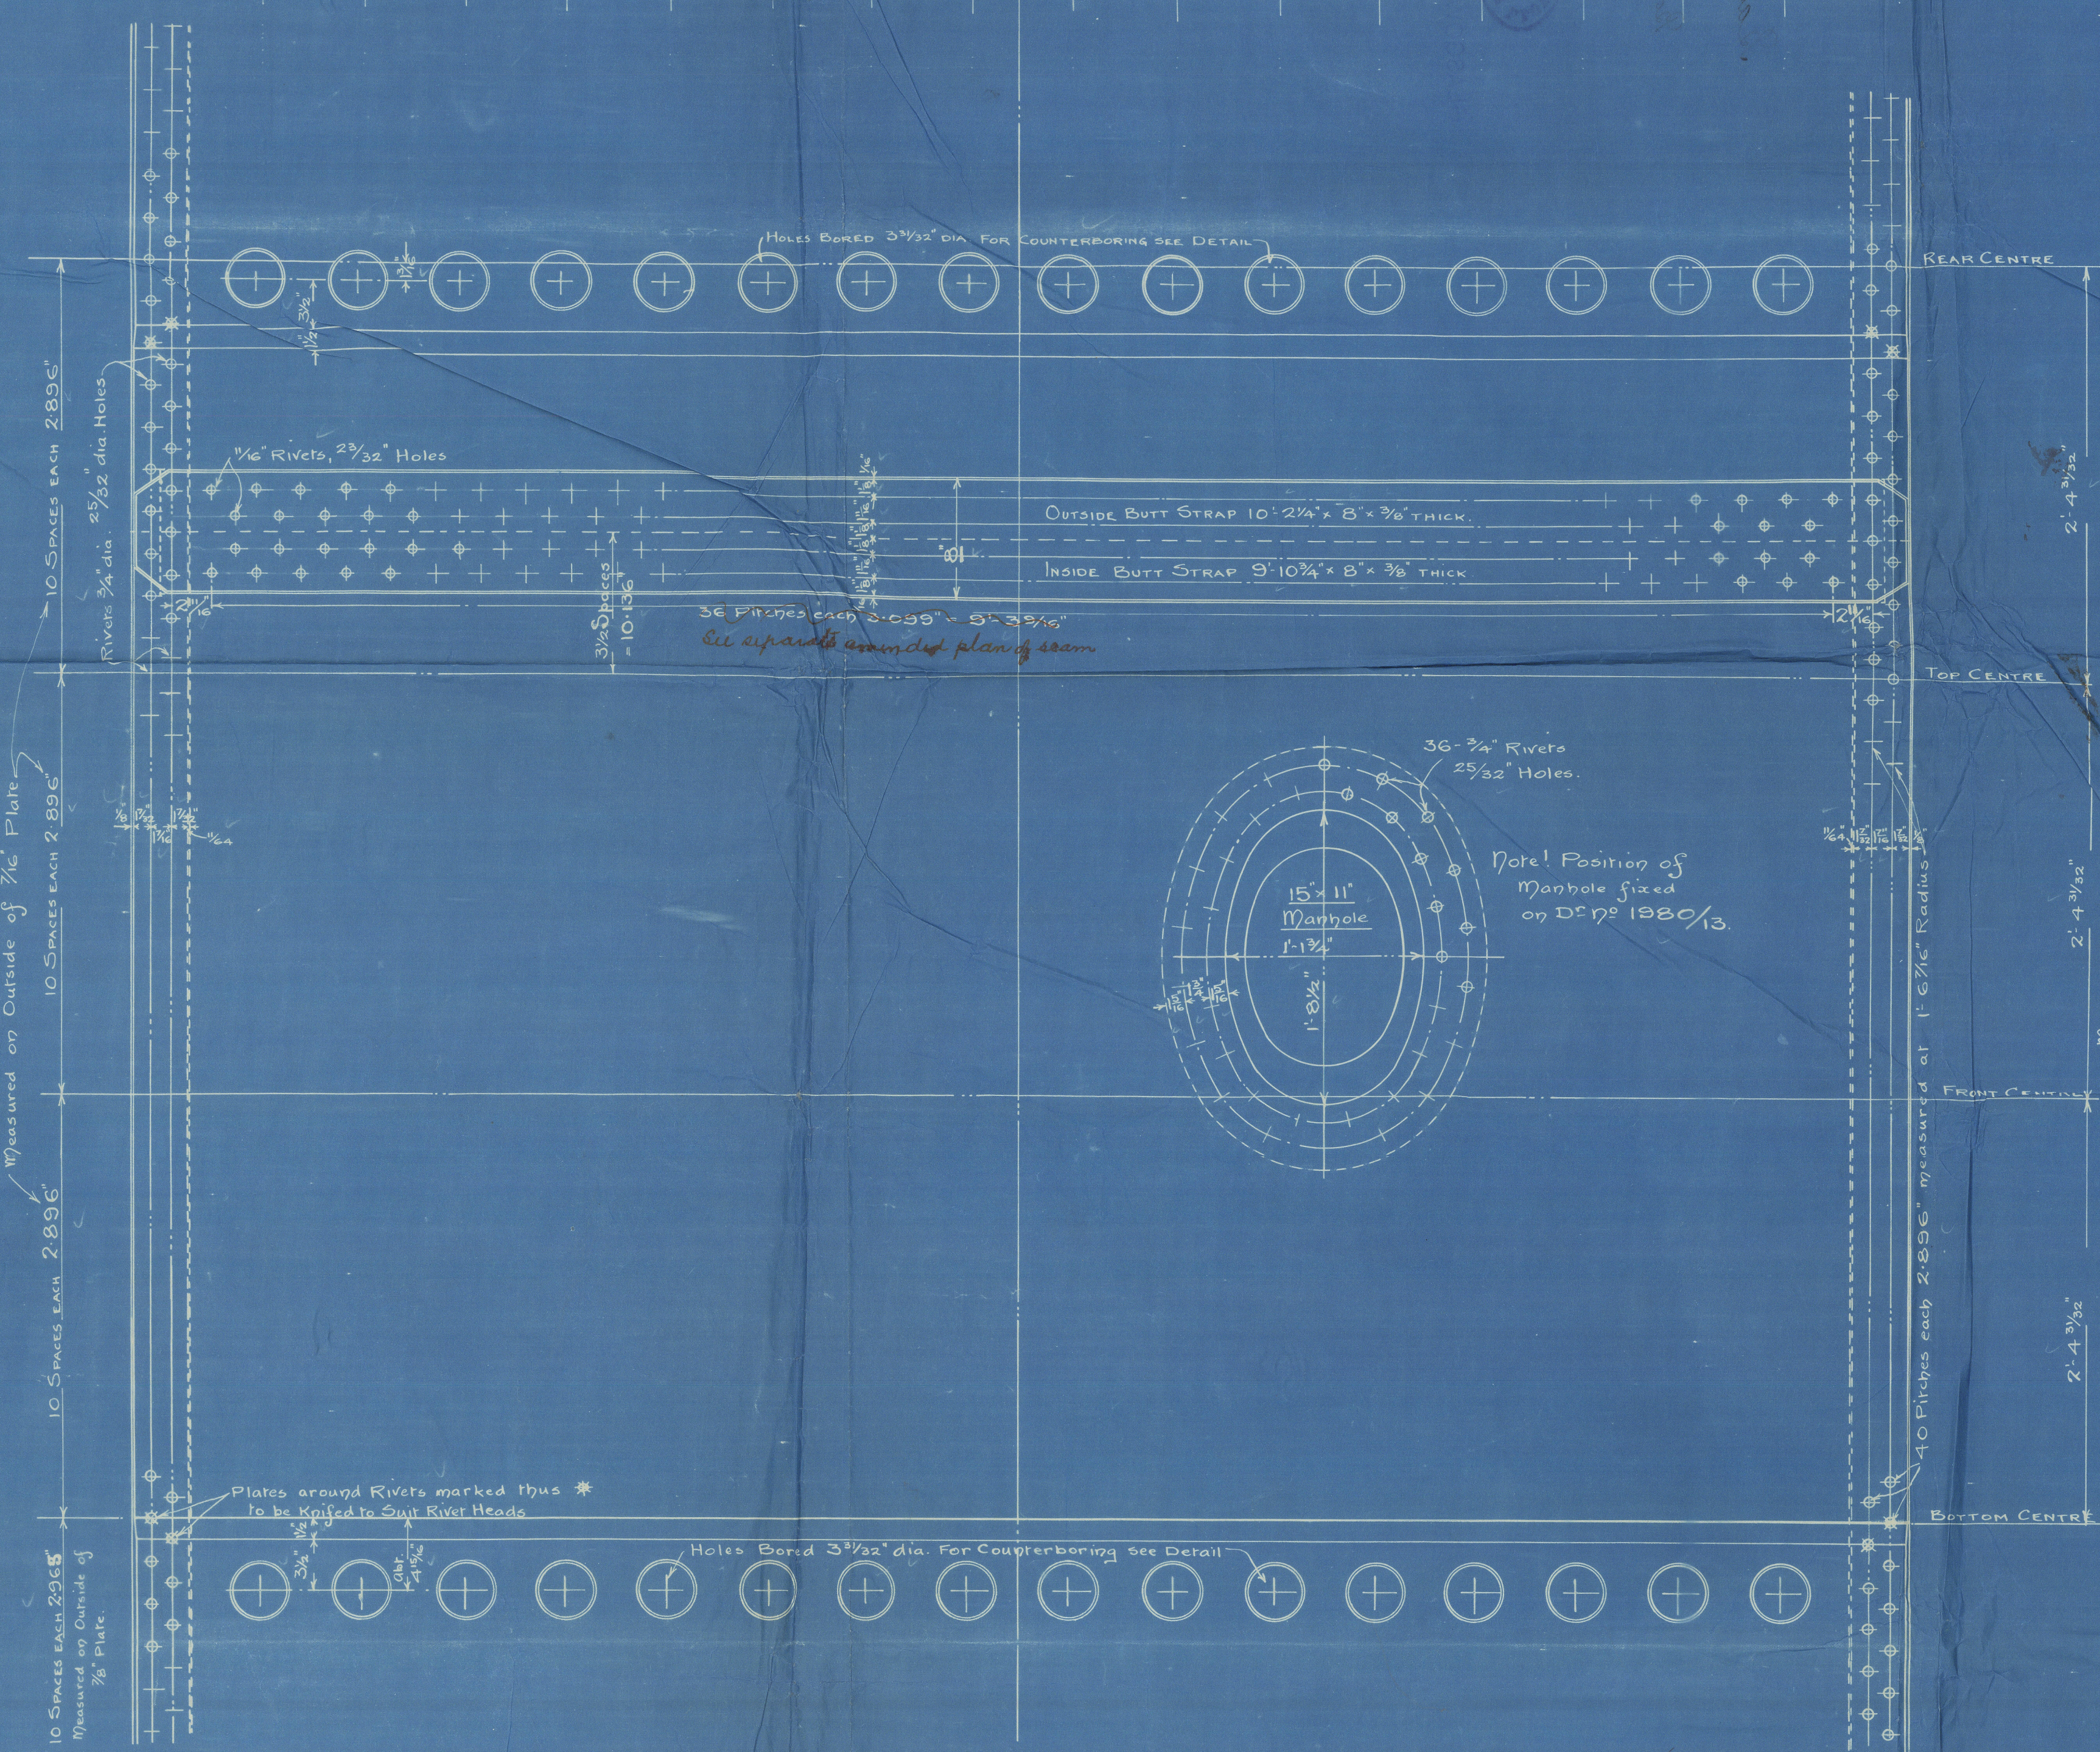
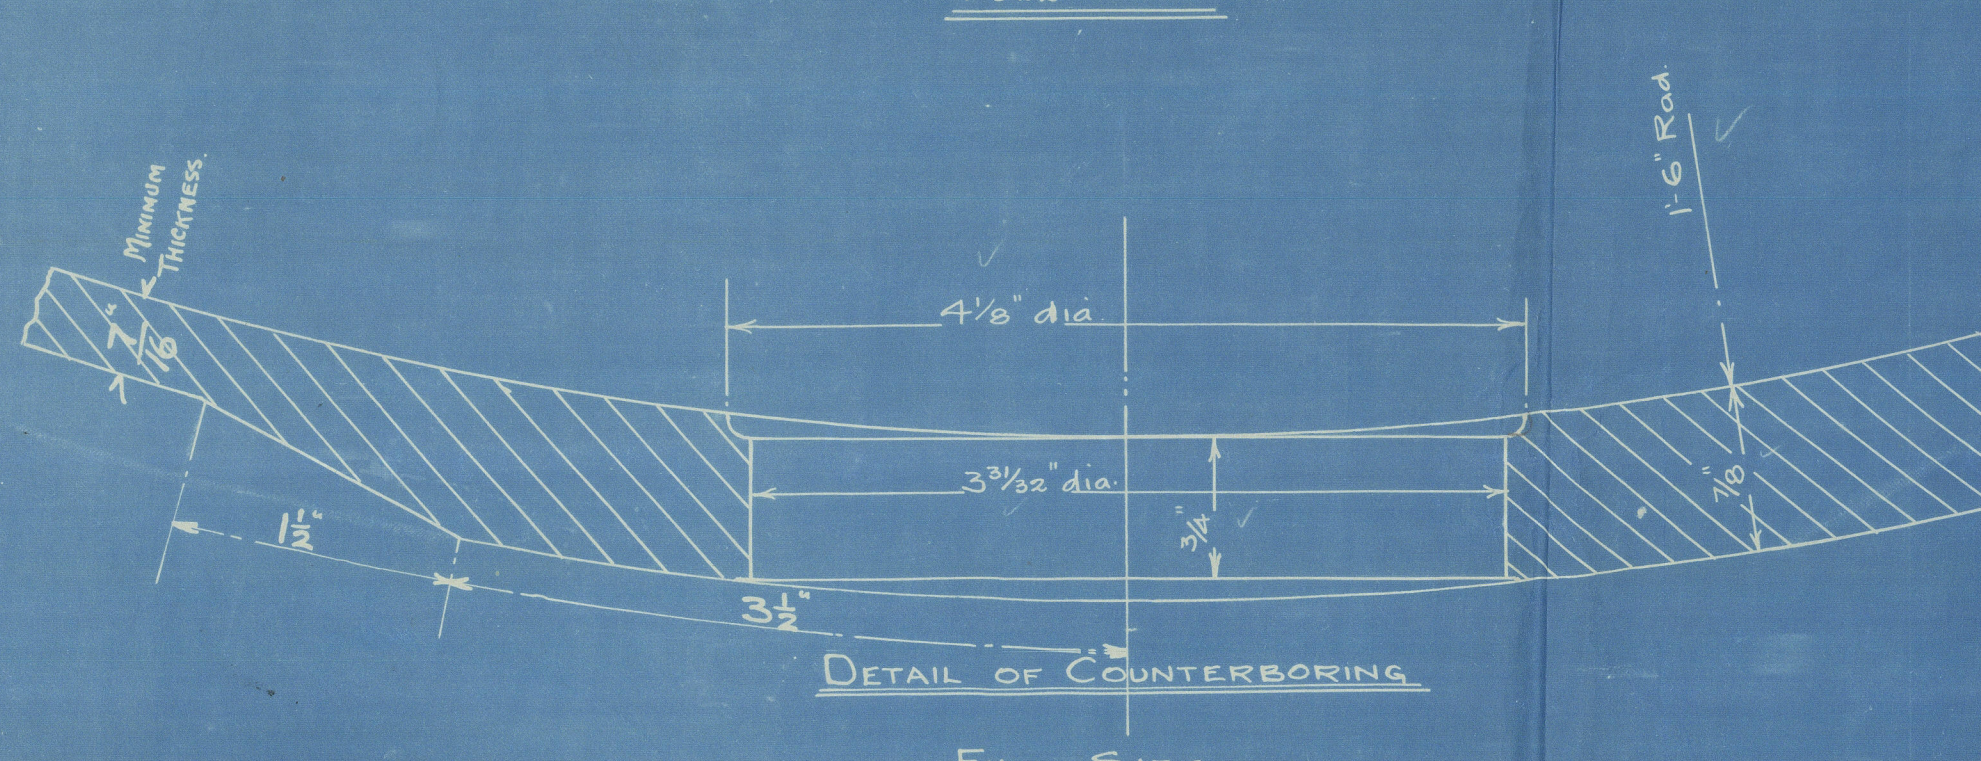
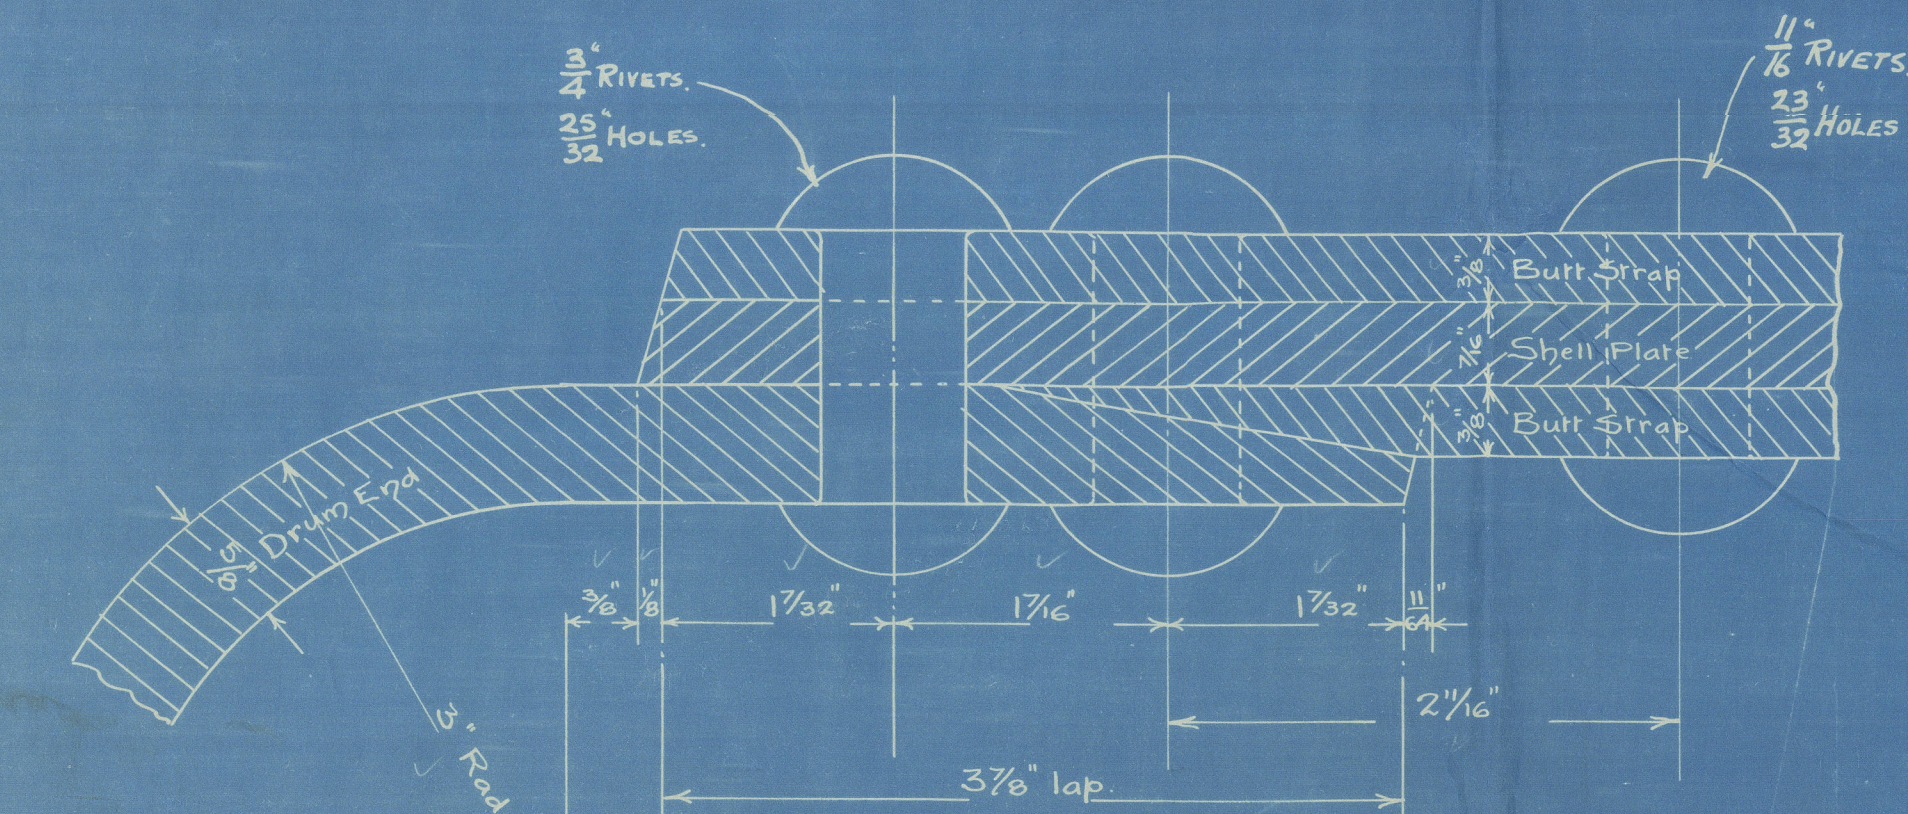
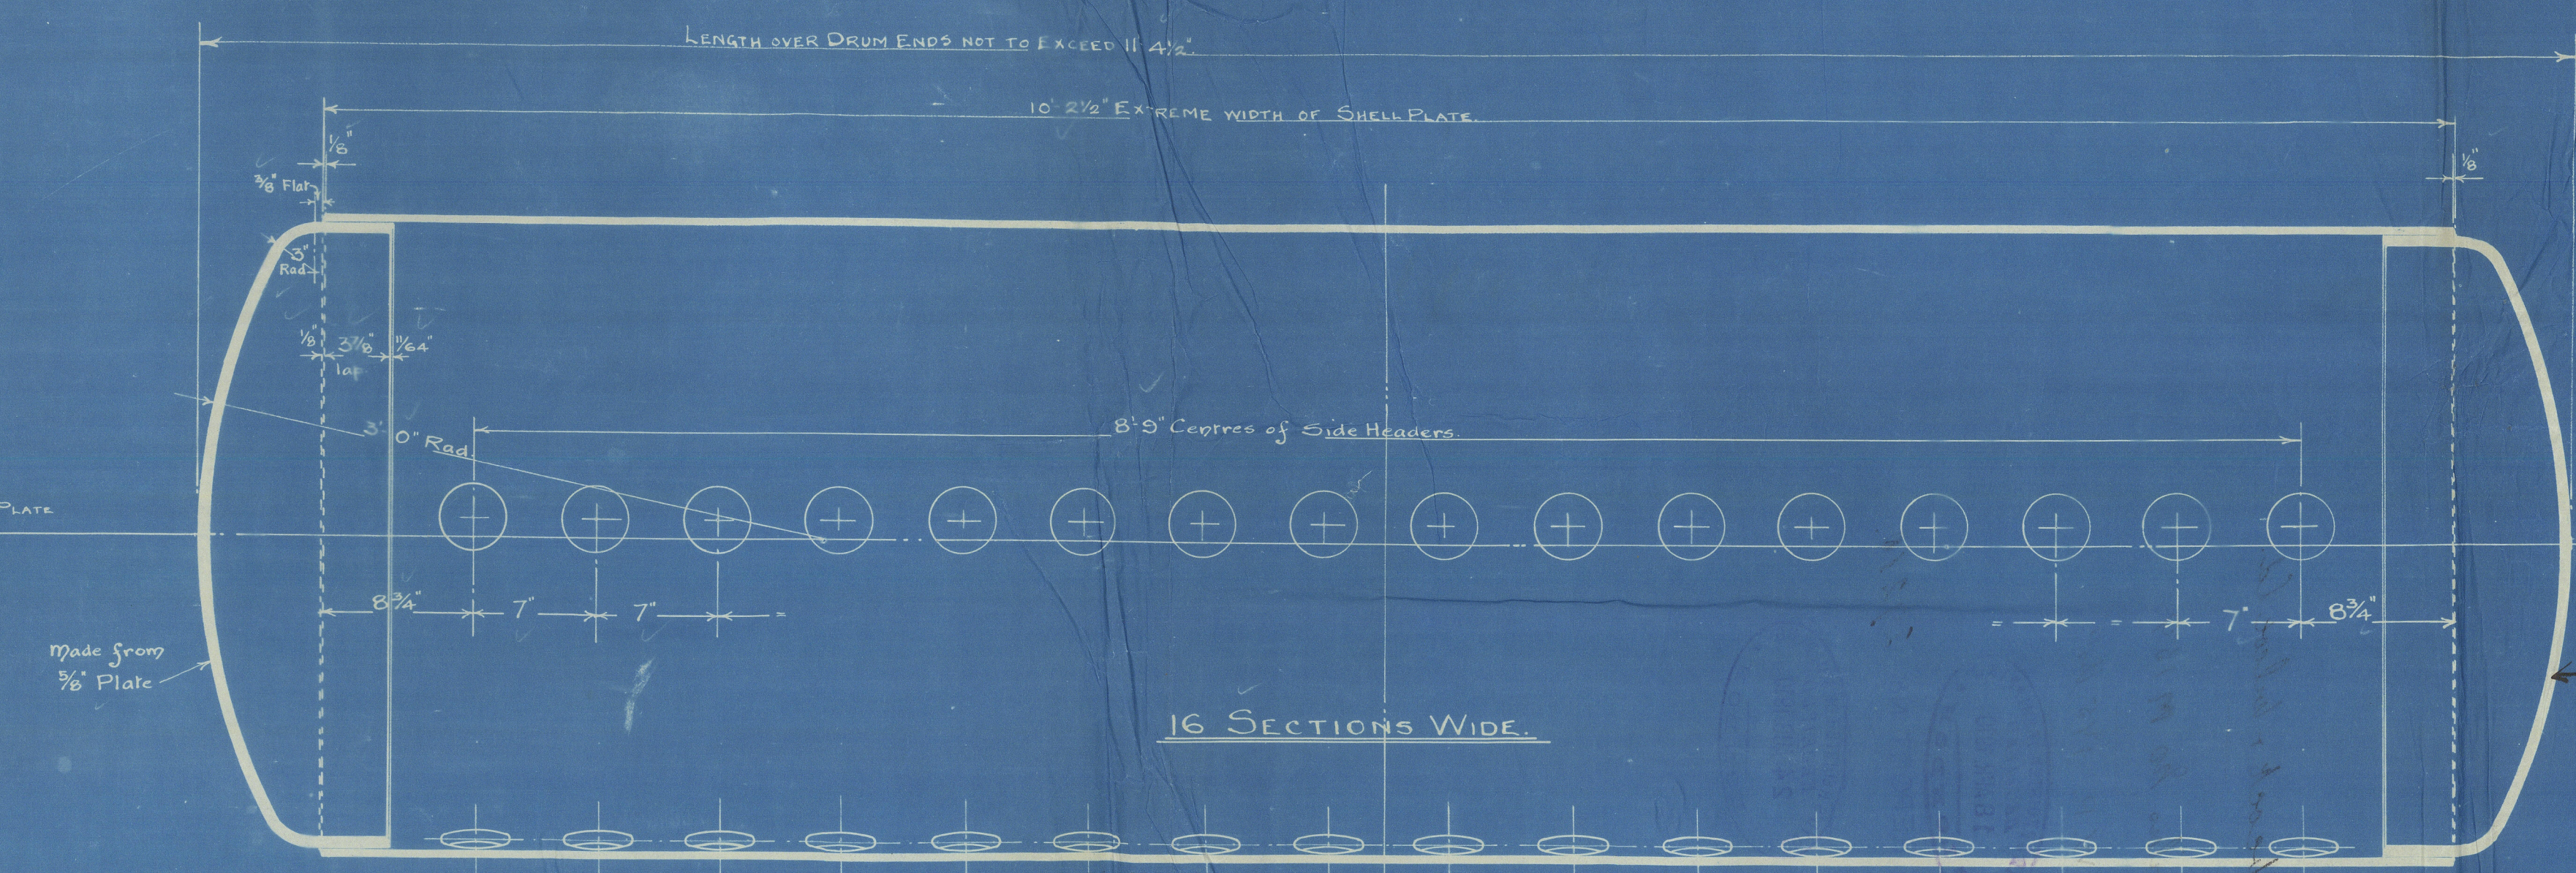


GROUP No. 1.

19/4/10

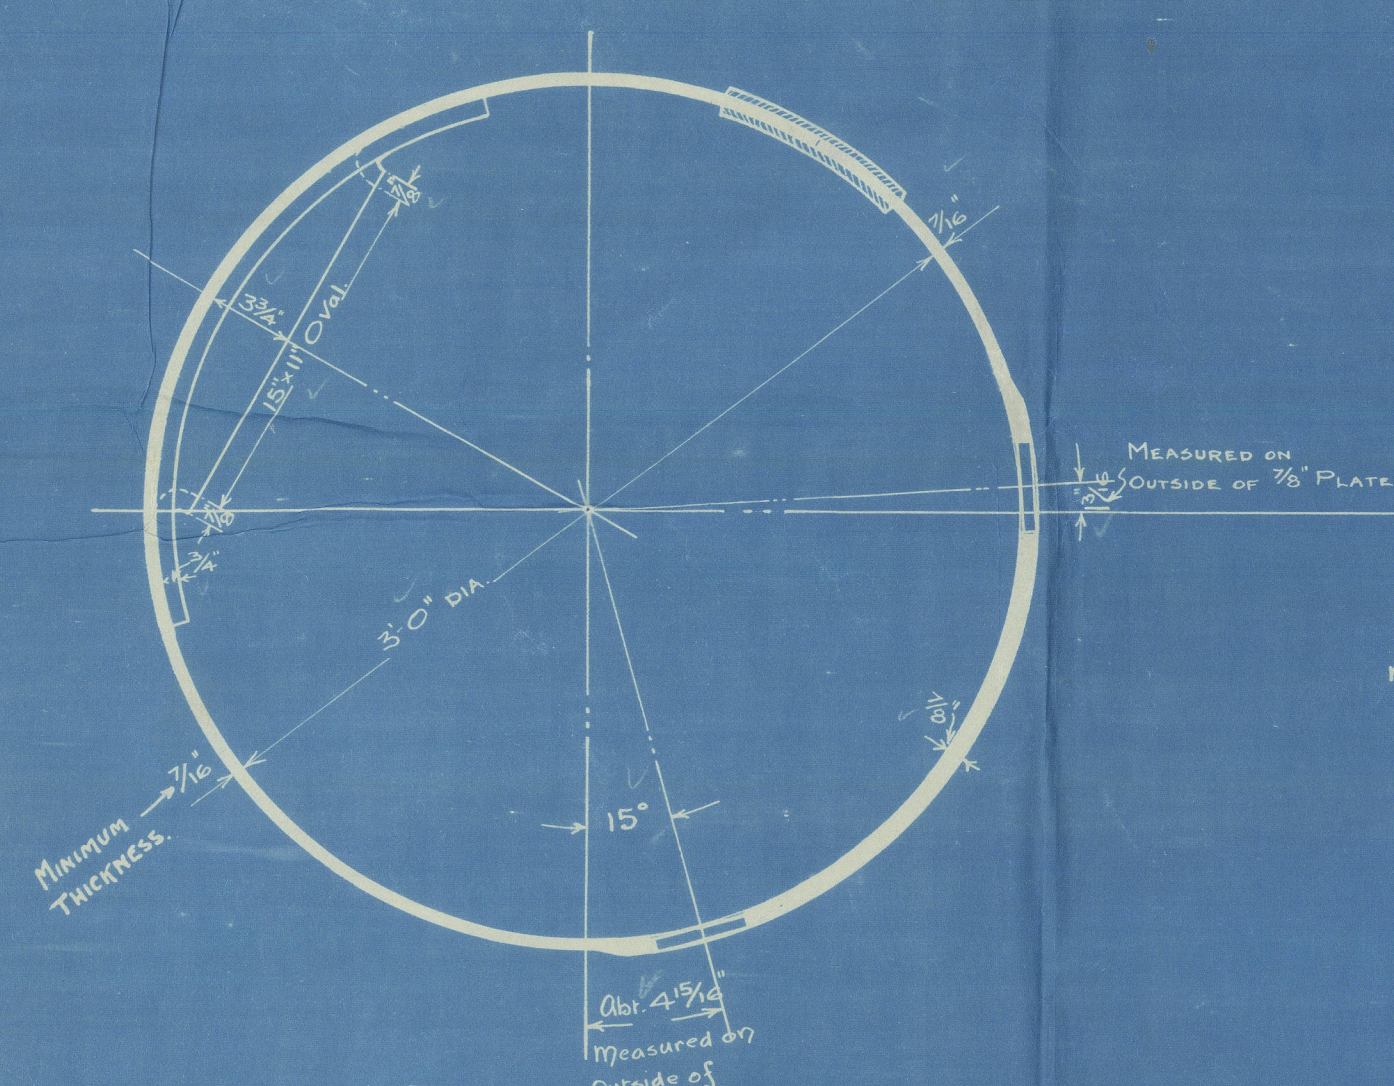

LIST OF MATERIAL FOR ONE DRUM

1	Shell Plate 10' 2 1/2" x 9' 7 1/2" x 3/8" thick, Plated to 3/16" thick as dimensioned
1	Outside Butt Plate 10' 2 1/4" x 8" x 3/8" "
1	Inside " " 9' 10 1/4" x 8" x 3/8" "
2	Diabed Drum Ends, 3/8" thick, 3' 0" dia.
1	15" x 11" Manhole with Compensating Ring

Note! Dimensions Given are Finished Sizes.

TENSILE STRENGTH OF PLATES = 24-28 TONS PER SQ"

DETAIL OF STEAM & WATER DRUM.

2 THUS

SCALE 1 1/2" = 1 FOOT.

WORKING PRESSURE = 175 LBS PER SQ"

TEST " = 350 " " "

TO LLOYD'S SURVEY.

BABCOCK & WILCOX LTD
MARINE DEPT
FARRINGTONS LONDON E.C.

JOB NO. M159
D/S NO. 1989/3
DATE 15-4-10

19/4/10

Babcock & Wilcox Ltd.

Boilers No M 159

W. P. 175 lbs



GLASGOW REPORT No. 29210.



W1545-0118



© 2021

Lloyd's Register
Foundation



W1945-0115



© 2021

Lloyd's Register
Foundation