



12-4-06  
2-5-06  
7-5-06  
11-5-06

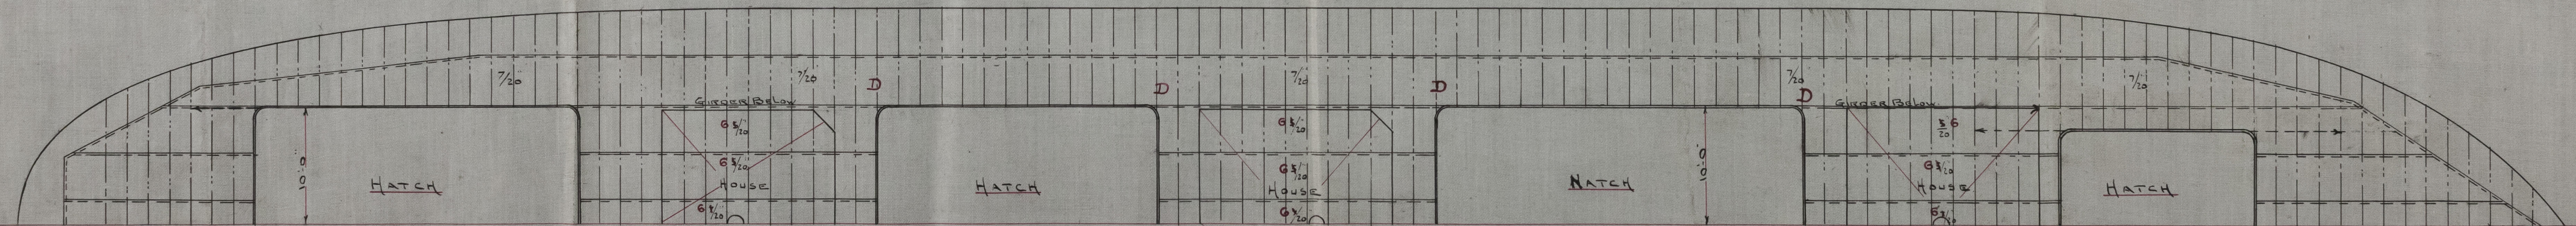

S.S. N°90  
PROFILE & DECK PLANS  
STEEL SAILING BARGE.

— DIMS: 210-0" B.P. x 37-0" x 11-0" M.L. —  
— SCALE 1/8" = 1 FT —  
TO CLASS ~~FOR~~ AT LLOYD'S  
FOR RIVER PLATE NAVIGATION

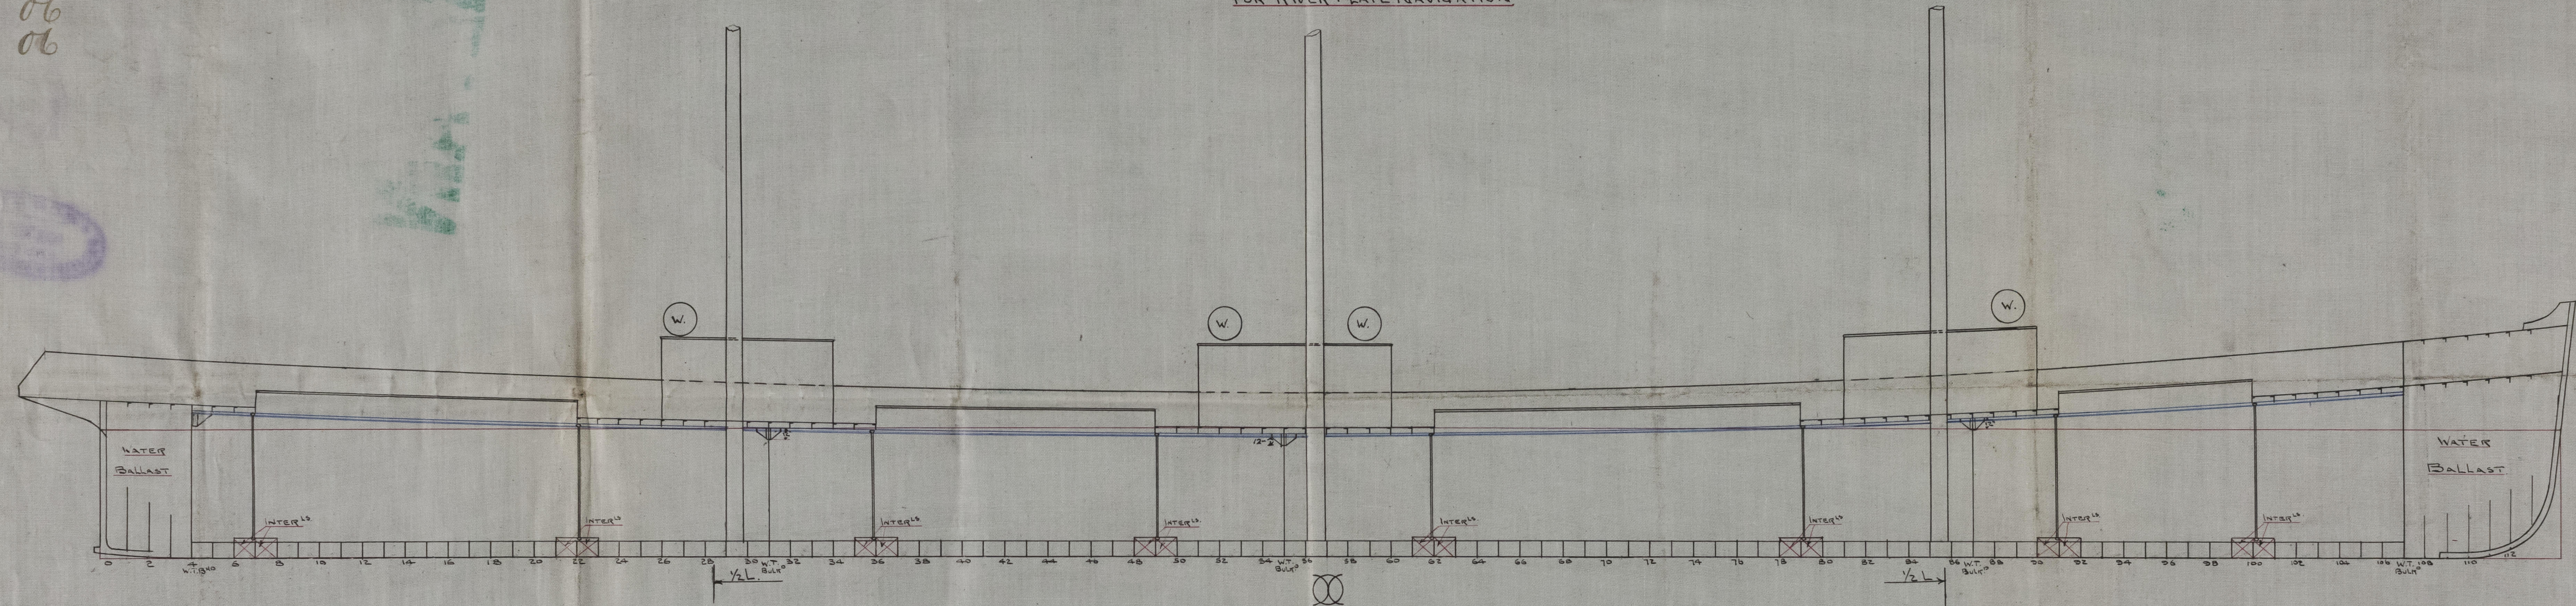

J.P.R.  
12/14/06






Good S. & R. Co. Ltd.,

No 90.

Profile & Deck Plan.

Sch. 'Oceanic'

Hull Rpt No - 18519

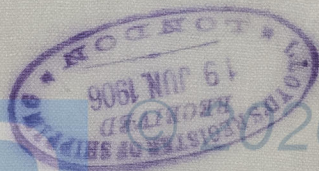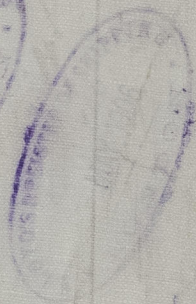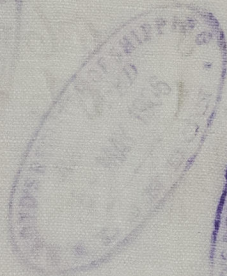

Lloyd's Register  
Foundation

W15410 - 0011