
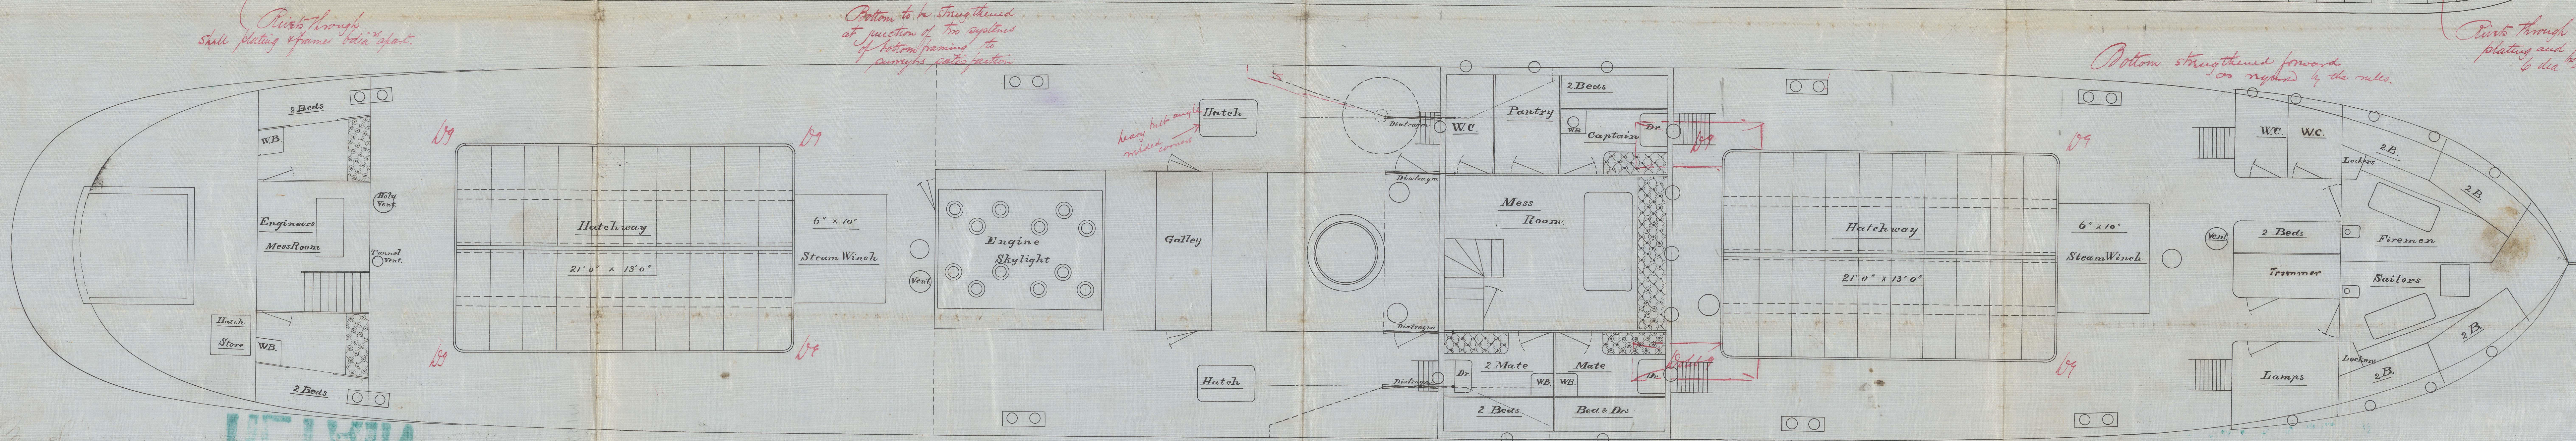


1. 11. 02
6. 11. 02

Dimensions:
150' 0" x 24' 0" x 12' 0" M^{ld}

Scale $\frac{1}{4}'' = 1 \text{ Ft}$

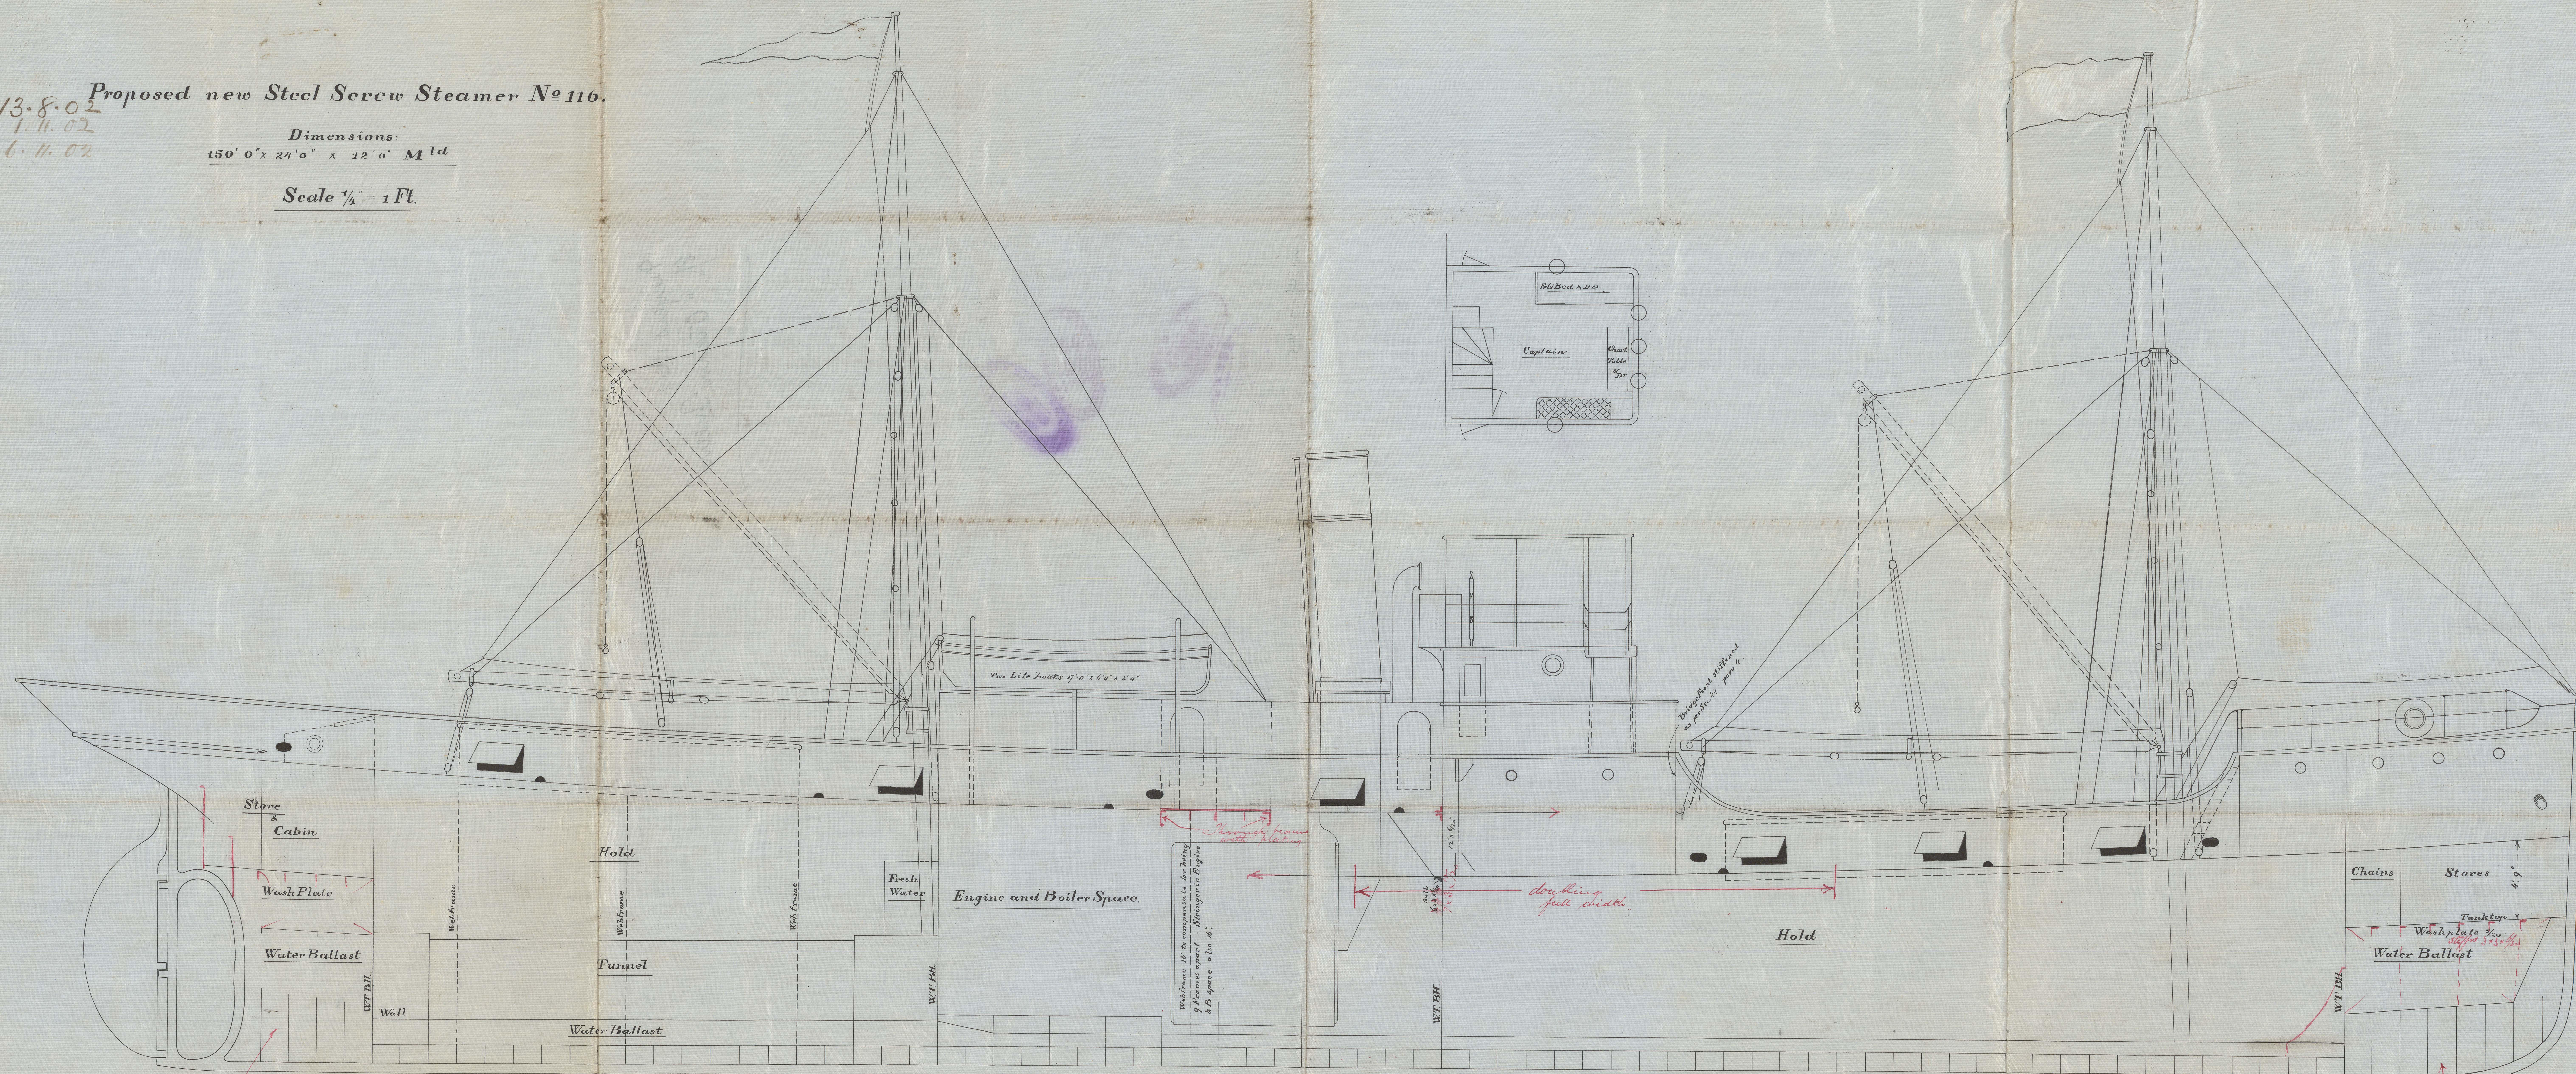

C.D.

W1546-0045

RECEIVED

Shore

EV

EV





Meyers 116
8/5 "Ocean Queen"



© 2020

Lloyd's Register
Foundation

W1546-0045