


19.2.01.

Donkey Boiler  
5' Diam. 9 1/2' long  
Scale 1"=1' Pressure 80 l.b.s. per sq"


Material Steel Heating Surf. about 1000

5 Vertical Stays to be fitted

Manhole 12 x 16  
Mud hole 6 x 8  
Stokehole 10 x 14

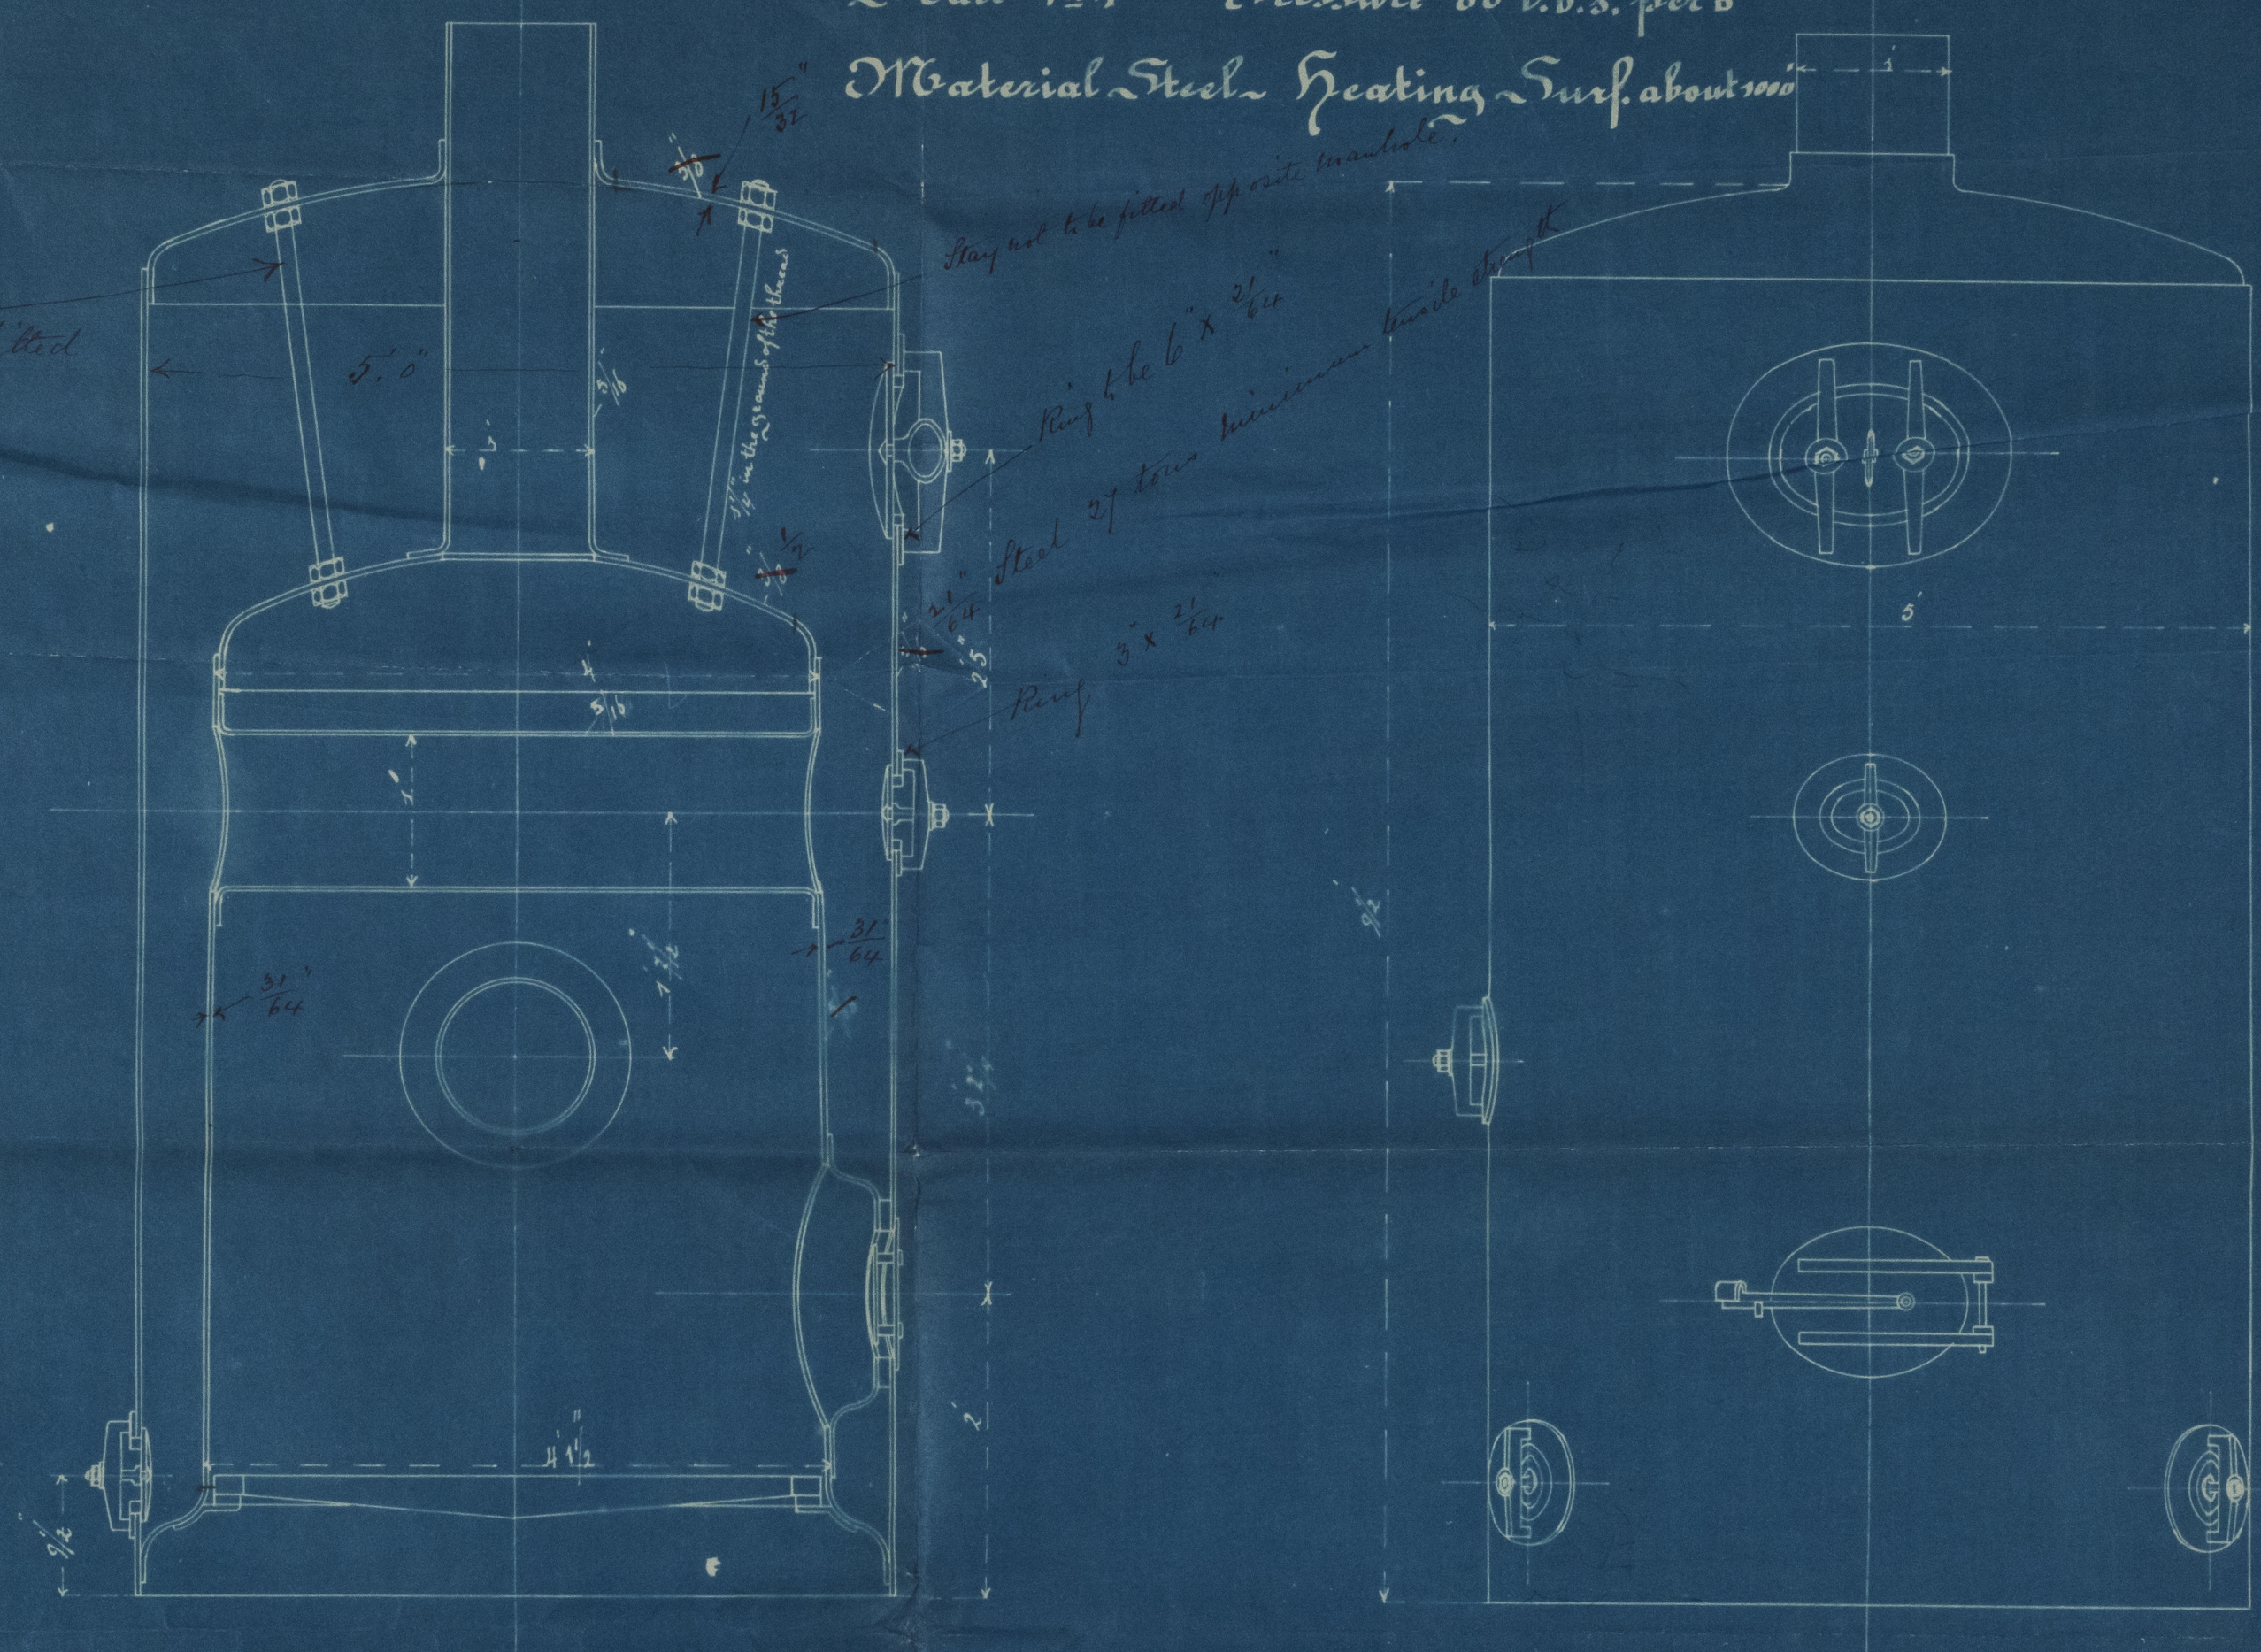

Scale 2"=1'

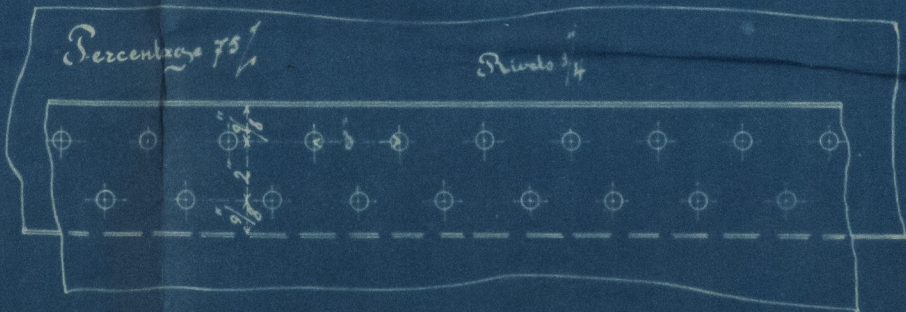

11 Feb. 1901.


19.2.01.




Lloyd's Register Foundation

W1546-0047



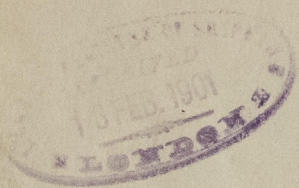

D. J. Bohling.  
Donkey Boilers Ltd. add  
now to be placed in all  
N<sup>o</sup>. 116 "Ocean Green".

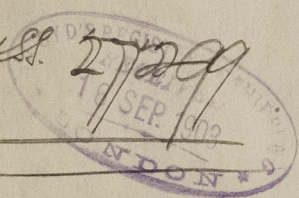Ans. 27299  


RECEIVED

*Ad*



© 2020

Lloyd's Register  
Foundation

W1546-0047