

12. 11. 06
16. 11. 06

DIM^{NS} 128^{±0}" x 22^{±0}" x 13^{±10}" DEPTH MOULDED
SCALE $\frac{1}{2}$ " = 1 FOOT


TO BE CLASSED 100 A.I. AT LLOYDS FOR FISHING PURPOSES
ENGINE & BOILER CASING AS PREVIOUSLY APPROVED
DECK PLATED IN WAY OF ENGINE & BOILER SPACE

1/2 GIRTH _____ 20.95'
1/2 BREADTH _____ 10.95'
DEPTH _____ 14.29'
_____ 46.19.15" N°
_____ 126.87" LENGTH AS PER RULE
_____ 58601153.2" N°

• <u>DTOL</u>	<u>8.8</u> ✓
• <u>BTOL</u>	<u>5.7</u> ✓

TOWERS	
✓ 1 ST BOWER	5 3/4 CWTs EX STOCK. IF STOCKLESS 7 1/4 CWTs
✓ 2 ND BOWER	5 1/4 CWTs EX STOCK
✓ 3 RD BOWER	3 CWTs EX STOCK
✓ 105 FATHOMS	1 1/16" CABLE
✓ 60 "	6" HAWSER
✓ 60 "	5" WARP

GOCHRANE & SONS
SHIPBUILDERS
SELBY
JORMES

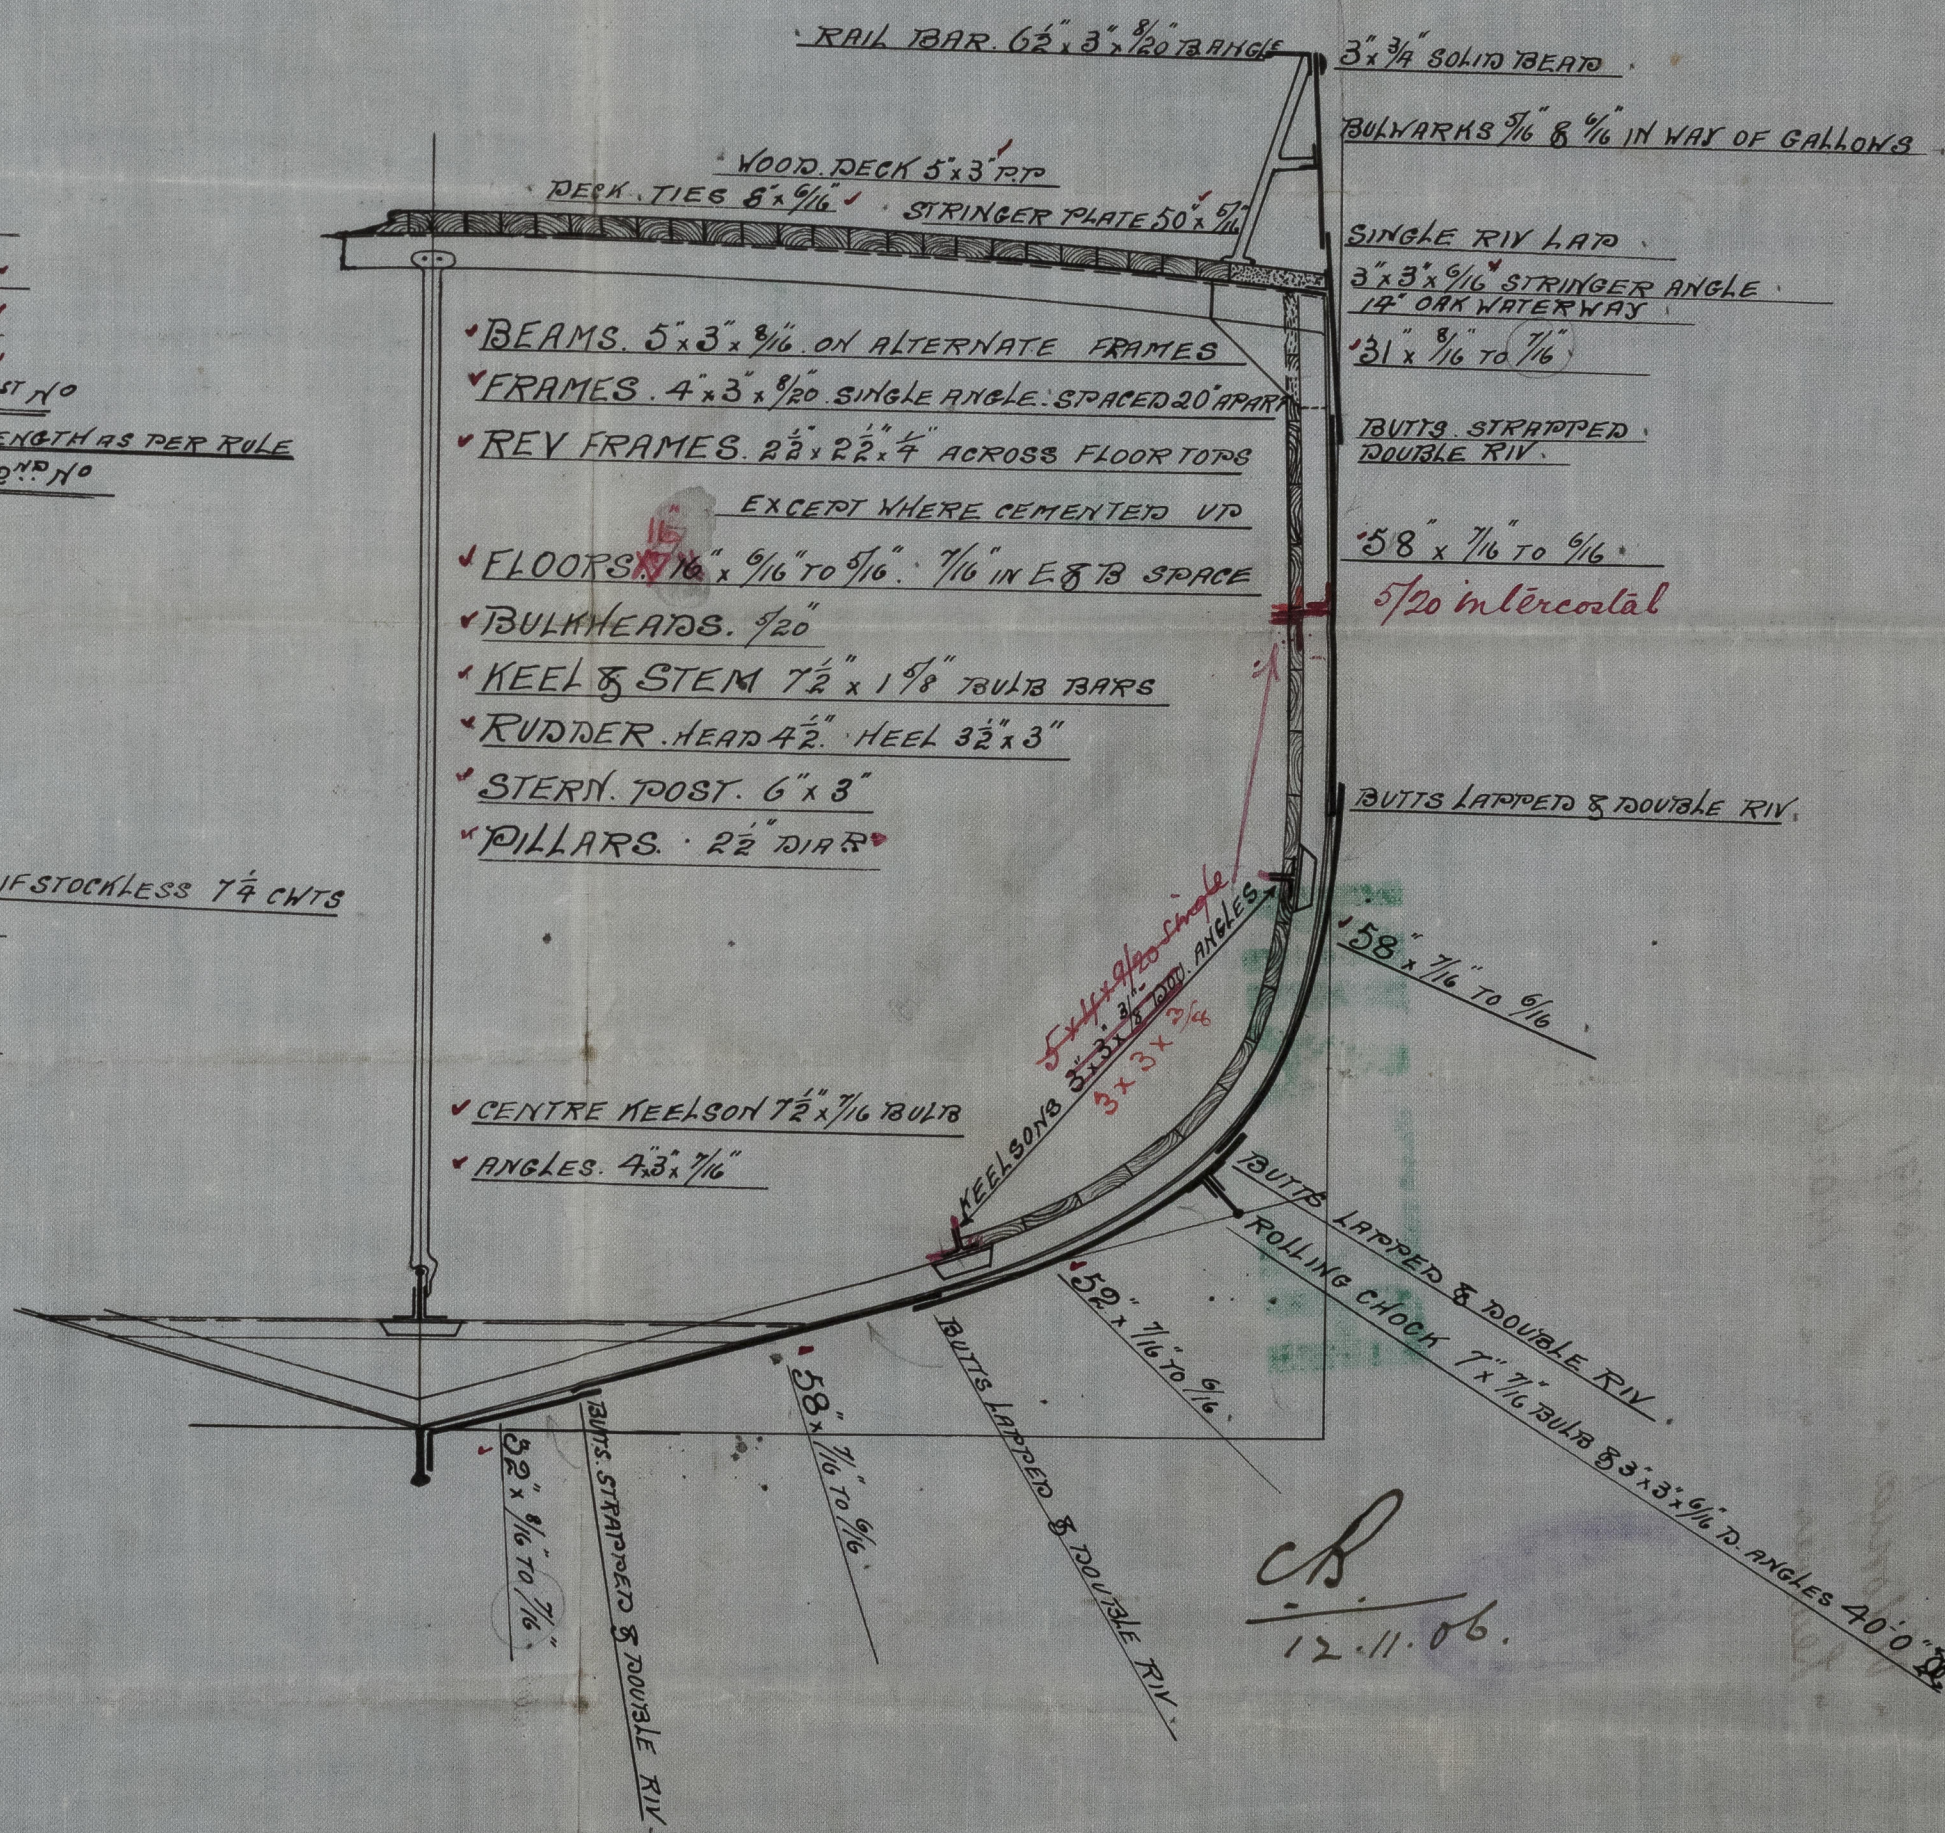

CB
12.11.06.

Cochrane & Sons

N^{os} 393.394.395

Midship Section.

⁵/₅ Orlando Hull Rph No 18936

" Vidonia " " 18991

" Leander " " 19026




RETAIN

W1547-0044

Midship Section 393-4-5

Midship Section 393-4-5

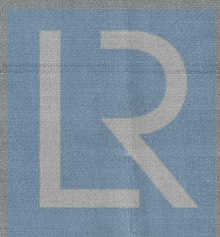

© 2021

Lloyd's Register
Foundation