


6.8.02

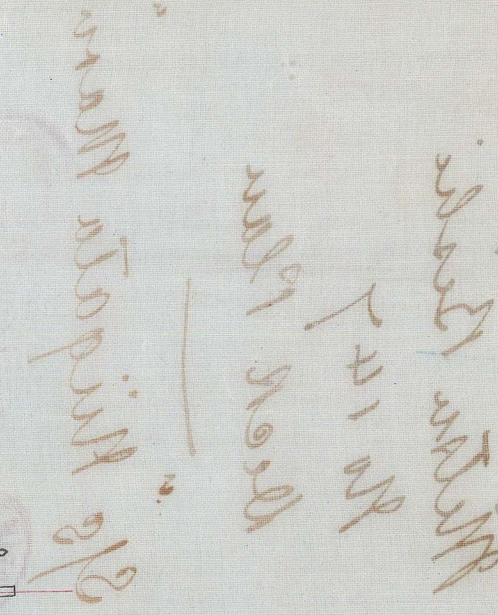

J.V.L.
6/8/02

4
 MITSUBISHI
 NAGASAKI
 Yamamoto
 22.6.02
 K. Taseki.
 S. Kawabata
 D.D. No 1184
 Y. Sagitani


Mitsu Bishi

No 147

Deck Plan

S/S Niigata Maru


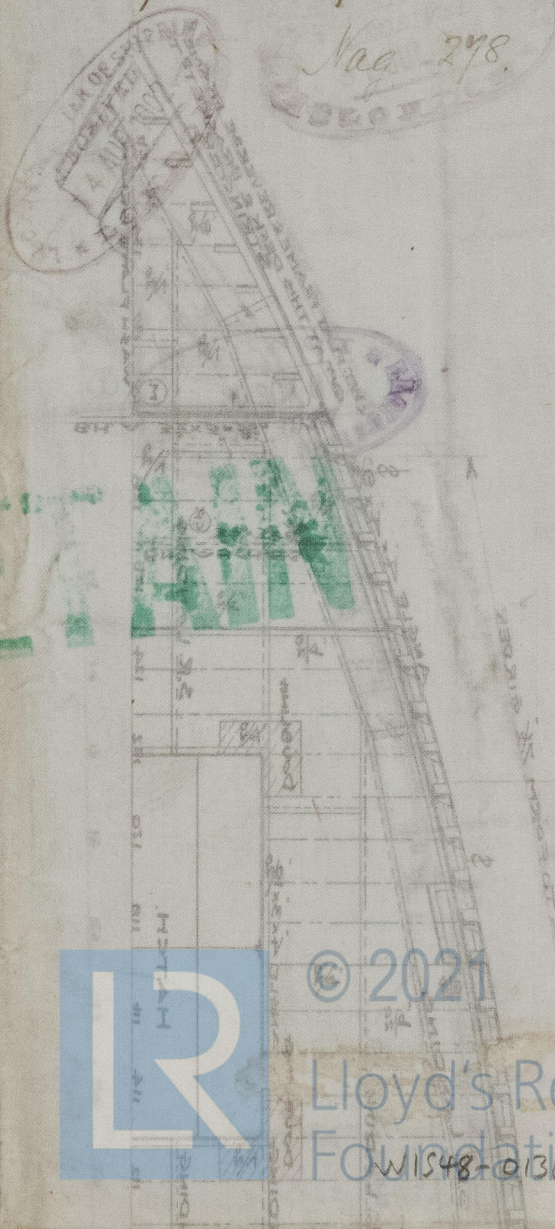

© 2021

Lloyd's Register
Foundation

W1548-0136


