
 
 


10/10/25


# DECK PLANS.

SCALE 1/8" = 1' 0"

NOTE. S.S. DENOTES SPECIAL STEEL.

 


978.

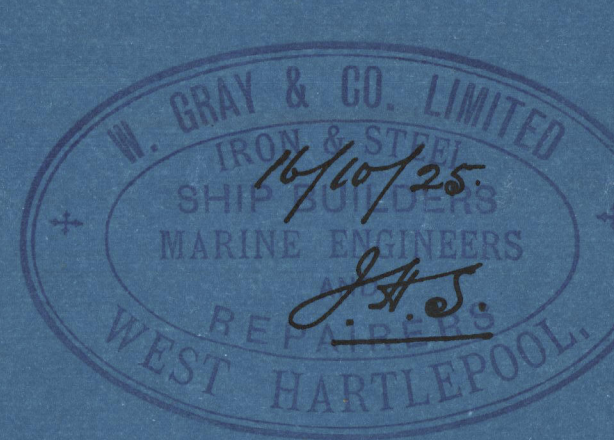

978.

W.S.  
20.10.25

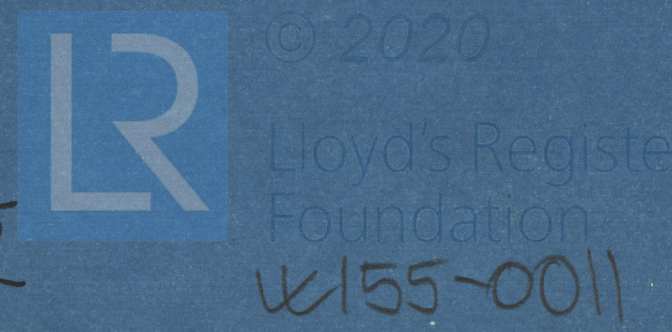



Decks

CITY OF BATH

Mess<sup>rs</sup> W. Gray & Co

No 948

Deck Plans

WEST HARTLEPOOL

Rpt 16411.

X1155-0011



© 2020

Lloyd's Register  
Foundation