

Y.L.
9/8/05

14.8.05






A. & W. DALGLISH
WEST OF SCOTLAND
BOILER WORKS
POLLOKSHAW, GLASGOW.

MARINE BOILER.

9'-6" DIA. x 9'-0" LONG FOR 130 LBS. W.P.

UNDER LLOYD'S SURVEY.

SCALE 1" = 1 FOOT.

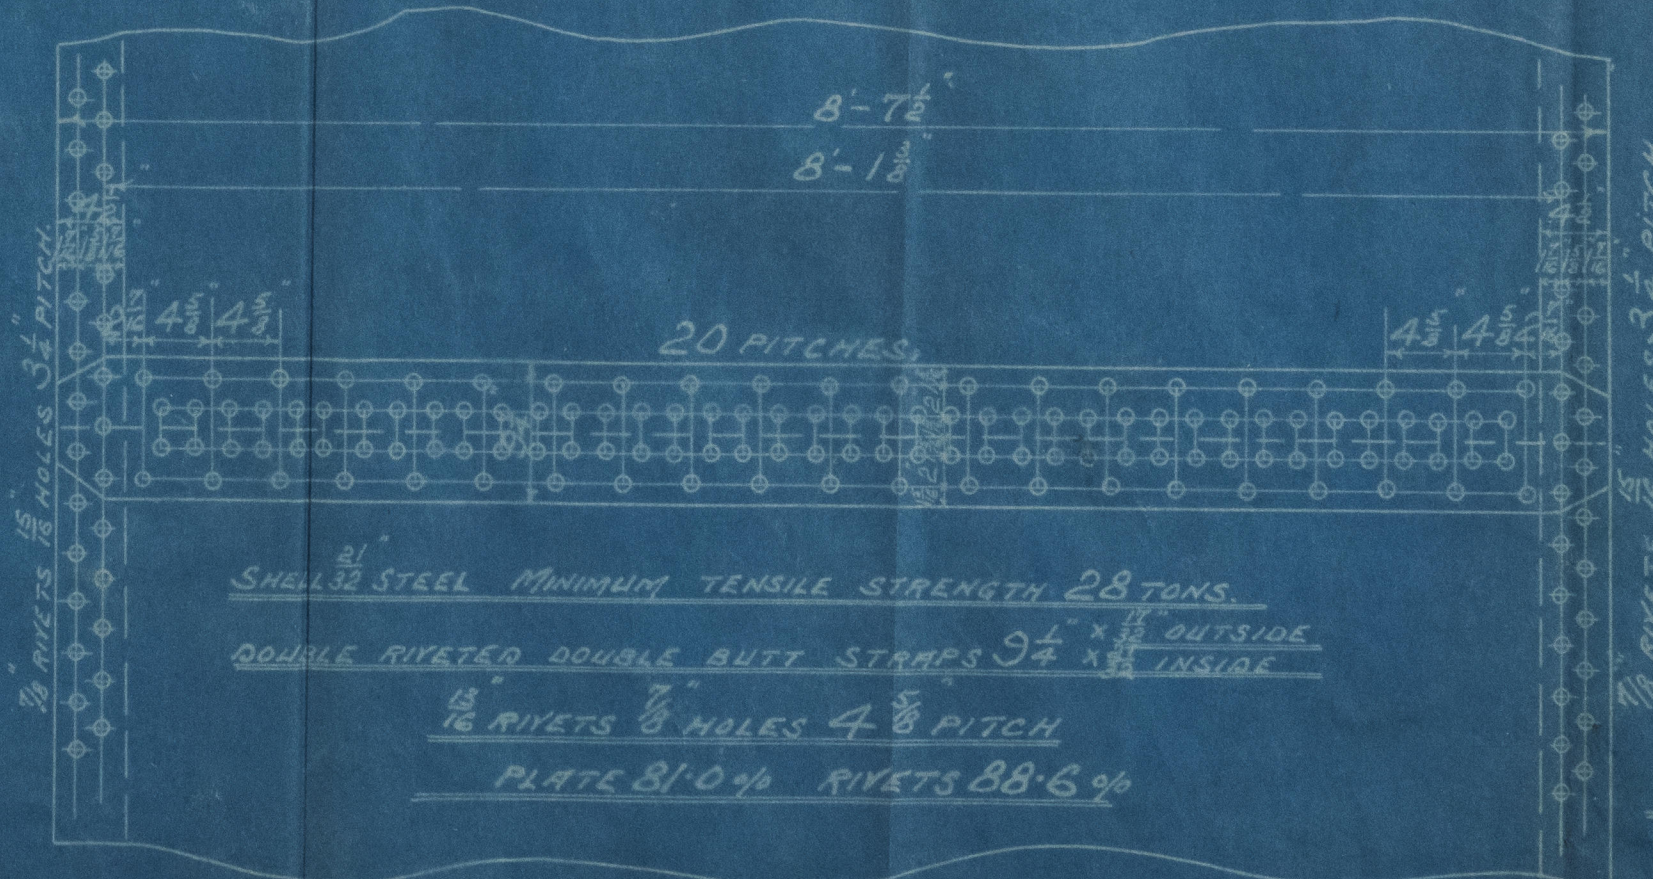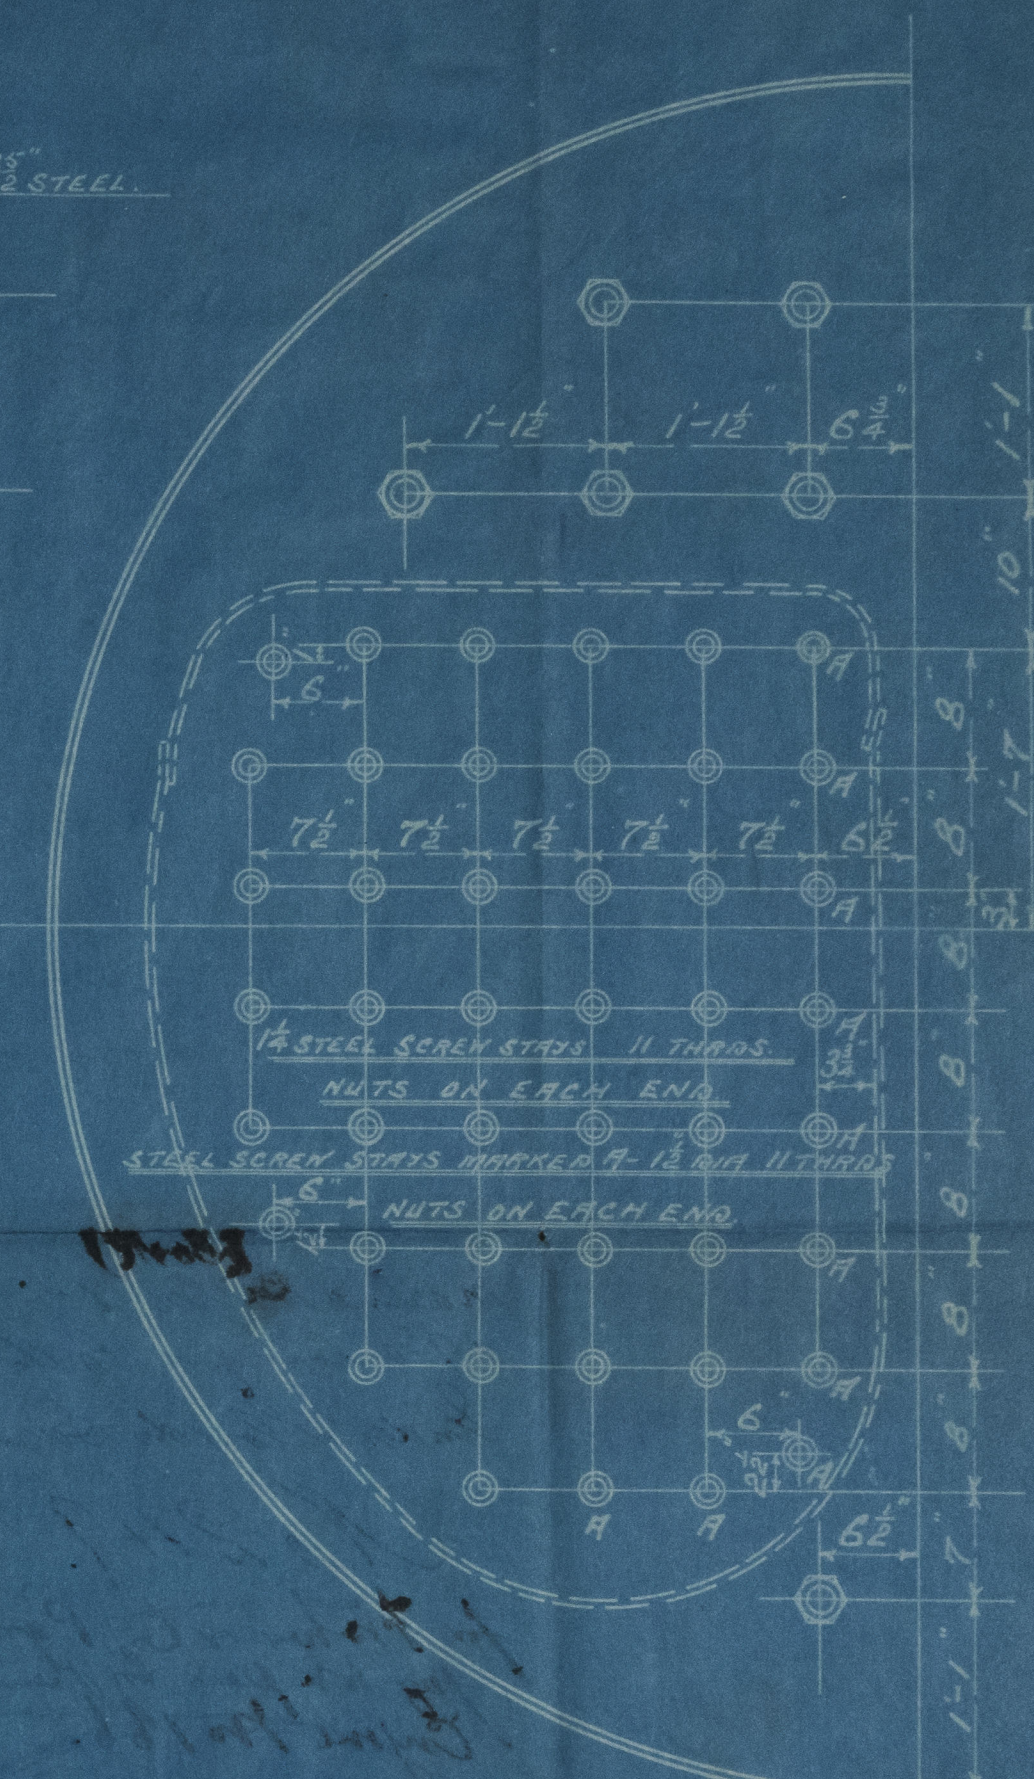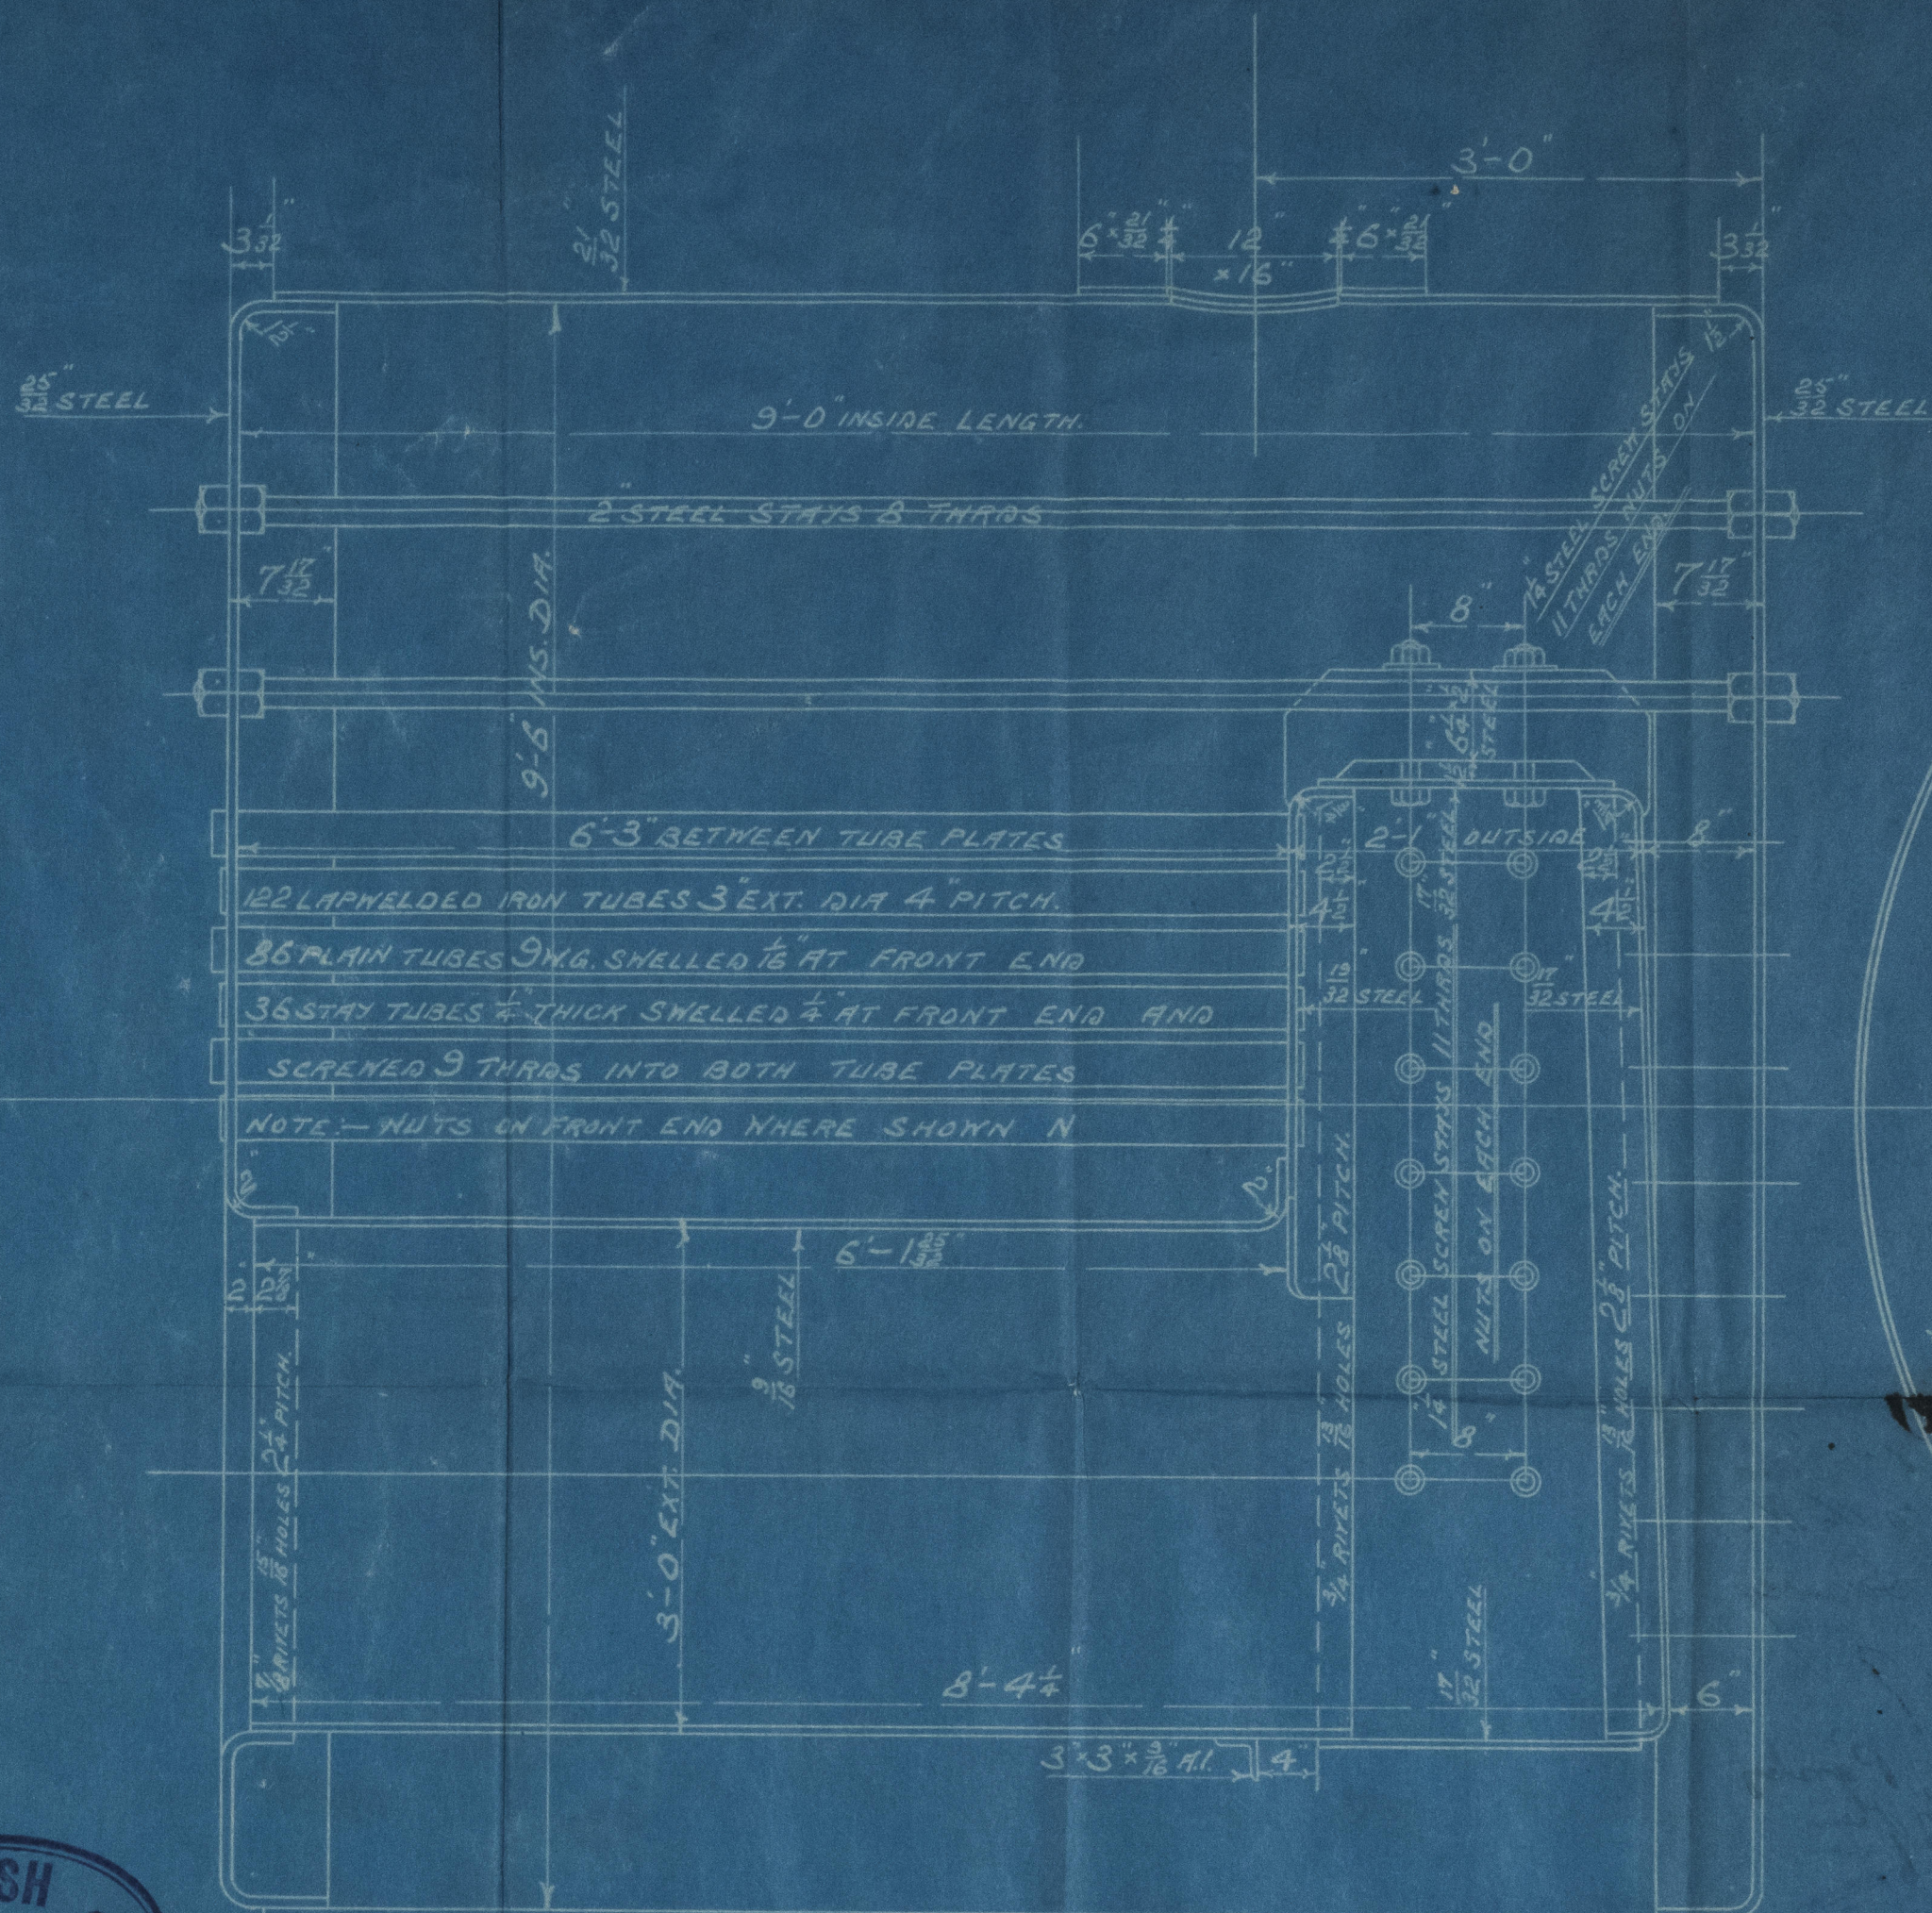

HEATING SURFACE ON TUBES	598.8
ON FRAMES	59.0
ON CHAMBERS	95.0
TOTAL	752.8
GATE AREA 5'-0" DEEP	= 29
RATIO G.A. TO H.S.	= 1.25
AREA TWO TUBES	= 686.3

BOILER No 249.

R


Lloyd's Register
Foundations
WISSE-0229

Marine Boiler 9'-6" dia
x 9'-0" long for 130 lbs H.P.
Under Lloyd's Survey

No 249.


for Fisher & Co, Paisley
to be paid by them
Engine No 166.

do. No 270.

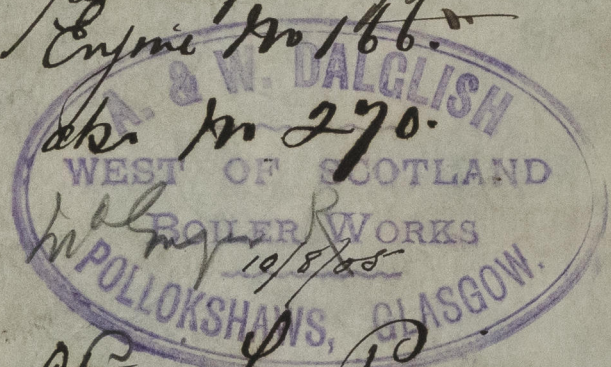


Steaming Pioneer

Dated 1/3/06

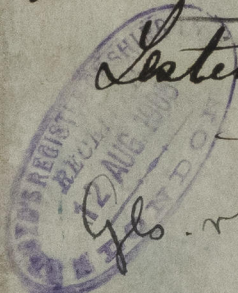

Gls. rht. 23902

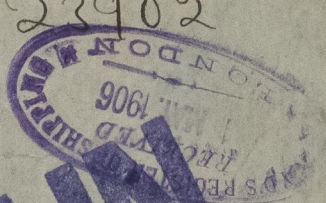

RETAIN



© 2021

Lloyd's Register
Foundation

W1550-0229