

PROPOS-STEEL SCREW TUG.

No 20

MOULDED DIMENSIONS. 69'-0" x 15'-0" x 8'-6"

SCALE $\frac{3}{4}$ " = ONE FOOT.

10.8.05
17.8.05

LLOYDS NUMERALS.


$\frac{1}{2}$ BEAM	7.5
$\frac{1}{2}$ CIRTH	13.6
$\frac{1}{2}$ DEPTH	8.8
	29.9 1 ST K.
	68
	2392
	1794
	2033 2.2 ND N.

RIVETING

OK. STRINGER: BUTTS DOUBLE & SEAMS SINGLE RIV.
CARBOARD STRAKE: BUTTS FLUSH STRAPPED &
DOUBLE RIV.
CARBOARD TO LOWER EDGE OF SHEER STRAKE: BUTTS
OVERLAPPED & DOUBLE RIV.
SHEER STRAKE: BUTTS FLUSH STRAPPED & DOUBLE RIV.
BULWARKS: BUTTS SINGLE RIV.
ALL LANDINGS SINGLE RIV. EXCEPT LOWER
EDGE OF SHEER STRAKE WHICH IS DOUBLE RIV.

ANCHORS & C

1. ANCHOR $4\frac{1}{2}$ CWTs. EX. STOCK
1 " 2 $\frac{1}{2}$ " " "
60 FTHMS $\frac{12}{16}$ SHORT LINK CHAIN
60 " $4\frac{1}{2}$ MANILA
60 " 2 $\frac{1}{2}$ "

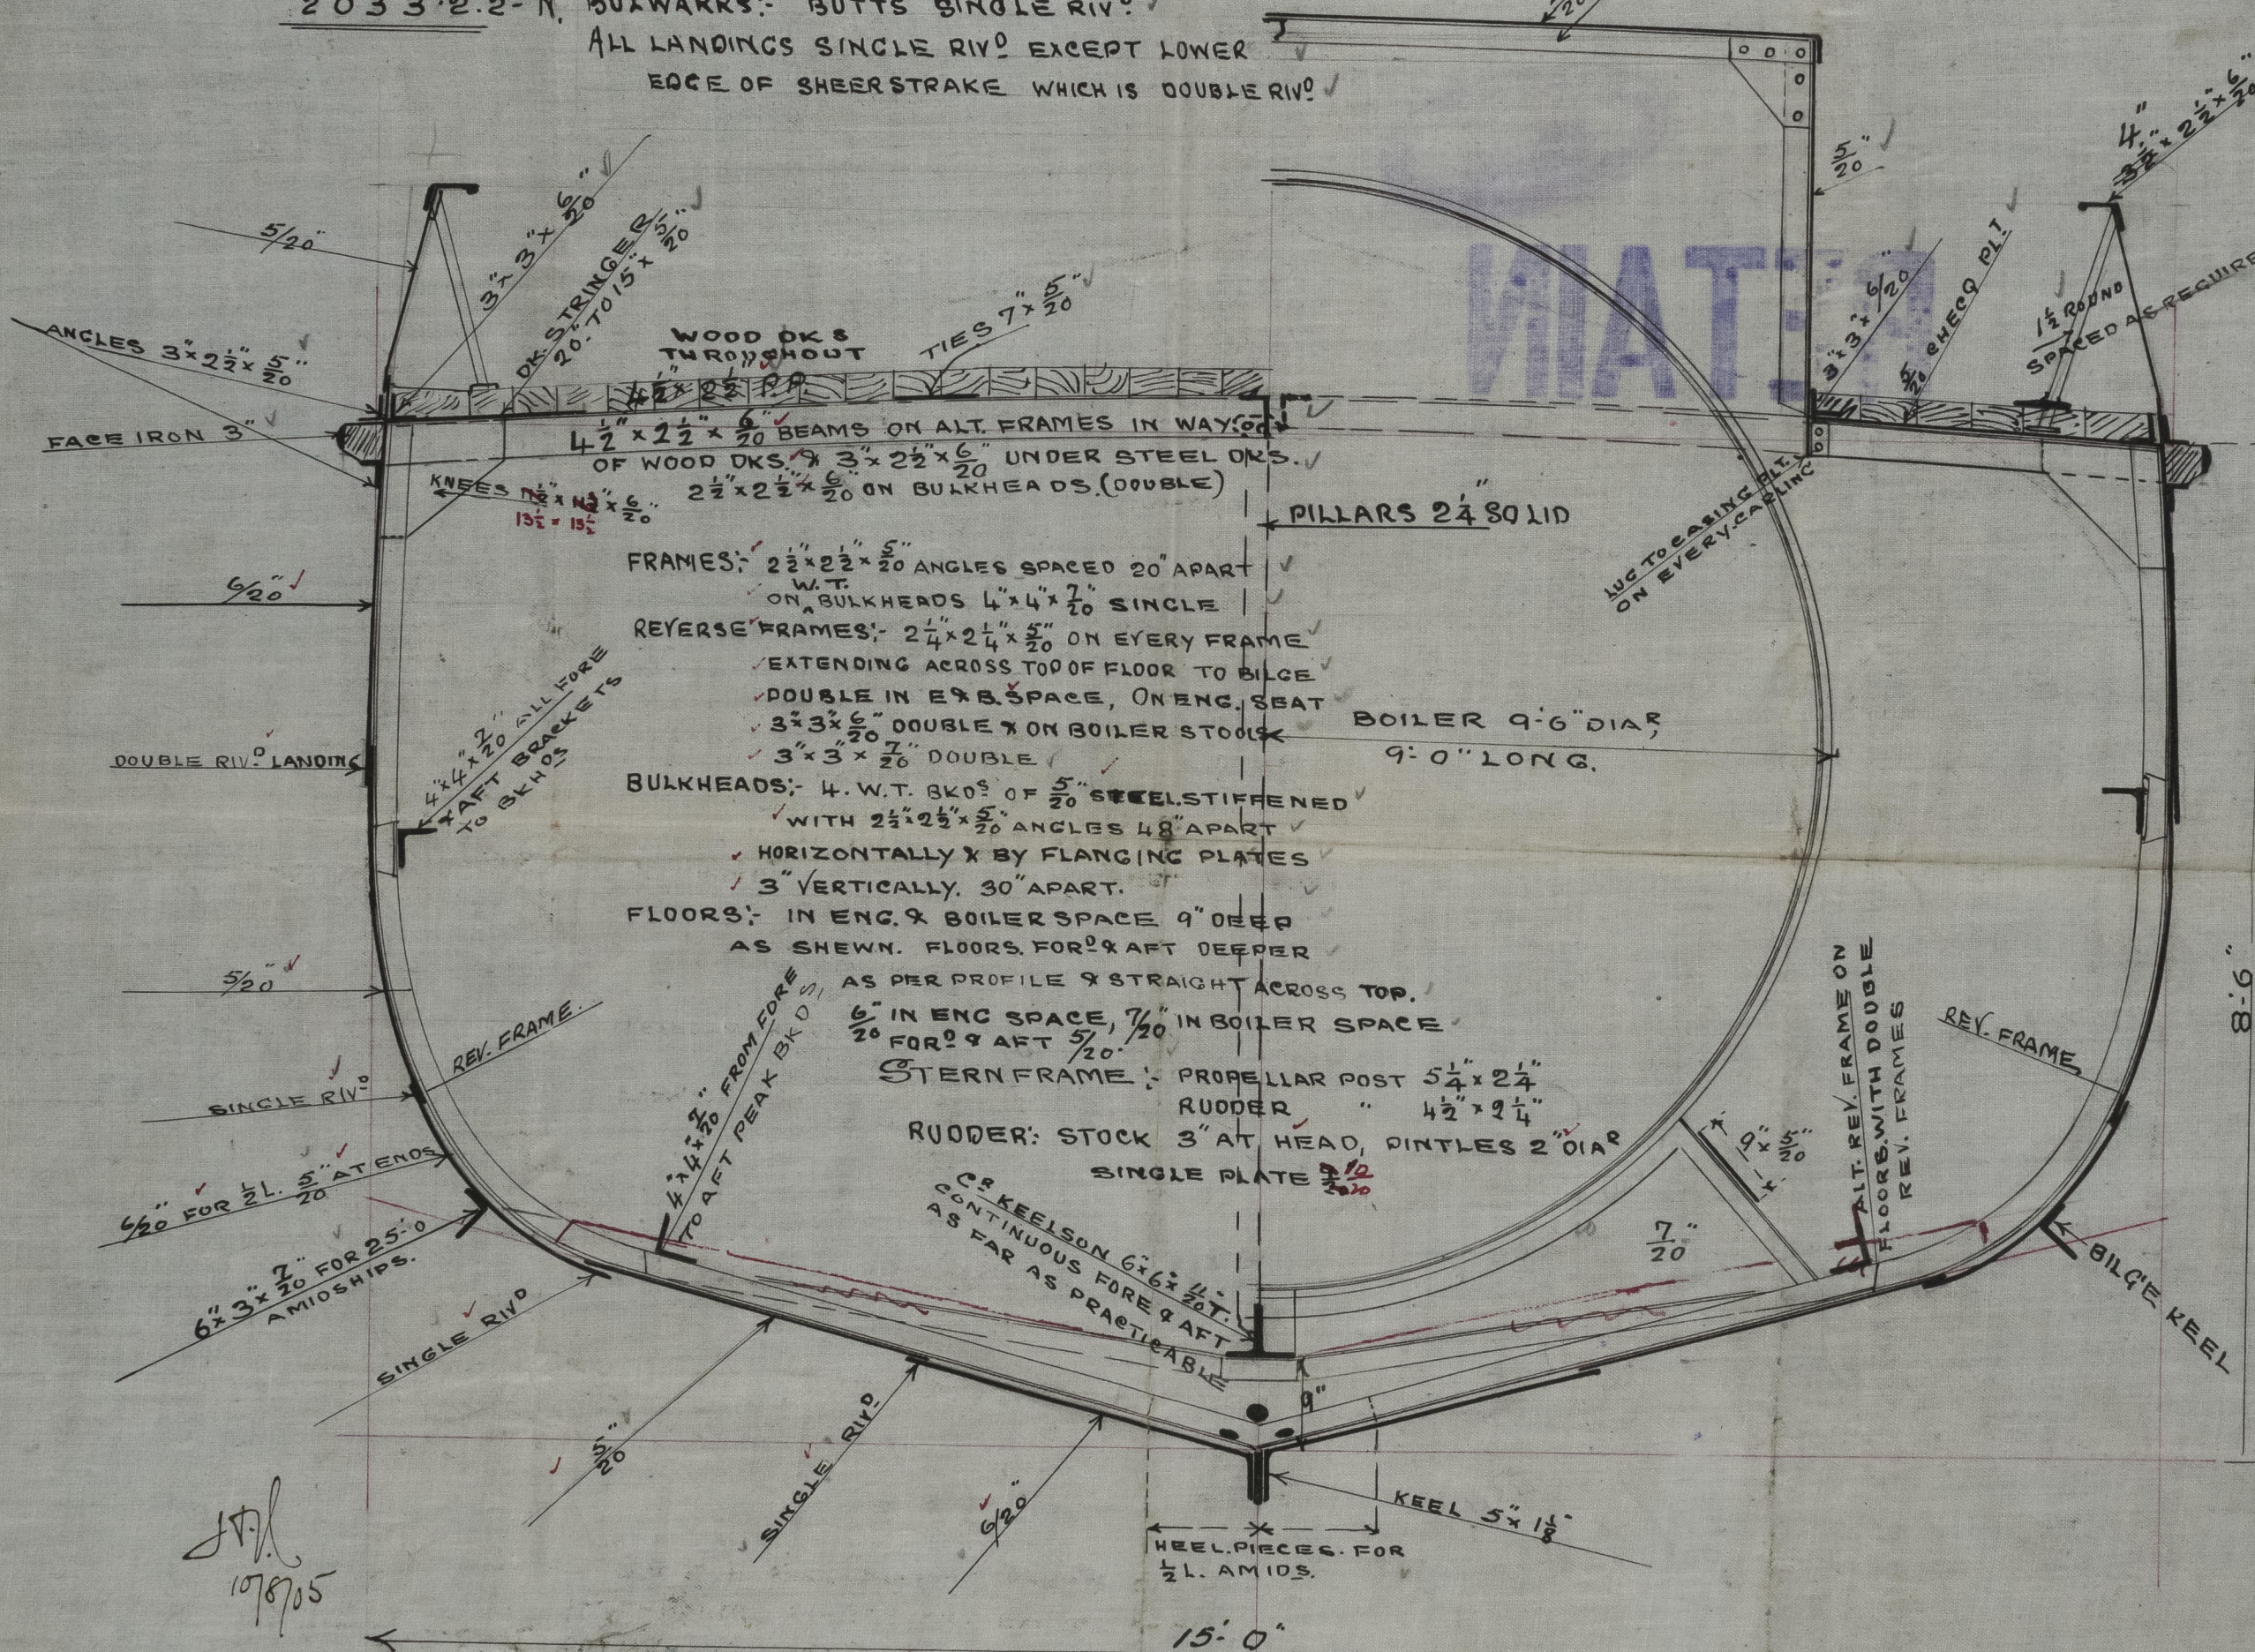

J.H.L.
1078705

PM Gregor
pro. S S Tug No 20

"Pioneer"
 Ges. rpt. no. 23902

ms

RETAIN

WISSO-0230

Lloyd's Register
Foundation