



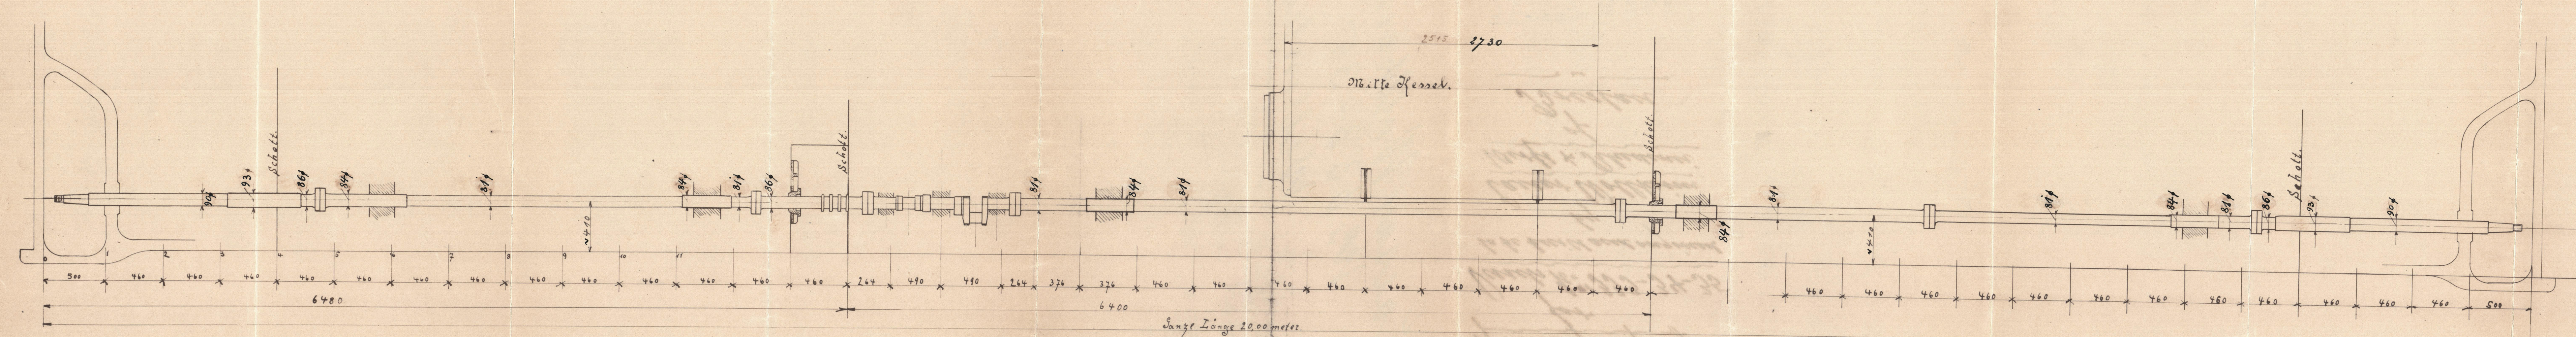

J.R.R.  
20.7.10

CAESAR WOLLHEIM, WERFT and RHEDERER  
COBEL bei BRESLAW.

[illegible]

Ind. 9. 14.6.10.

© 2021

Lloyd's

Found

W1551-19



Hand. Rept. No. 11788-89-90

No. 11  
No. 12  
No. 13 } of Constantinople

Hand. Rept. No. 12.10. 1888


Approved Plan  
of Site of Shafing  
for

Vanch No. 333-34-35

to be built and engineered  
by

Cesar Wollheim  
Wolff & Rhedeni  
of  
Breslau

RETAIN

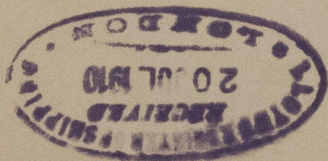

11



© 2021

Lloyd's Register  
Foundation

W551-187

Cesar Wollheim  
Nos 333-35

Wollheim