


Profile & Deck Plan  
 S.S. 175' 28" 13' 0" N° 215  
 26.10.09  
 9.11.09  
 17.12.09

PROFILE AND DECK PLAN OF S.S. 175' 28" 13' 0" N° 215  
 SCALE 1/4" INCH = ONE FOOT  
 TO CLASS 100 A.I. AT LLOYD'S AND BE BUILT UNDER SPECIAL SURVEY

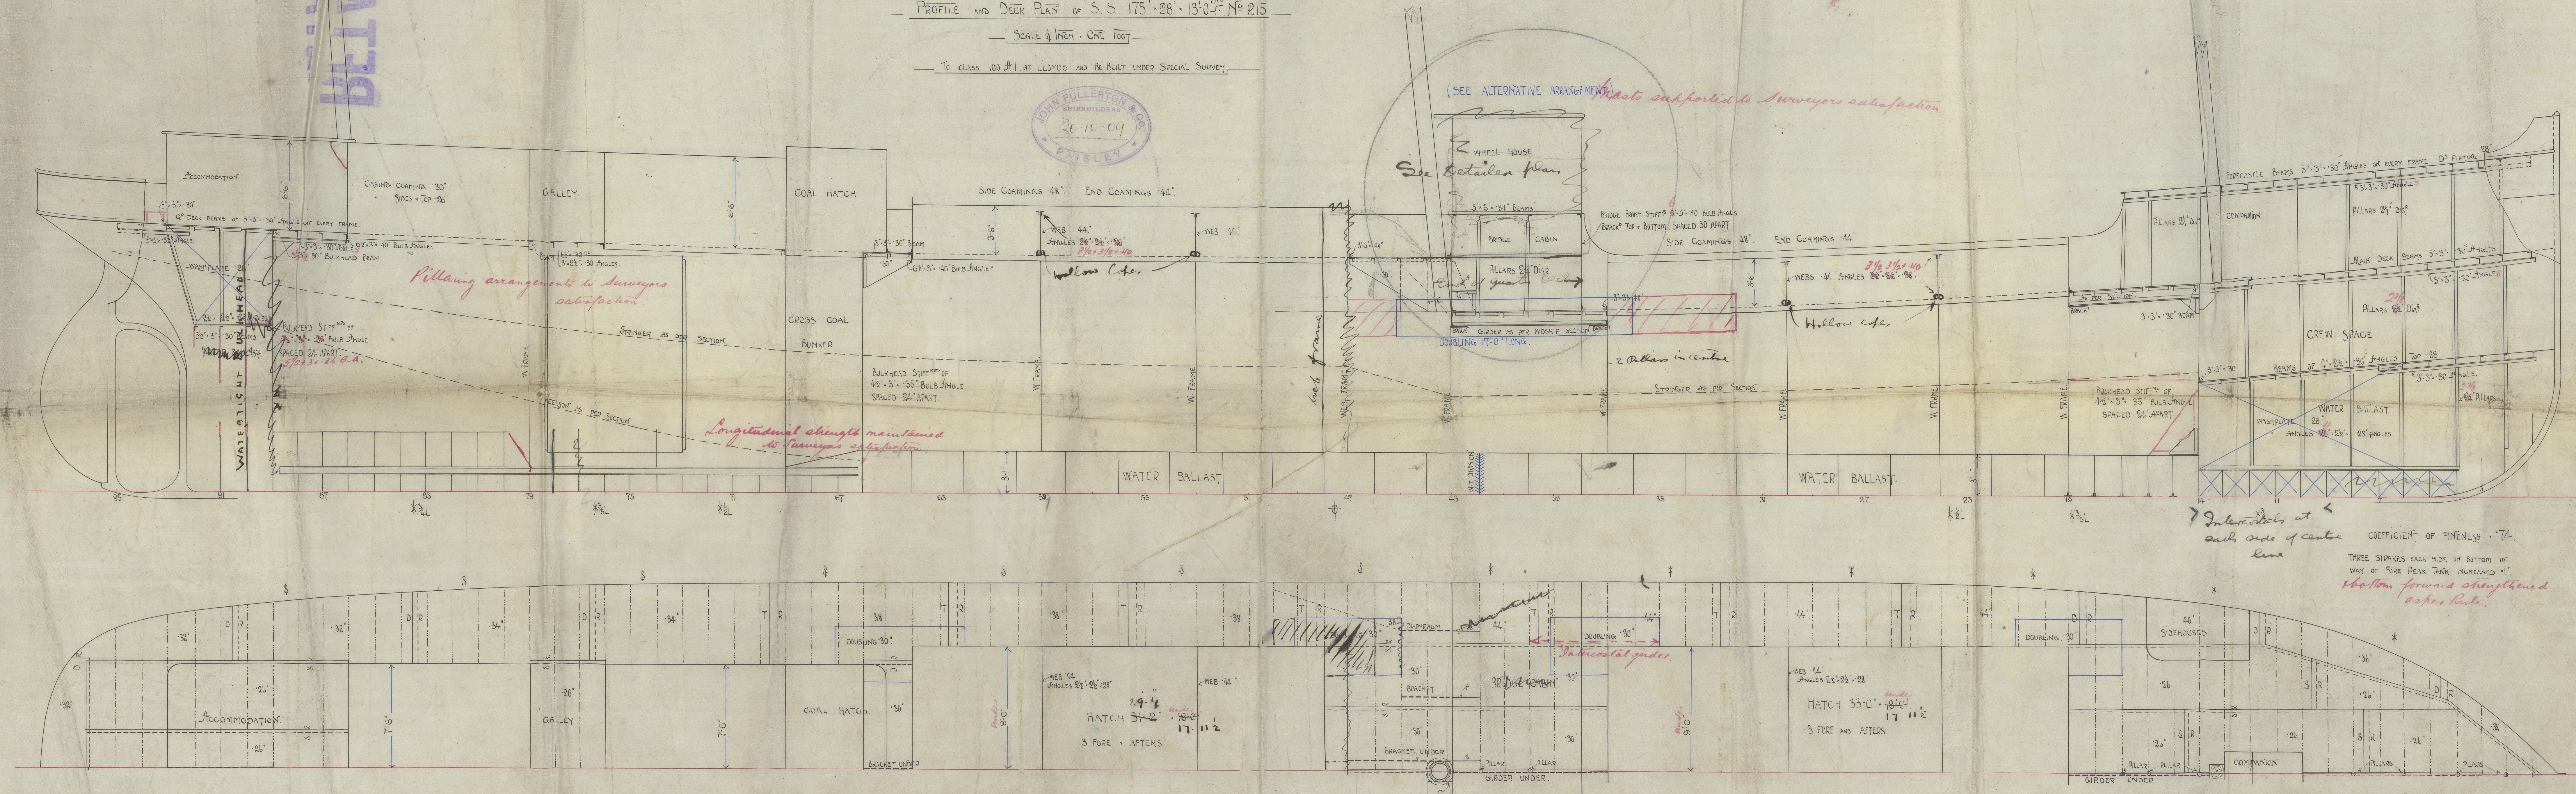

 COEFFICIENT OF FINENESS .74.  
 THREE STOKES EACH SIDE OF BOTTOM IN WAY OF FORE PEAK TANK INCREASED 1".  
 Bottom forward strengthened as per Rule.

C.T.  
 26/10/09



Profile & Deck Plan

Mess J Julieton & Co

No 215

5/5 "Primrose"

28852







© 2021

Lloyd's Register  
Foundation

WISS3-0065