



27. 10. 70
14. 11. 10

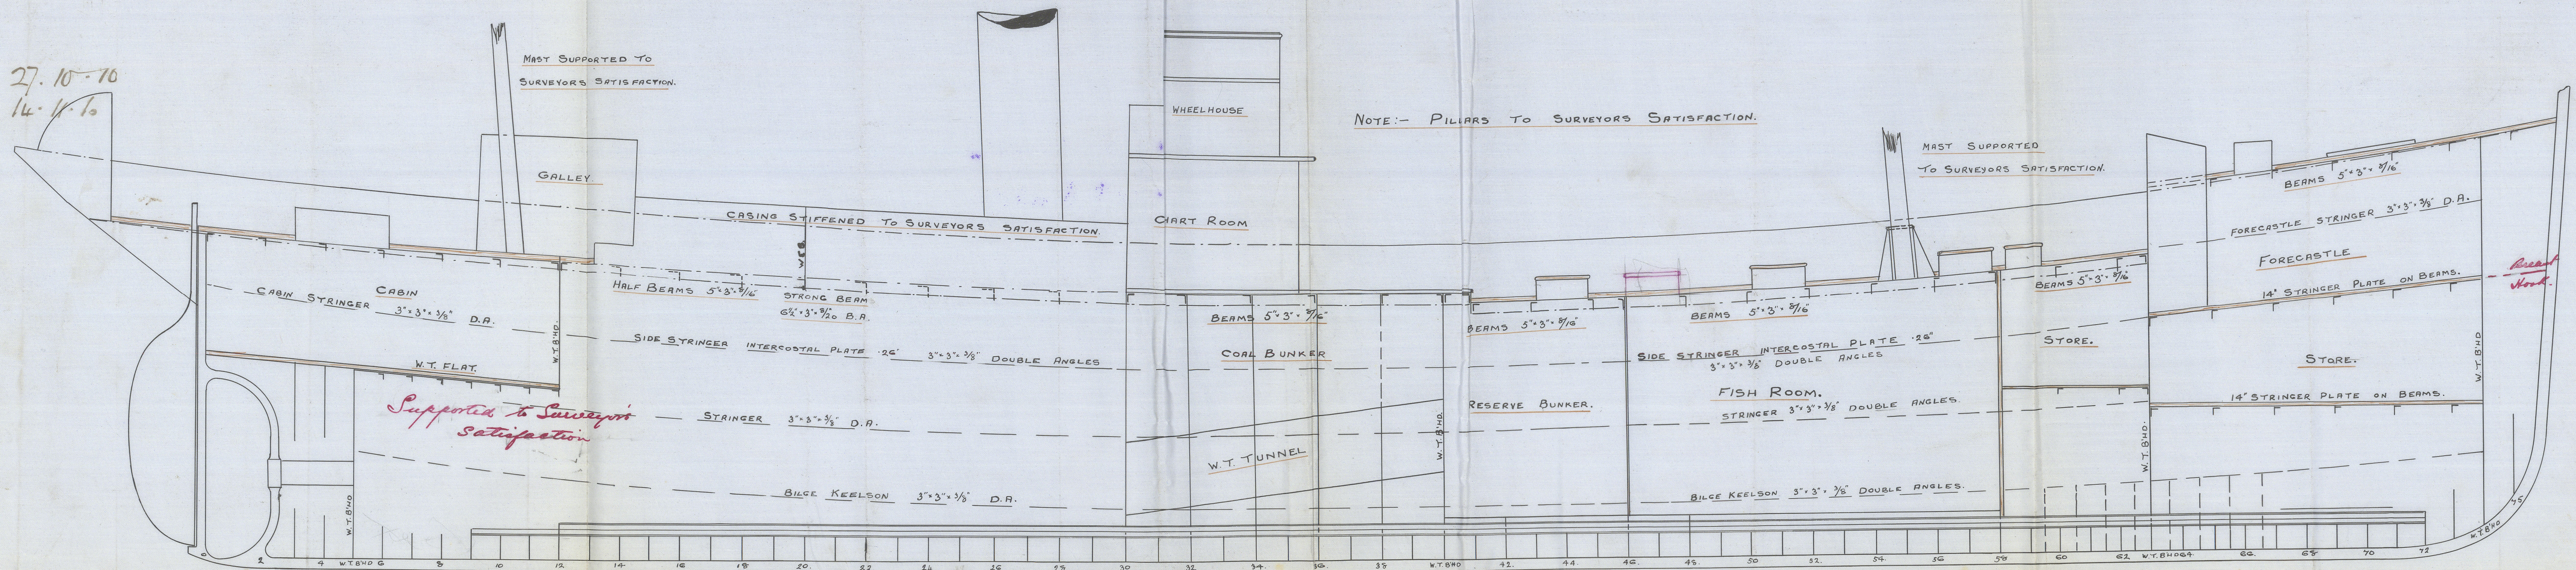

NOTE:- PILLARS TO SURVEYORS SATISFACTION.

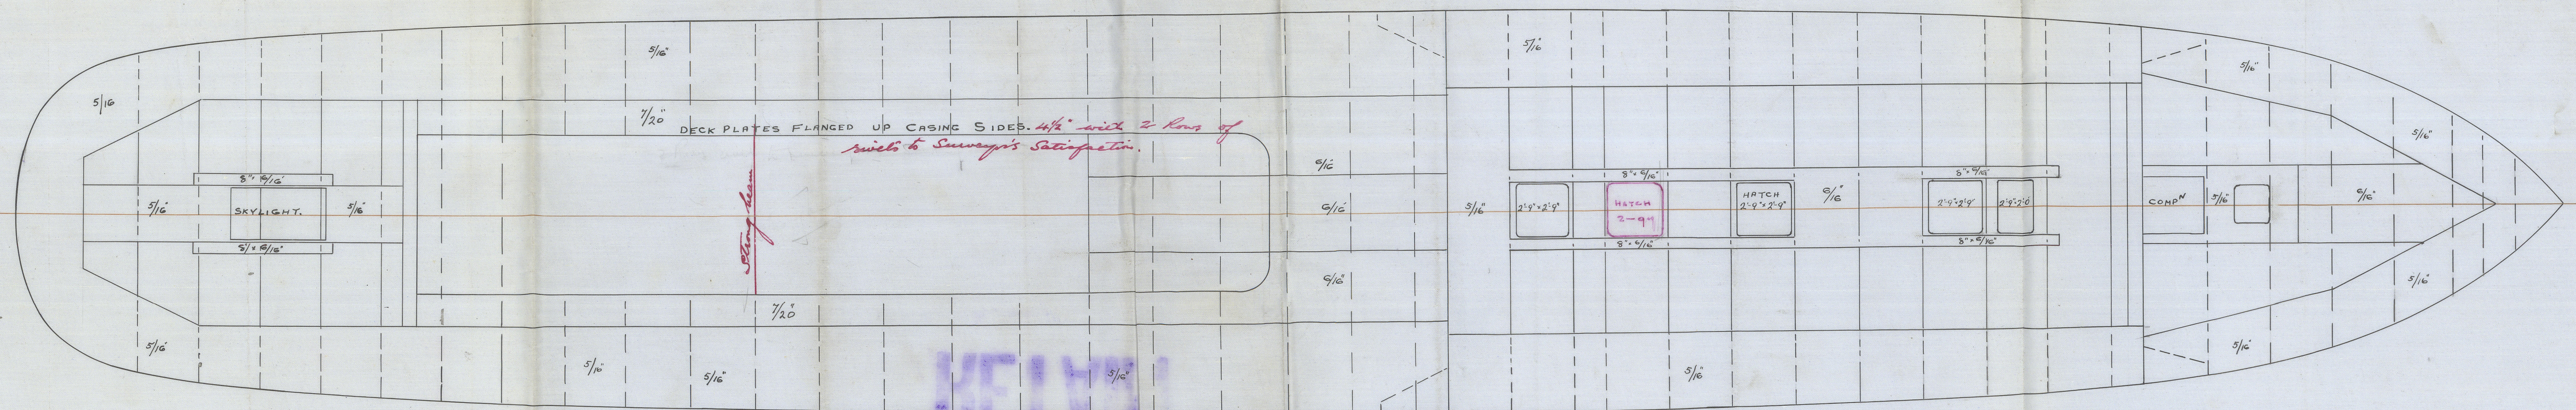

PROFILE & DECK PLAN.

STEEL SCREW TRAWLERS.

N^{OS} 4.83-4.

SCALE $\frac{1}{4}" = \text{ONE FOOT.}$

PLAN No. 9728
FOR ENCLOSURE TO
Messrs. Lloyd's Surveyors
Hall
COCHRANE & SONS,
SHIPBUILDERS,
DATE 25/10/10 RR

C.B.
27.10.10.

Profile Deck Plan
Cochrane & Sons

Nos 483 & 484

Is Orca des Halls R/L 23875

- Lacerta

23897

SCALE 1" = 10'

N 483-4

2 LEE

2 CBE

1 BVMGE

BBOLIGE & DECK BL

RETAIN

2/10

2/10

1/10

HALF BEAMS 3'5"

LONG BEAM

3'5"

SIDE STRANES

UNDERGIRD PLATE

24

3'5"

DOUBLE

STRANES

3'5"

DECK PLATES ETCHED

NO CHANG

SIDES

1/10

2/10

BLUE KEELSON

3'5"

P.R.



© 2021

Lloyd's Register
Foundation

WISS3-0153