


11. 10. 10
15. 10. 10

TO CLASS A.1. FOR RIVERS PARANA & PLATE NAVIGATION

DIMS: LENGTH B.P. 175'-0" x BREADTH EX: 28'-0" x DEPTH MLD: 10'-0"

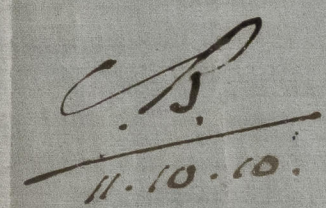

Boat Shipbuilding & Rep. Co. Ltd

No 138.

Profile & Deck Plan.


s/s Oran

Hull Rph No. 23719

Unclassified

How Tedalah

RETAIN

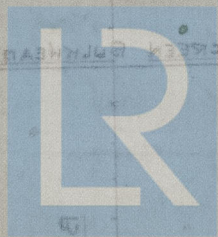

© 2021

Lloyd's Register
Foundation

W1554-0057