


MIDSHIP SECTION OF A STEEL SCREW STEAMER
TO CLASS A.1. FOR RIVERS PARANA & PLATE NAVIGATION

DIMENSIONS. 175'-0" B.P. x 28'-0" EX. x 10'-0" MOULDED.

$$L/\eta = 17.5.$$

GLoucester SHIPBUILDERS & REPAIRING CO. LTD.
SHIPBUILDERS & ENGINEERS
8/10/10
VICTORIA STOWARD, GOOLE

1	BOWER ANCHOR	10 1/4 CWTs	\$ STOCKLESS
1	"	9 3/4	"
1	"	7	EX STOCK
1	STREAM ANCHOR	3 1/2	"
1	KEDGE	1 1/2	"
210	FMS: 1 1/8"	STUD CHAIN CABLE	✓
60	"	2 3/4"	STEEL WIRE ✓
75	"	2 1/2"	" " ✓
90	"	5 1/2"	HAWSER ✓

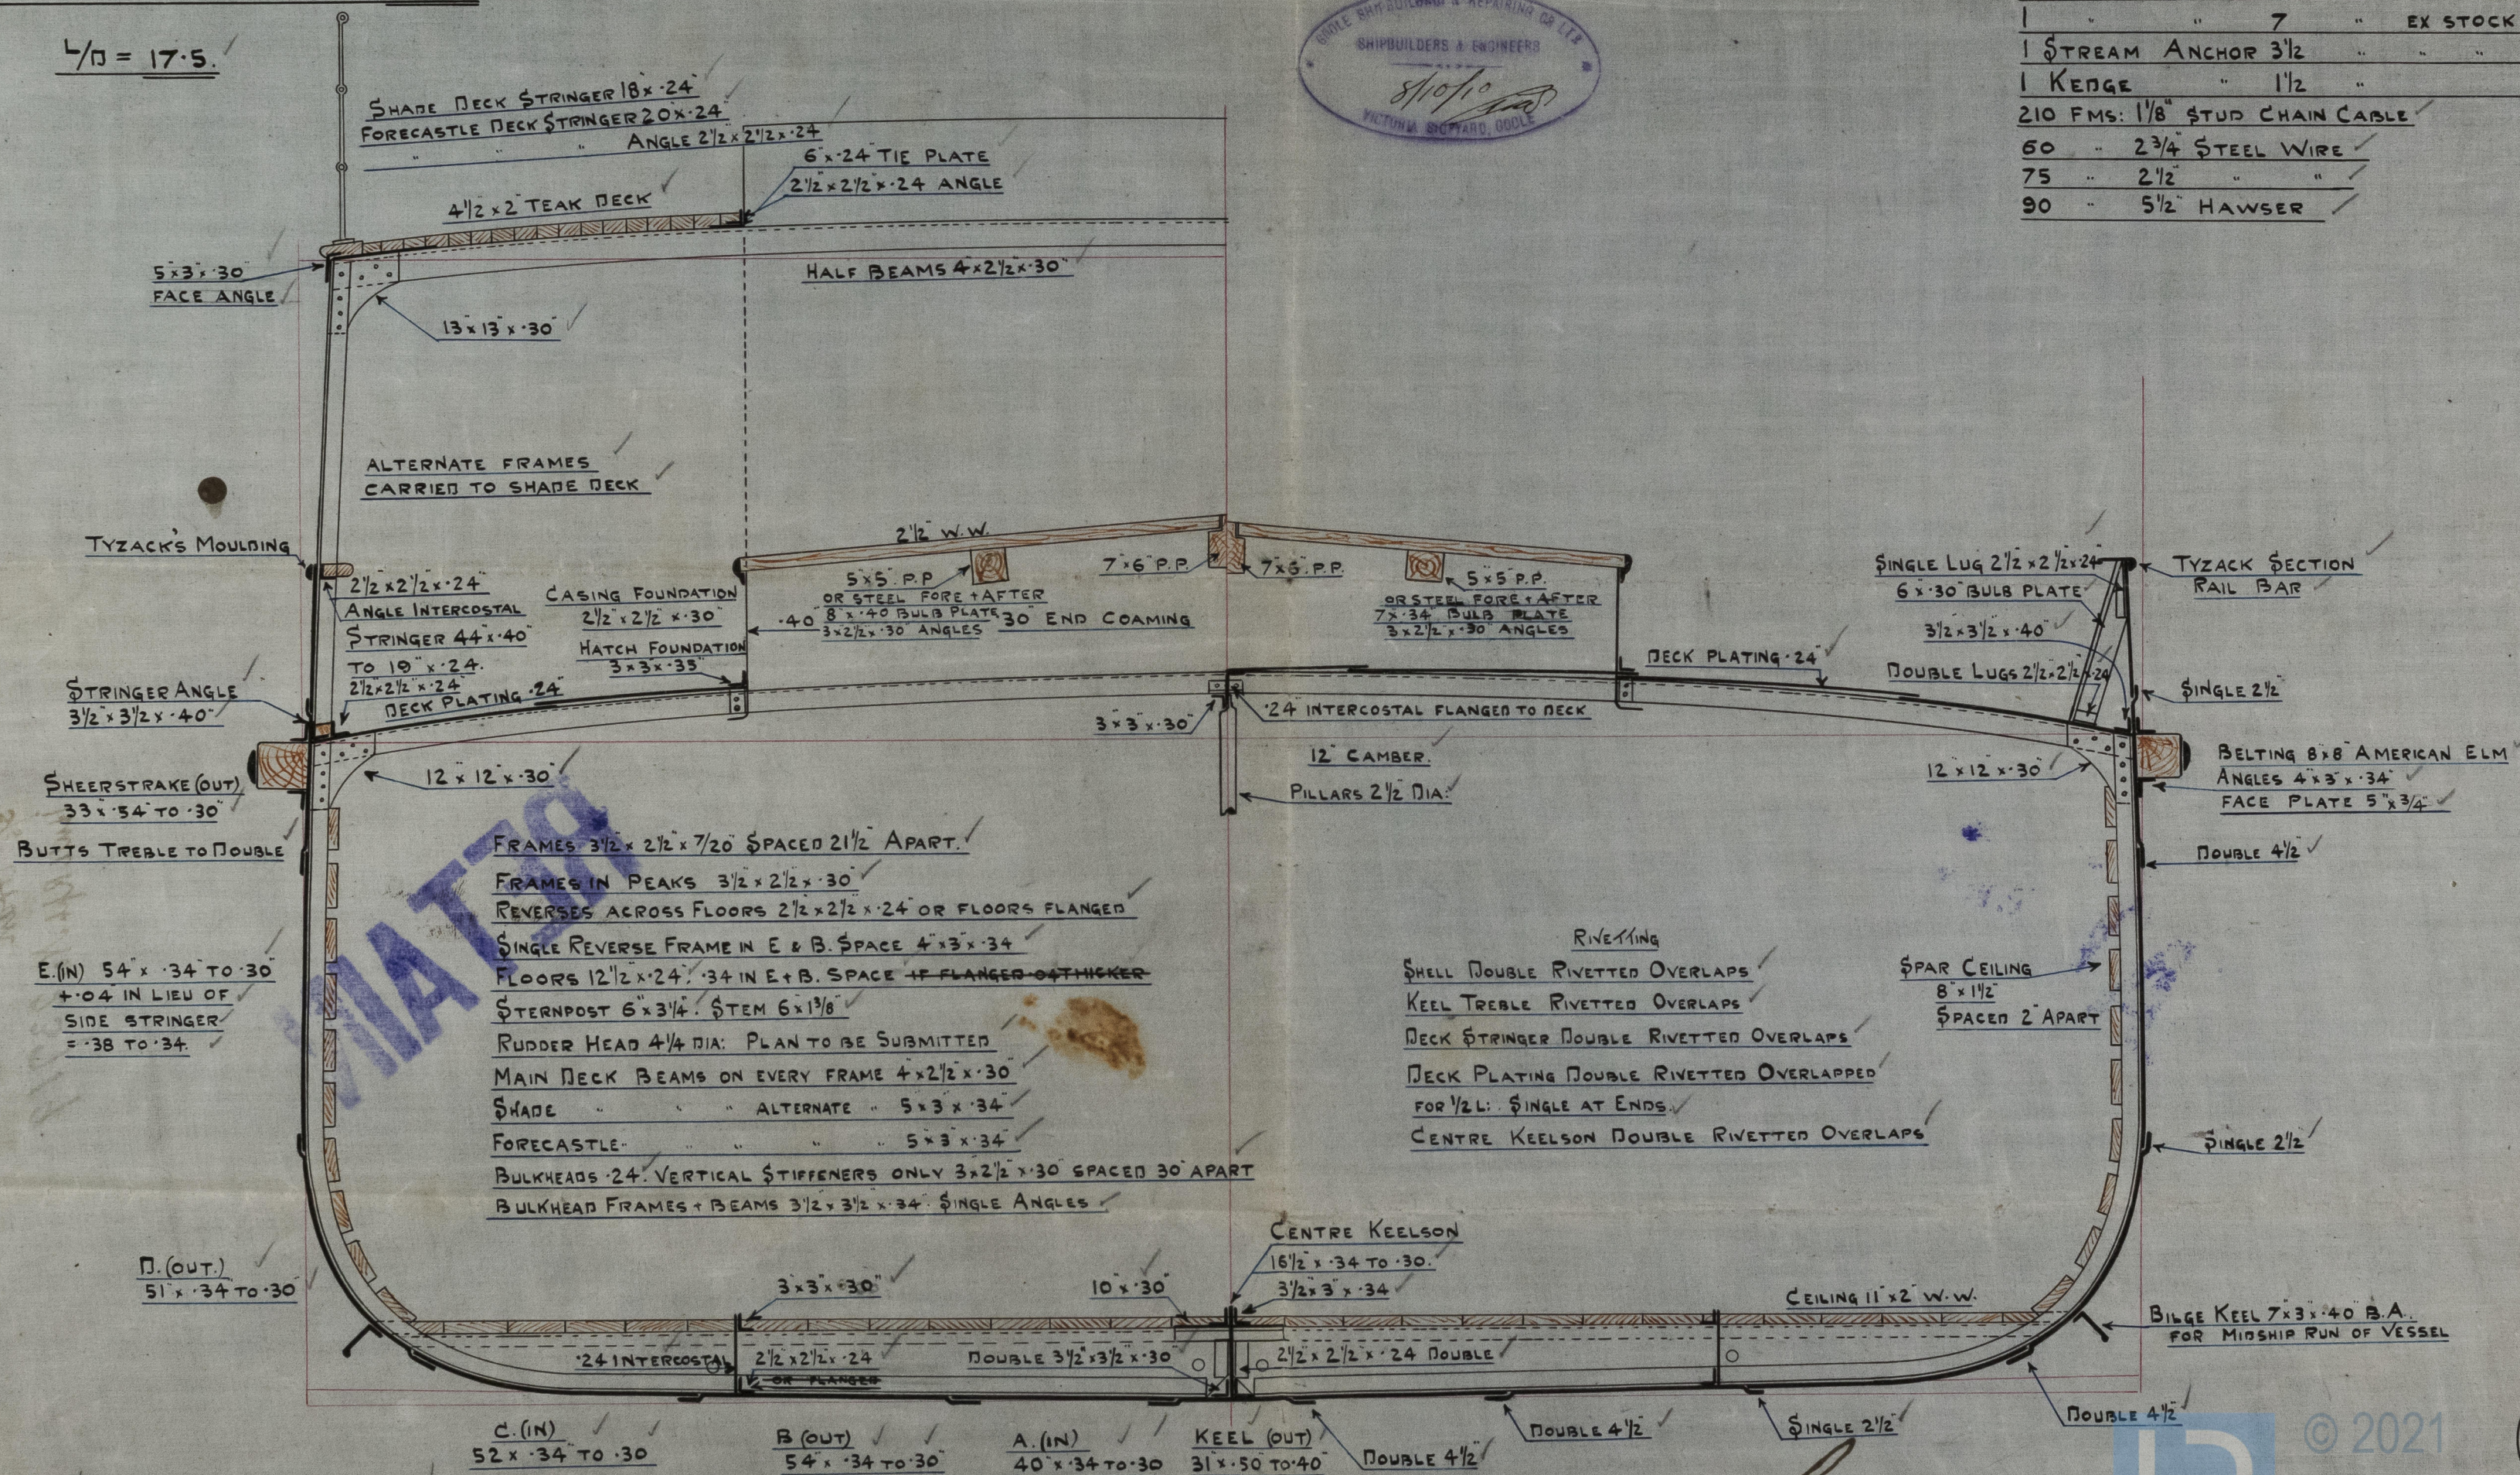

C.B.
11. 10. 10

Boole Shipbuilding & Rep. Co. Ltd.
No 138.
Midship Section.

3/5 Oran

Hull Rpt. No. 23719

Unclashed
"Zealab"

RETAIN


