

Nº 1006 MAIN BOILER

75/8

CRACK $2\frac{1}{4}$ LONG

5/8 STUD SCREWED IN
AND FLUSH RIVETED

that there is not needed
and act as in case of
such as marine battery to the
have them fixed


hmk

POSITION OF CRACK
ABOUT 7" TO STARB^d
SIDE FROM CENTRE

STARBU

Port

FORWARD BOILER

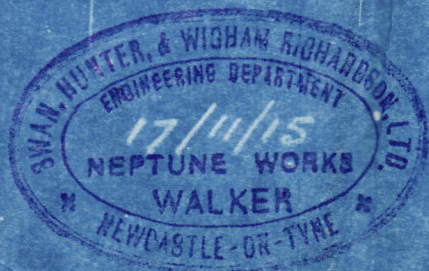

Nº 7260

Lloyd's Register
Foundation

Boiled
No 1006

See Amended print

H.M.S. PRIMOLA

NEWCASTLE ON TYNE.

Report No. 68366


RETAIN



© 2021

Lloyd's Register
Foundation

W1555-0102

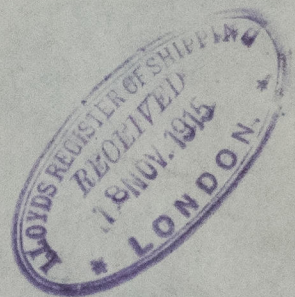

W1555-0102.

W1555-0102



© 2021

Lloyd's Register
Foundation