



24.2.03
 LLOYD'S REGISTER OF SHIPPING
 LONDON

BRIDGE.

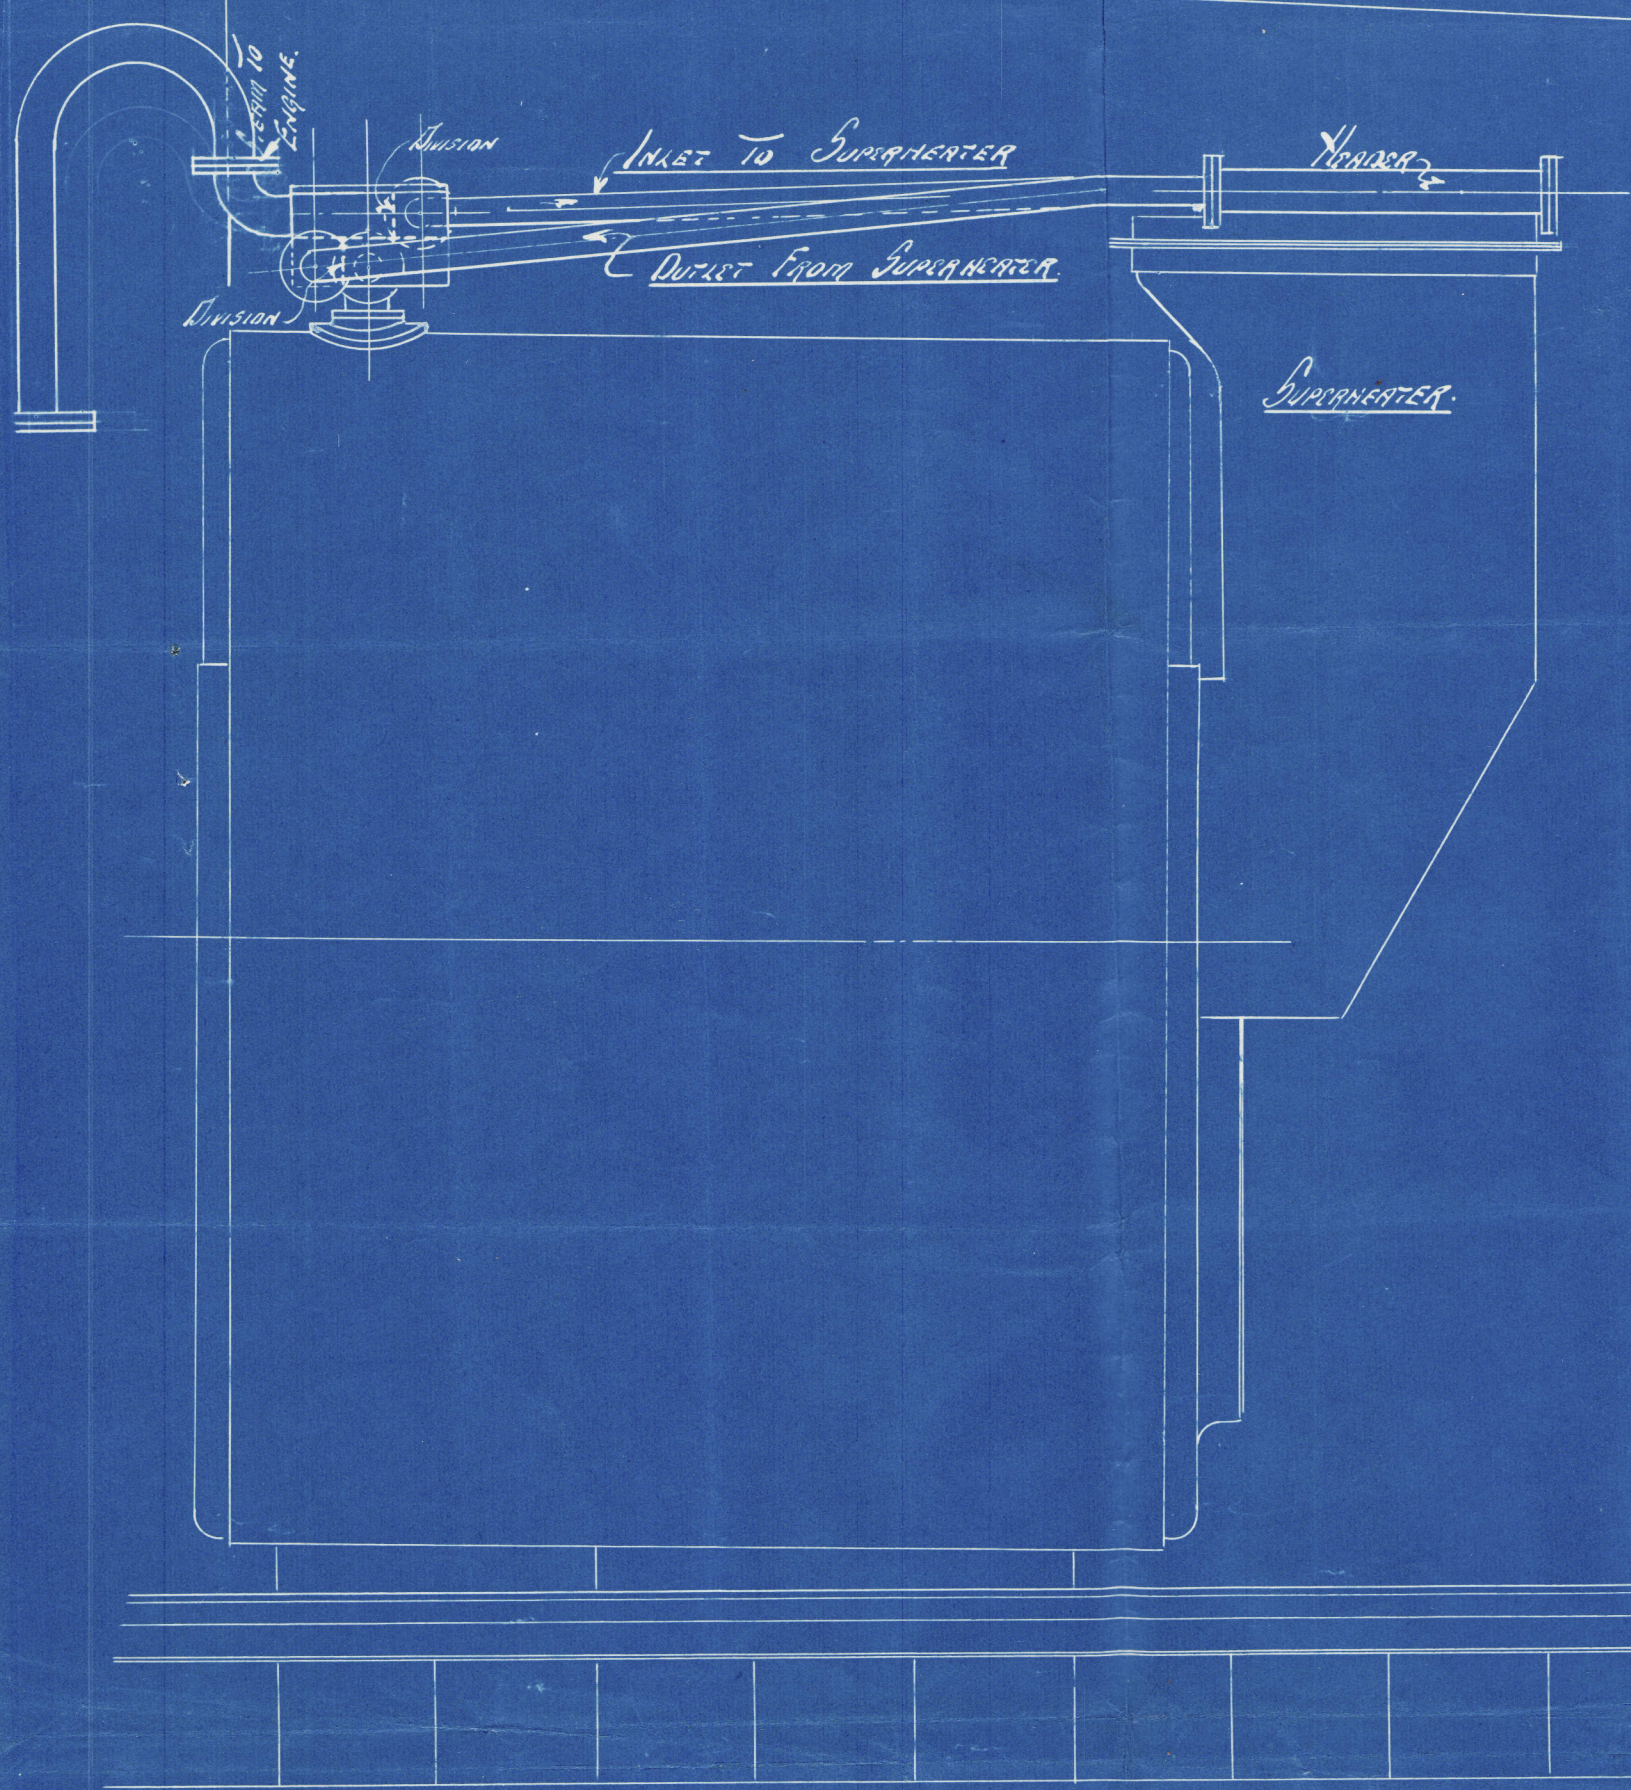

ARRANGEMENT OF STEAM PIPES
 TO SUPERHEATER. M. H. H.
 SCALE $\frac{1}{2}$ " = ONE FOOT

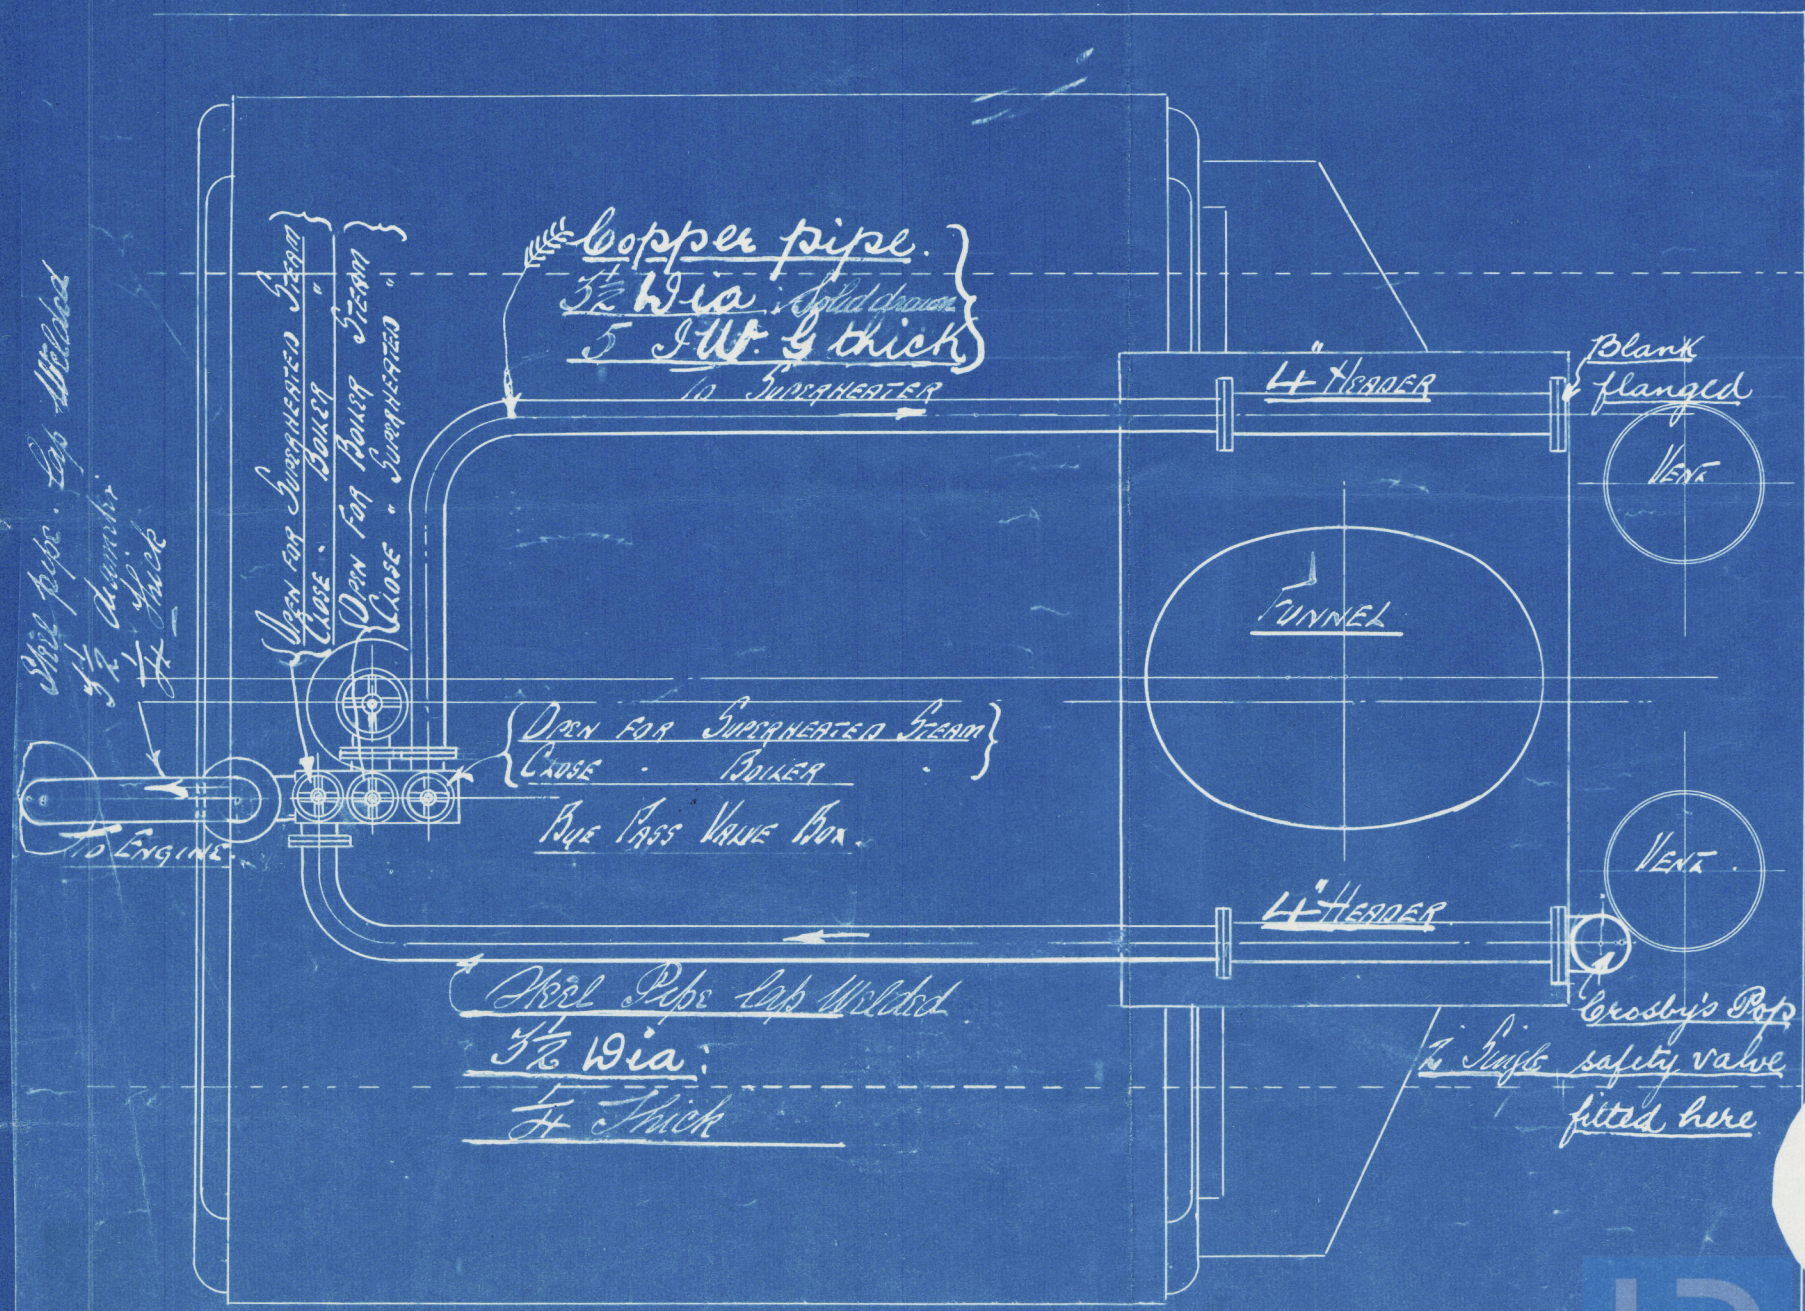

J. M.
 21/2/03

19/2/03
 25/1/03
 11-20/2/03
 LLOYD'S REGISTER OF SHIPPING
 20 FEB. 1903
 HULL DISTRICT

W1555-0182 2 1/2

© 2021

From AMOS & SMITH, HULL.

Enclosure for

Lloyd's Register
Hull

W1555-0182 1/2

Hull "Superheater"
arrangement of steam pipes

Amos & Smiths No. 345

for Cook, Walton & Semmelle No. 23 $\frac{1}{2}$

S/S Perrella
Hull Report No. 15232

RETAIN



© 2021

Lloyd's Register
Foundation

W1555-0182 $\frac{1}{2}$