


MIDSHIP SECTION STEEL SCREW TRAWLER

Nº 344.

LENGTH 123'-6" x BREADTH 22'-0" x DEPTH 12'-4" MOULDED
SCALE 1/2" = 1 FOOT.

To BE CLASSED 100.A.1. STEAM TRAWLER.

RAISED Q^R D^K 67'-0" RAISED FORECASTLE D^K 20'-0"

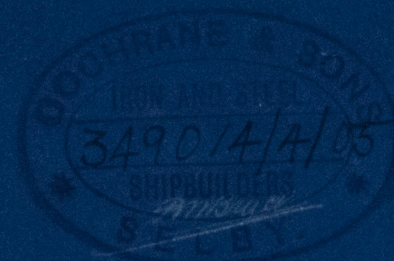

E & B. CASING AS PREVIOUSLY APPROVED.
DECK PLATED OVER IN WAY OF E & B. CASING.

NUMERALS AS PER RULES

1/2 BREADTH	10.95.
1/2 GIRTH	19.25
DEPTH	12.80
	43.00 1 ST N.
RULE LENGTH	122.33
	5260.19 2 ND N.

PROPORTIONS.



DEPTH TO LENGTH = 9.5
BREADTH " " " = 5.5.

EQUIPMENT.

1 ST	BOWER	5 1/4	CWTS	EX STOCK
2 ND	"	4 3/4	"	"
3 RD	"	2 1/2	"	"
30	FATHS	1"	CABLE	
60	"	6"	HAWSER.	
60	"	4 1/2"	WARP.	

STANCHIONS IN
THWART BUNKER.
6 x 3 x 3/16 T IRON.



COCHRANE & SONS
SHIPBUILDERS
SELBY.

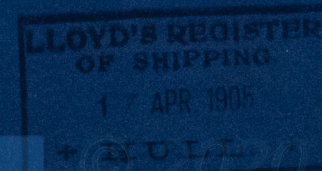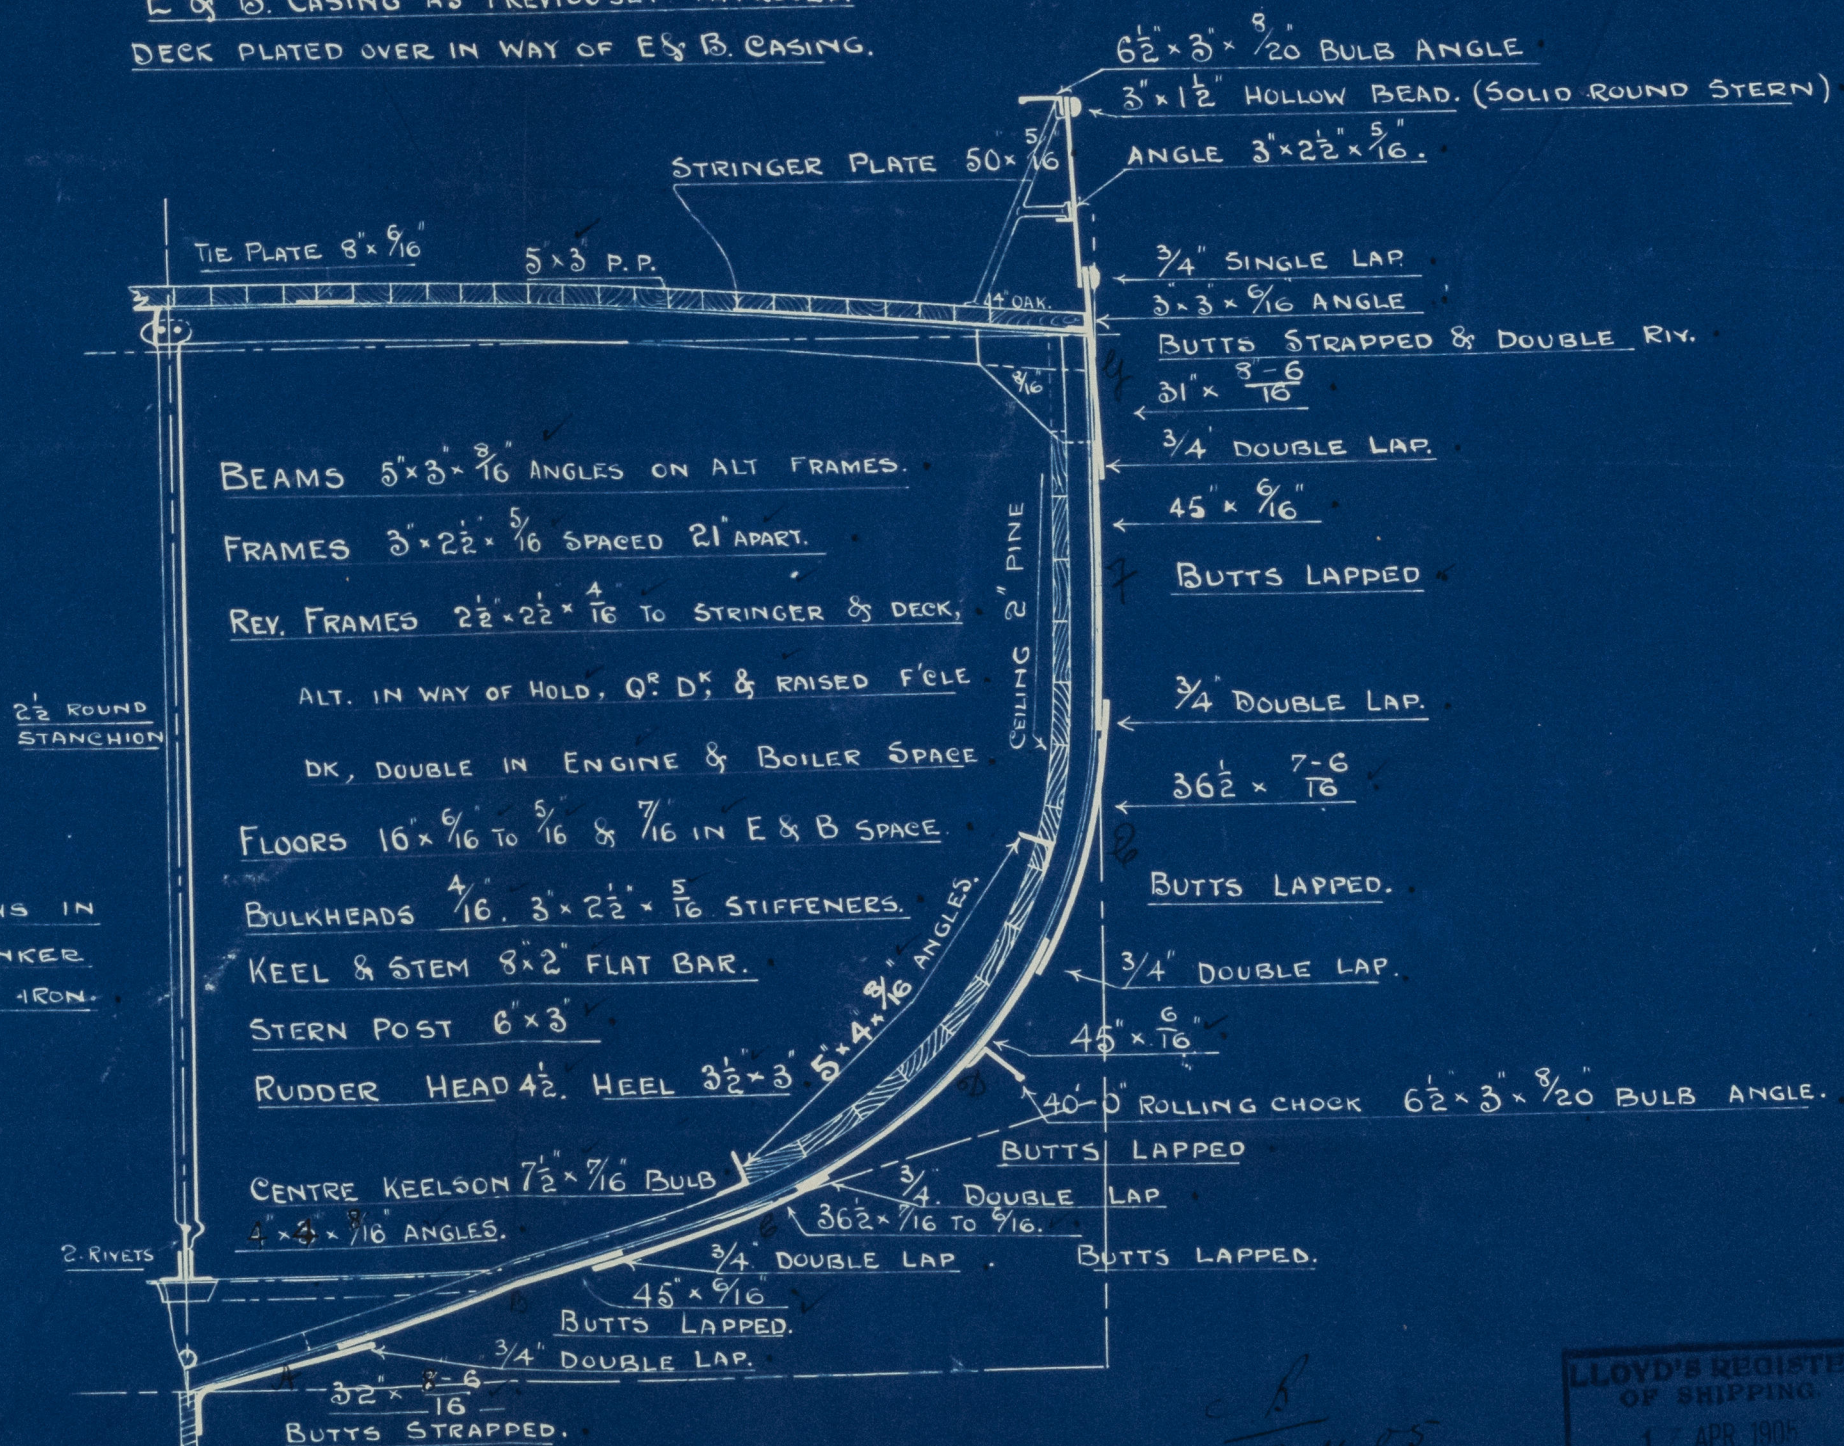

Cochran & Sons.

No 344.

Midship Section

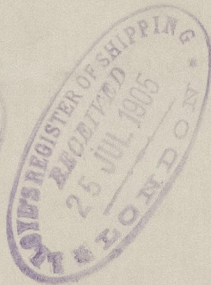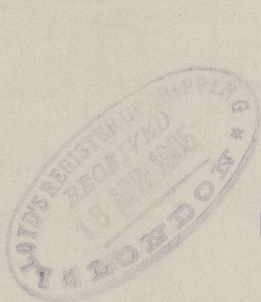

of 'St George'
Hull Report No. 17198



RECEIVED
LLOYD'S REGISTER
21 SEP 1905

W1556-0184



© 2020

Lloyd's Register
Foundation