


19.12.11
28.12.11
(481) 11.1.12
14.3.12

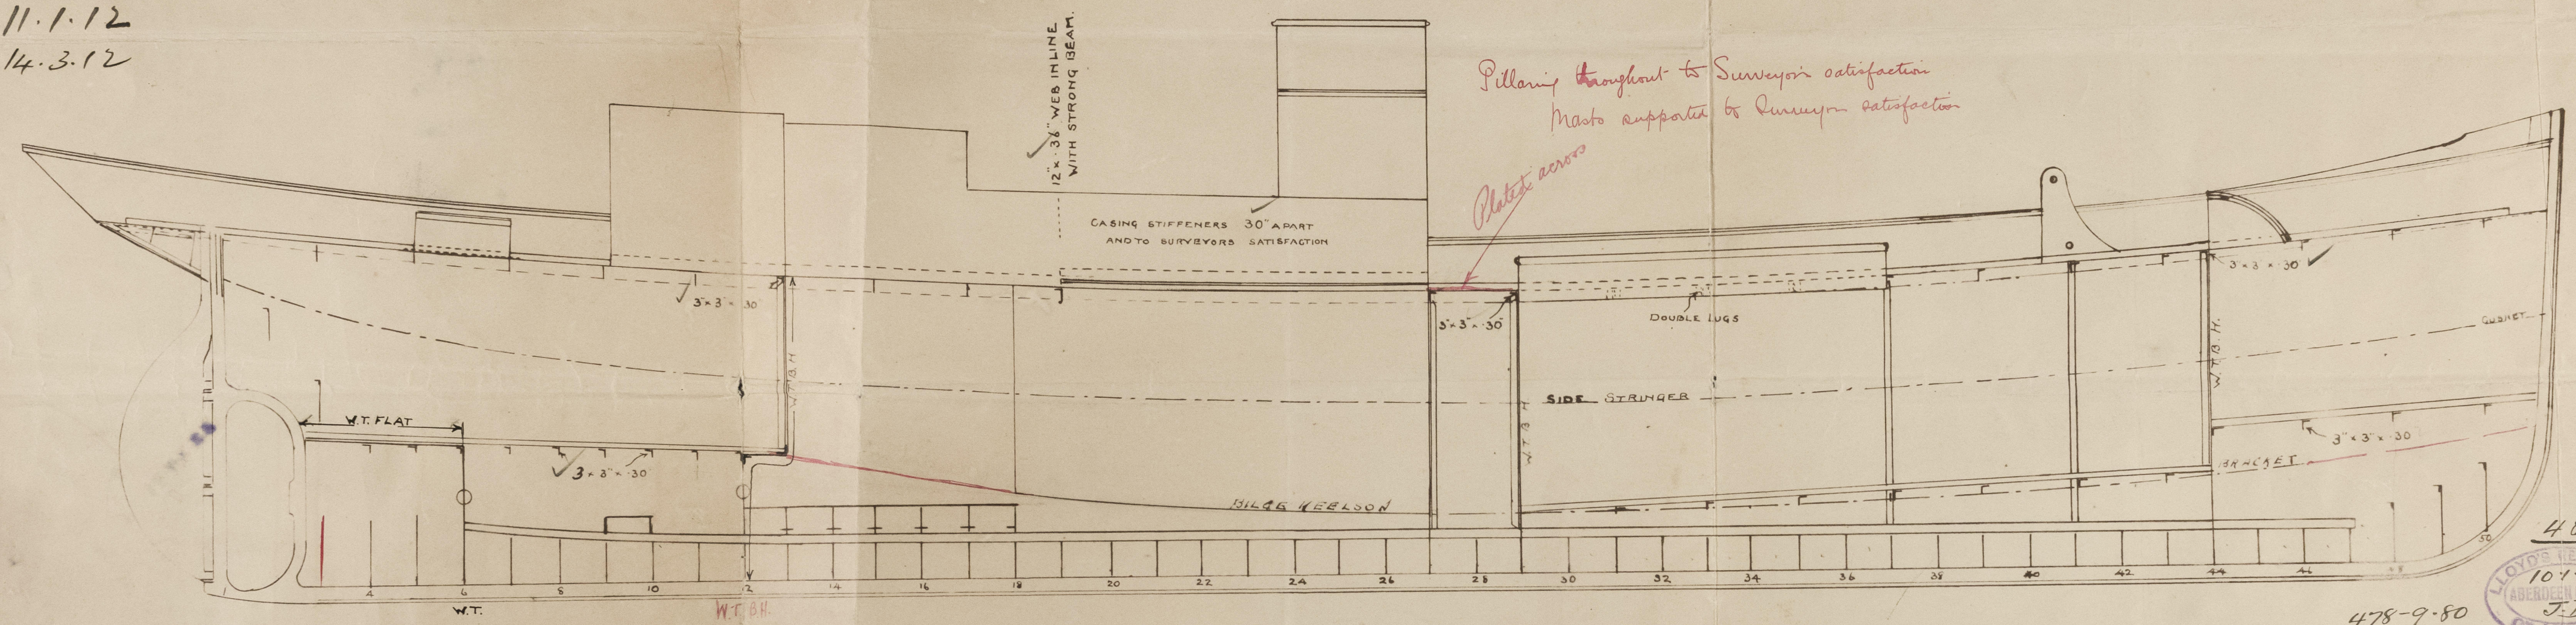

Pillaring throughout to Surveyor's satisfaction
Masts supported to Surveyor's satisfaction
Plating across

LONGITUDINAL SECTION


N^{os} 478-479-480-481

SCALE $\frac{1}{4}$ " = 1 FOOT.

ALEX^R HALL & Co., LTD.
SHIPBUILDERS, ENGINEERS & BOILERMAKERS,
ABERDEEN.

C.B.
11.1.12.
C.F.
19.12.11

478-9-80

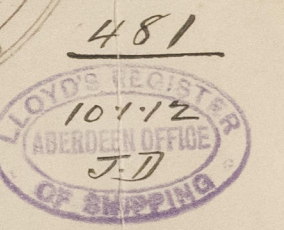

N^{os} 478. 479. 480.

A. Hall & Coy. L^d

Nos. 448-9-80-1

- Longitudinal Section -

448
S.S. "Plough".

Abn. Rpt. No. 10854.

449
S.S. "Mint".

Abn. Rpt. No. 10895.


480
S.S. "Surmount".

Abn. Rpt. No. 10898

481
S.S. "Ocean Reward".

Abn. Rpt. No 10915.

RETAIN

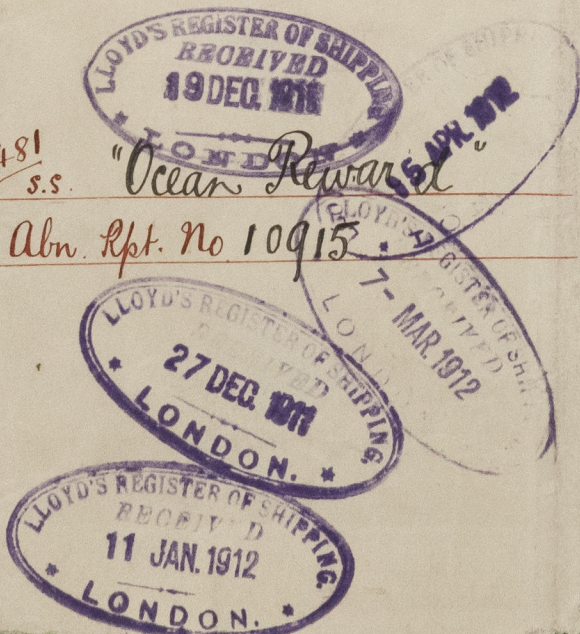

W 1557-0010



© 2021

Lloyd's Register
Foundation