

MIDSHIP SECTION. STEEL SCREW DRIFTER

CLASS 100A1. LLOYDS

DIMENSIONS


LENGTH TWIXT PERPS 86'-0" TRANSVERSE N° (B+D) =
BREADTH MOULDED (B) 18'-6" 18.5+10.0 = 28.50 ✓
DEPTH MOULDED (D) 10'-0" LONGITUDINAL N° (B&D) x L
" TOP OF FLOOR TO BEAM (a) 8'-10" 28.50 x 86 = 2451 ✓
" IN HOLD 9'-3"

$$\frac{L}{B} = 4.6 \checkmark \quad \frac{L}{D} = 8.6 \checkmark$$

EQUIPMENT

✓ 1 ANCHOR EX STOCK 3 1/2 C. 60 FATHOMS 1 1/2" CHAIN (STUD)
✓ 1 ANCHOR D° 3 1/2 C. 60 D° 5 1/2" HAWSER
✓ 1 ANCHOR D° 2 C. 60 D° 3" WARP ✓
1 SMALL KEEL 80 LBS


19.12.11
28.12.11
(481) 11.1.12
14.3.12

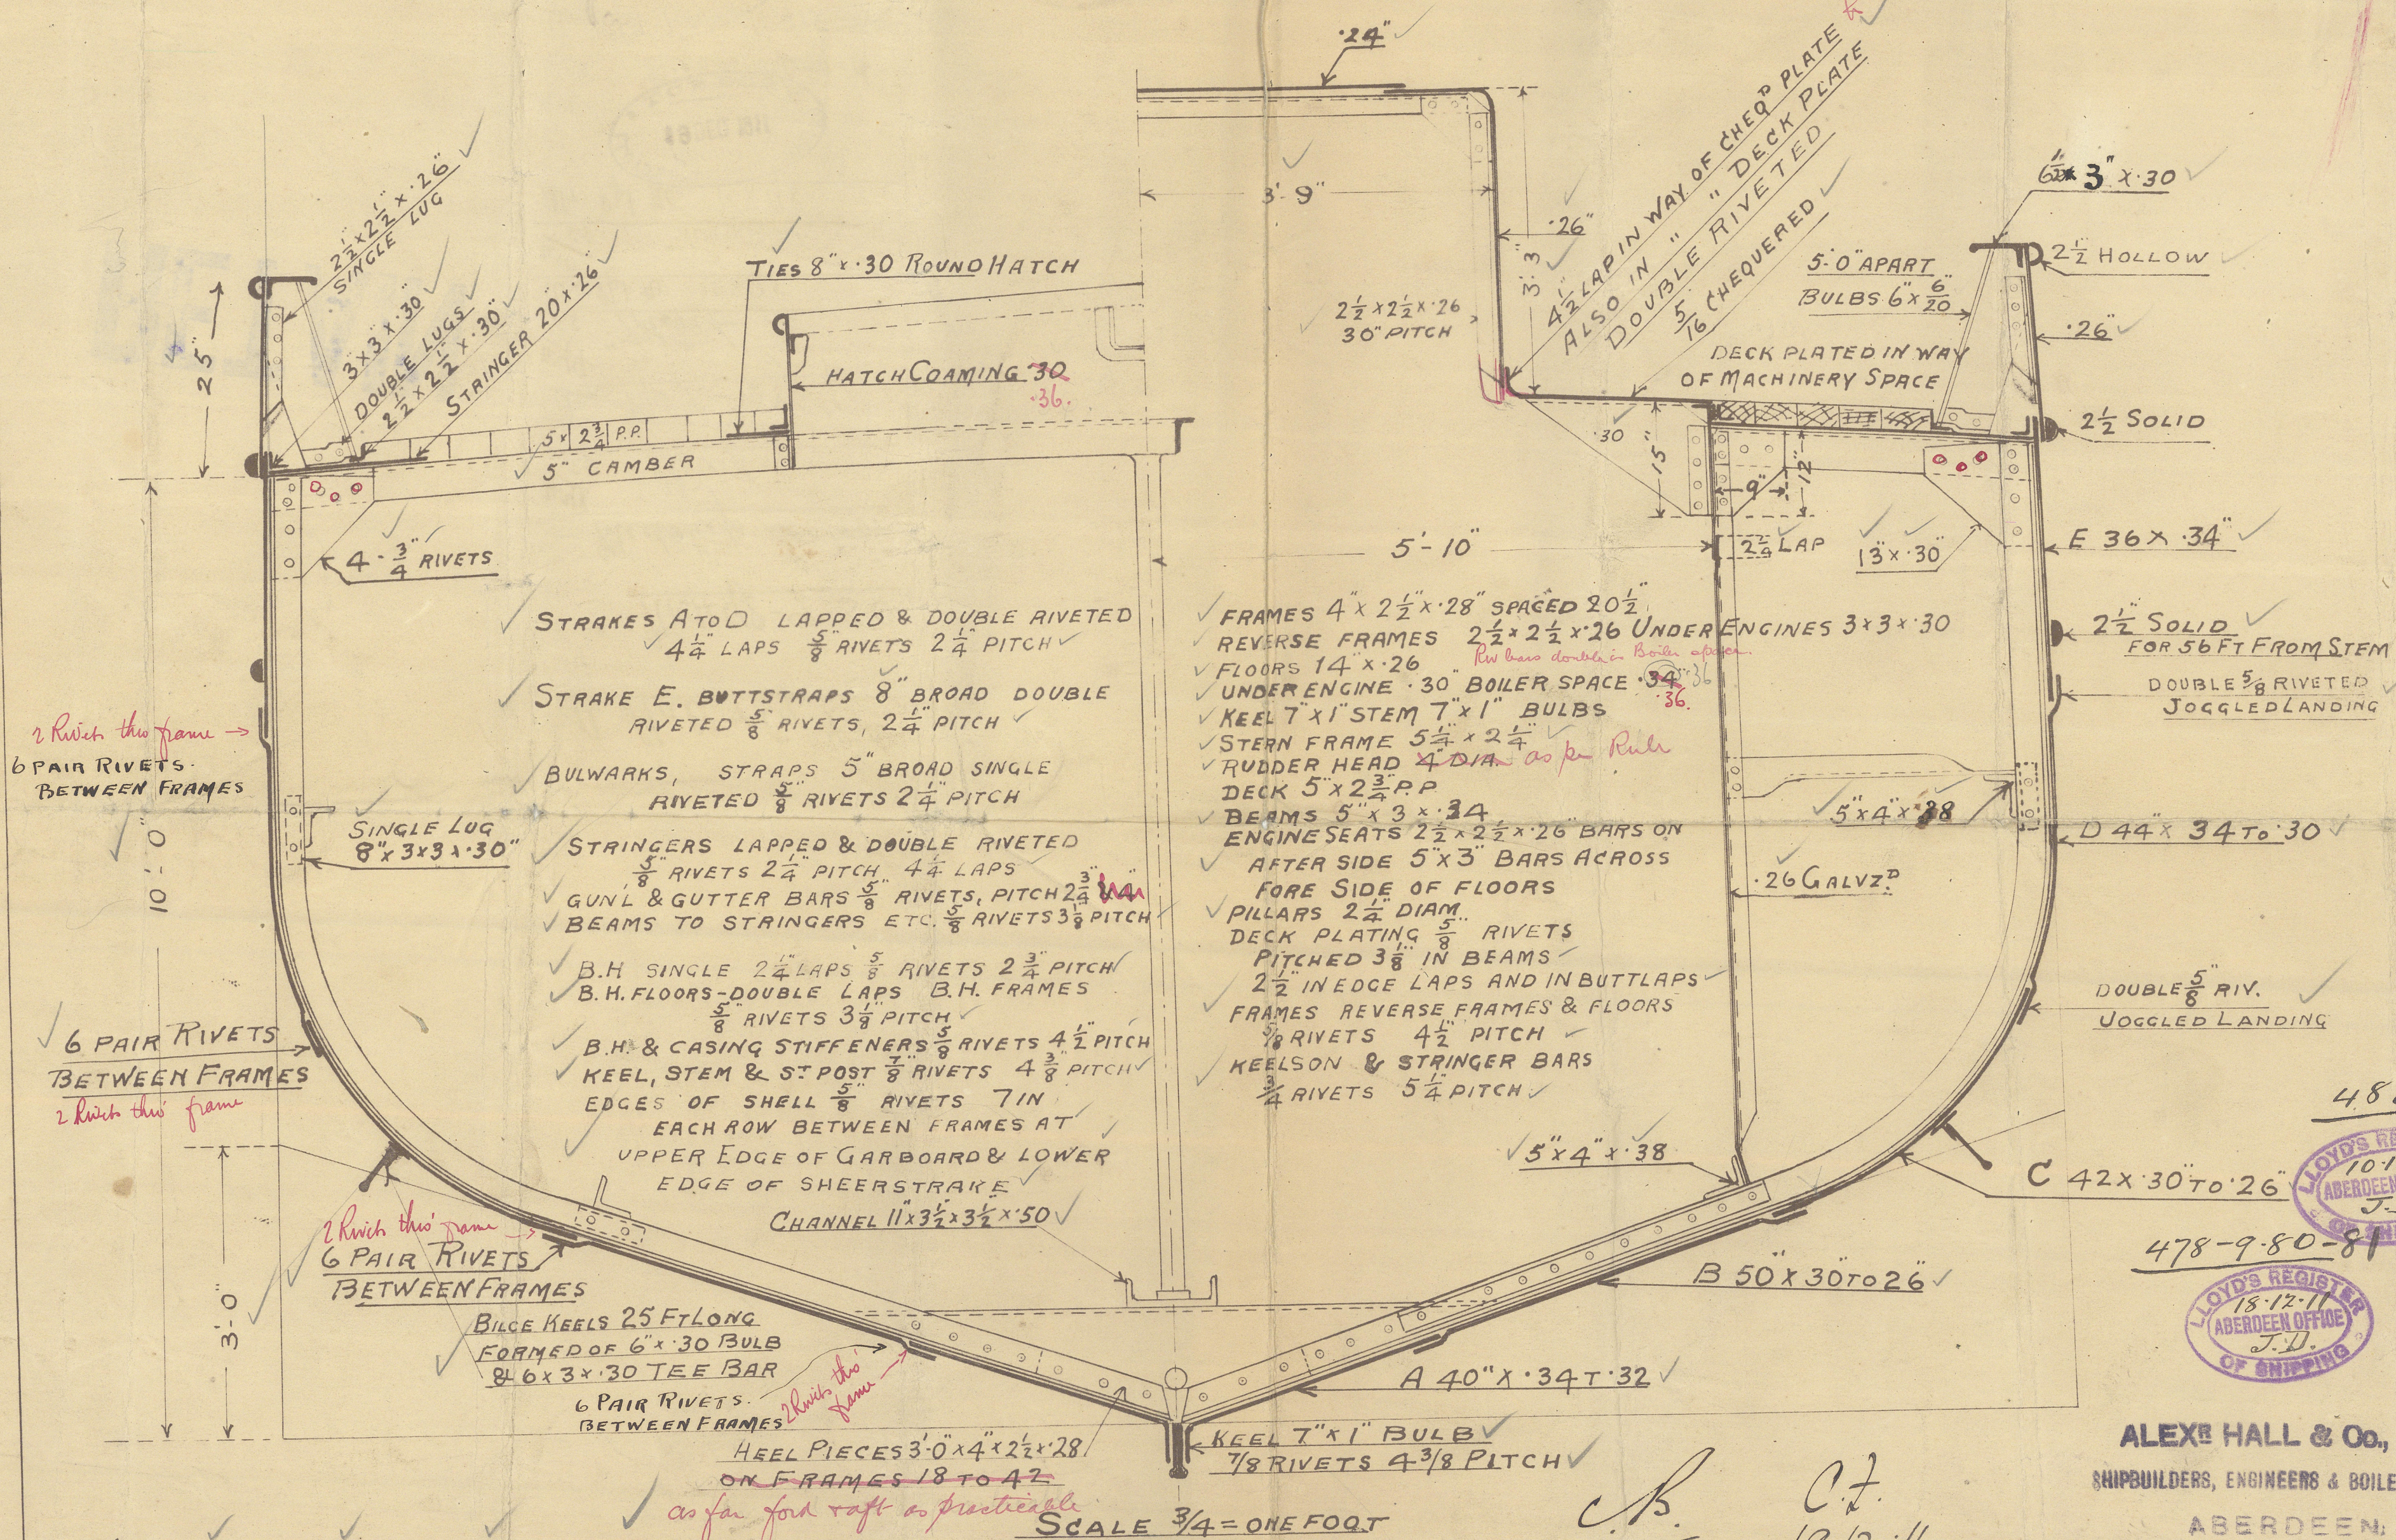

Nos 478-479-480-481.

SCALE 3/4 = ONE FOOT

ALEX. HALL & Co., Ltd.
SHIPBUILDERS, ENGINEERS & BOILERMAKERS
ABERDEEN.

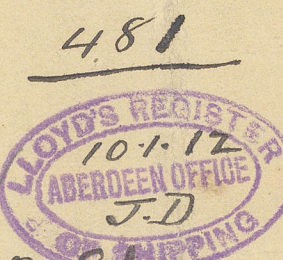

RETAIN

A. Hall & Co. Ld.

Nos 448-9-80-1

- Midship Section

448
S.S. "Plough"

Abn. Rpt. No. 10854.

449
S.S. "Mint"



Abn. Rpt. No. 10895

480
S.S. "Surmount"

Abn. Rpt. No. 10898

481
S.S. "Oceanic Reward"

Abn. Rpt. No. 10915

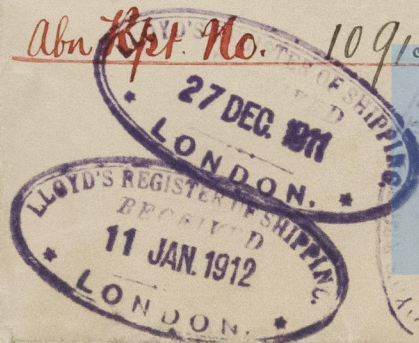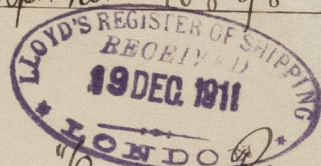

W1557-011

© 2021

Lloyd's Register
Foundation