


U.O.T. = 196

## EQUIPMENT

ANCHOR	5	CWT	EX STOCK.
1 "	4 1/2	"	"
1 "	2 1/2	"	"
90 FATHOMS	1 "	SHORT LINK	CHAIN.
60 "	5 1/2	HAWSER	
60 "	4 "	WARP.	

RISE OF FLOOR 4'-0" plates at E & B

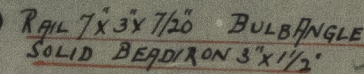

BULWARK 2'-10" ABOVE STRINGER PLATE  
6/20 PLATE

3"x1/2" BEAD IRON RIVETTED TO SHELL  
WITH 3/4" RIVETS ✓  
GUNWALE BAR 3"x3"x7/20  
WATERWAY BAR 3"x3"x2 1/2"x7/20 ✓  
MAIN DECK STRINGER PLATE 24"x7/20 TO 6/20 ✓

SHEER STRAKE 55" x 9/20" x 3/20"  
BUTTS FLUSH STRAPS 9 3/4" WIDE  
DOUBLE RIVETED.

OUTSIDE STRAKE 48" x 7/20 x 6/20  
OVERLAP BUTTS 4 1/4" WIDE  
DOUBLE RIVETED

SIDESTRINGERS  
5x4x8/20

BILBEKEELSON  
5x4x8/20'

ROLLING CROCK  
BULB PLATE 7" x 6" FOR 40'-0"  
5" x 4" FOR DOUBLE ANGLES 7 MIDSHIPS  
INSIDE STRAKE 55" x 7/32 x 6/32  
OVERLAPS BUTTS 1/4" WIDE  
DOUBLE RIVETED

OUTSIDE STRAKE  $48\frac{1}{2} \times 7\frac{1}{2} \times 6\frac{1}{2}$ "  
OVERLAP BUTTS  $4\frac{1}{4}$ " WIDE  
DOUBLE RIVETED

GARBORD 55" x 8 3/16" x 7/16"  
OVER LAP BUTTS 5" WIDE  
DOUBLE RIVETED

KEELBAR  
7 1/2 X 1 7/8 BULB

C.B.  
9.4.03



Newcastle.

Messrs Smith's


Wesport 8725

Midship Section.

Princes Nelson 724

Princes Beatrice 725

46036.

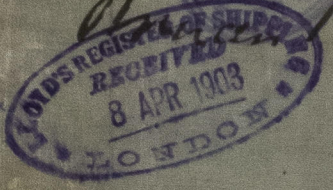

20533.2  
13.812  
24.5  
10.11  
05.50  
14.01

W1557-0161



RETAIN

