

9.4.03


N^o 724-5

ELEVATION

TO CLASS 100 A1. 57 LLOYDS

DIMS 115'-0" BPX 21'-6" EXX 12'-10" MLD.

SCALE 1/4" = ONE FOOT

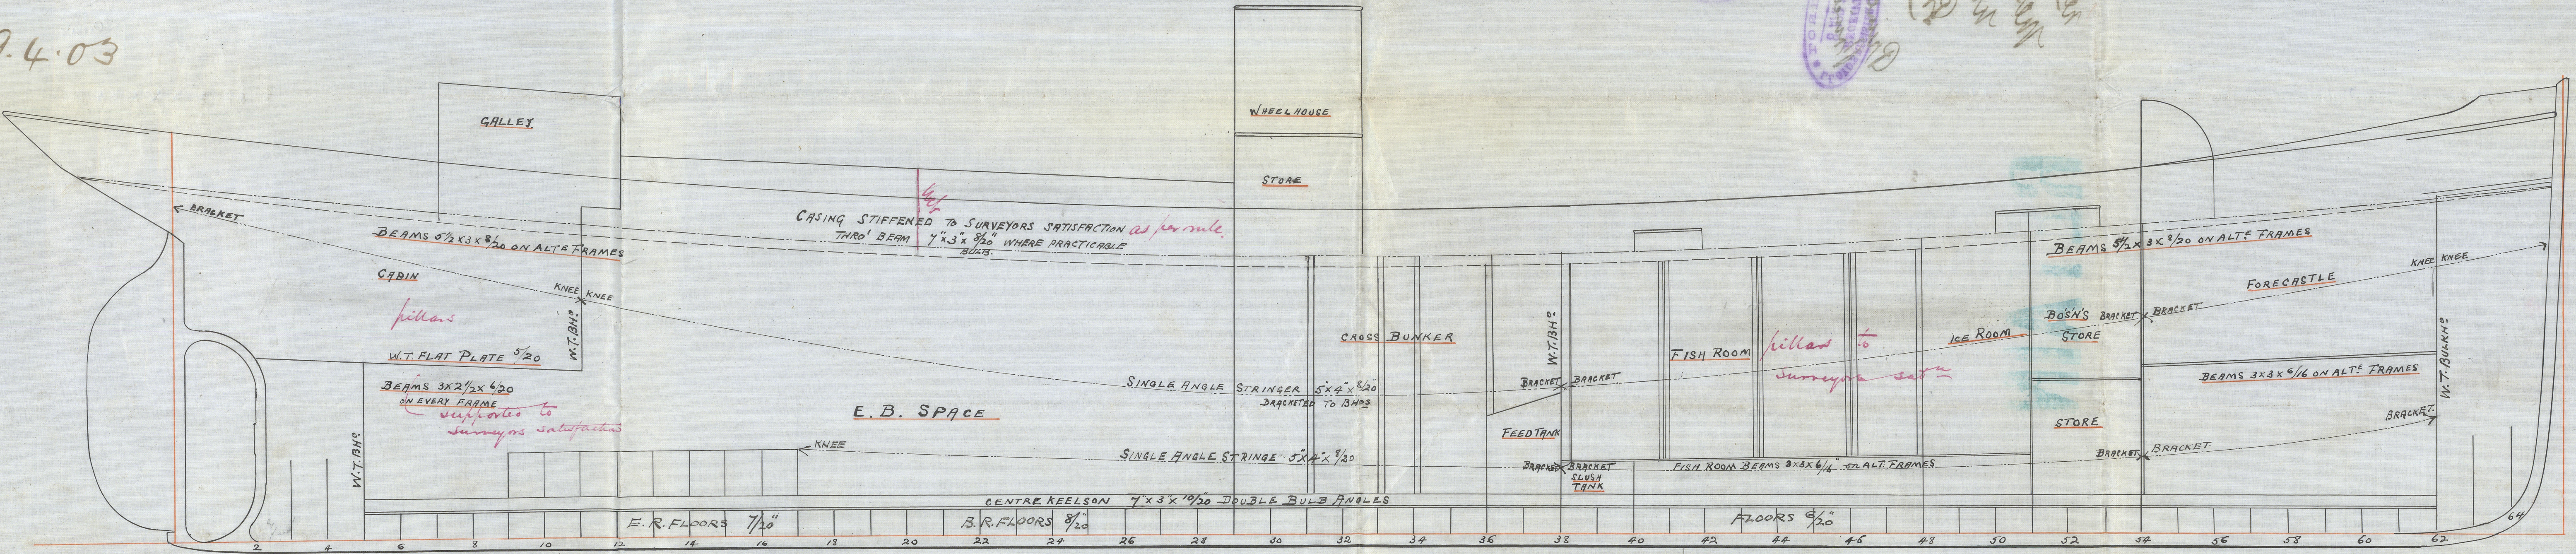

C.B.
9.4.03.

Prince Victoria 724
 Prince Albert 726
 Newcastle N^o 46036

© 2021 Lloyd's Register Foundation
W1557-0162